


U. S. PUBLIC LAND SURVEY MONUMENT RECORD

SECTION 26 T 16 N, — R 7 W, TOWN OF MEDARY  
 LA CROSSE COUNTY

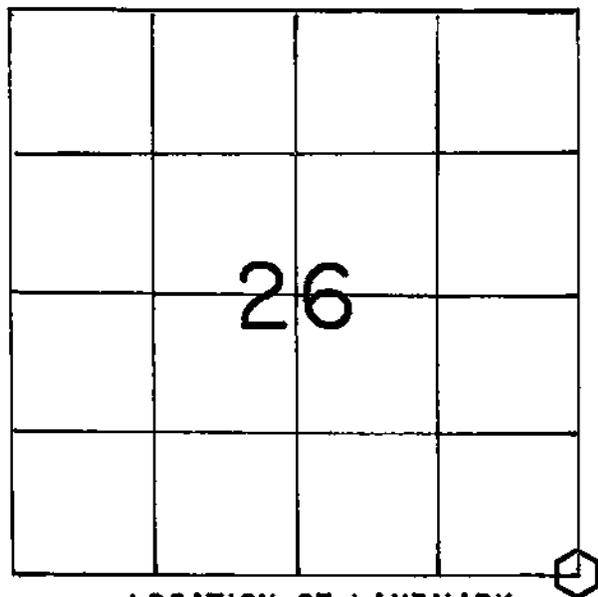

LOCATION OF LANDMARK

WISCONSIN COORDINATE SYSTEM
North
East
Theta Angle
Horiz. Order
Vert. Order
TYPE OF LANDMARK
Set brass cap Lunde marker.
BEARINGS ARE REFERENCED TO
Assumed North.

Crew: WILLIAM C. JUNG  
 PETER F. FOLLANSBEE

Date: 5/12/1994

Describe any record evidence, monument evidence, testimonial evidence or any other material evidence you considered and whether the monument was found or restored through acceptance of an obliterated evidence location.


I found an iron pipe at the corner which had been used in many previous surveys. I accepted this location as the best available evidence of the original government position and replaced the pipe with a brass capped Lunde marker.

Describe or show any material discrepancy between the location of the restored corner and that of the corner previously restored or reestablished.

None Known.


RECORD OF DURABLE WITNESS MONUMENTS

NO	DESCRIPTION	BEARING	DISTANCE
1	3/4" Iron Bar w/cap set by Lampman & Associates	Lampman measur <sup>t</sup> nt N 71° 39' 24" W	190.06 Ft.
2	3/4" Iron Bar as above 3.3' east of fence	Lampman measur <sup>t</sup> nt N 00° 51' 36" W	82.50 Ft.
3	Set P.K. Nail in N.-side 5" Elm(?)	S 69° E (Mag.)	10.92 Ft.
4	Set P.K. Nail in E.-side 4 1/2" Basswood(?)	S 19° W (Mag.)	10.63 Ft.

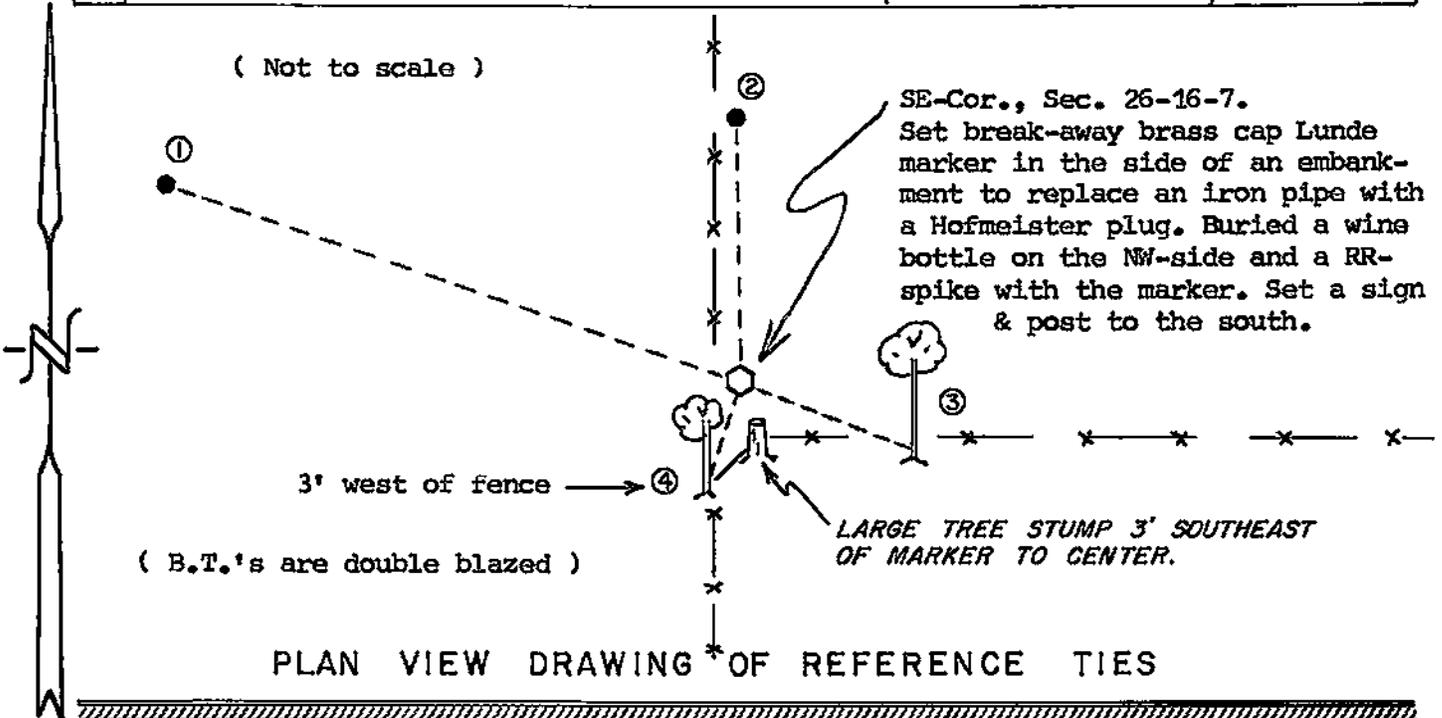

MAP SHOWING DISTANCE AND DIRECTION TO OTHER PUBLIC LAND SURVEY CORNERS USED FOR REESTABLISHING THE CORNER

(not to scale)

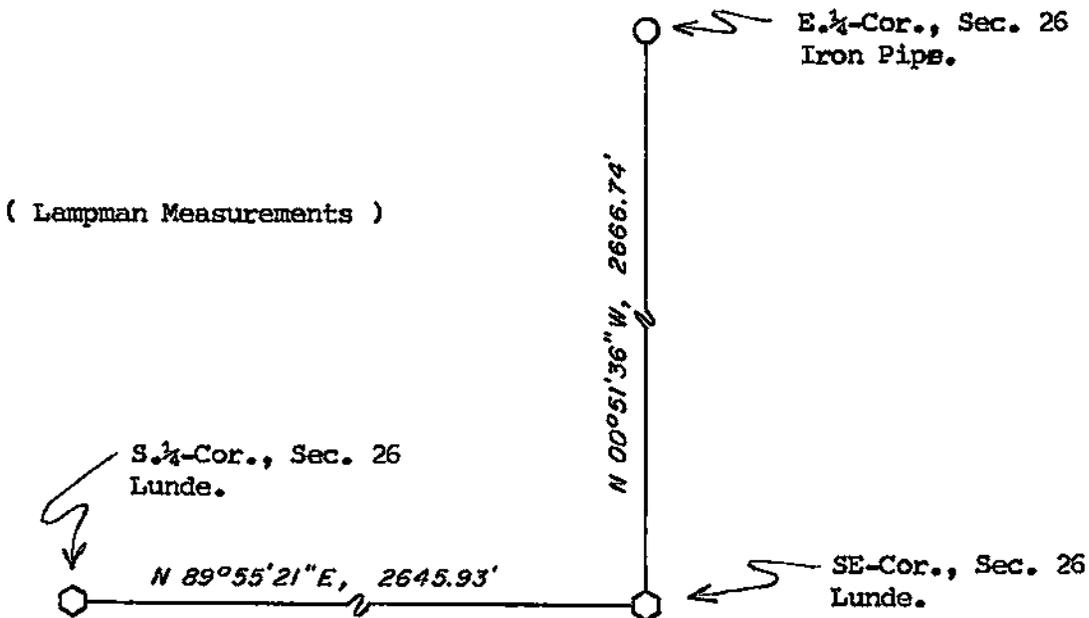

I, William C. Jung, County Surveyor  
 HEREBY CERTIFY THAT THE CORNER LOCATION SHOWN ON THIS RECORD WAS DETERMINED BY ME OR UNDER MY DIRECTION AND CONTROL AND THAT THIS U. S. PUBLIC LAND SURVEY MONUMENT RECORD IS CORRECT AND COMPLETE TO THE BEST OF MY KNOWLEDGE AND BELIEF.

William C. Jung 9/23/94  
 Signature Date



Seal