


U. S. PUBLIC LAND SURVEY MONUMENT RECORD

SECTION 26 T 16 N, R 7 W, TOWN OF MEDARY
 LA CROSSE COUNTY

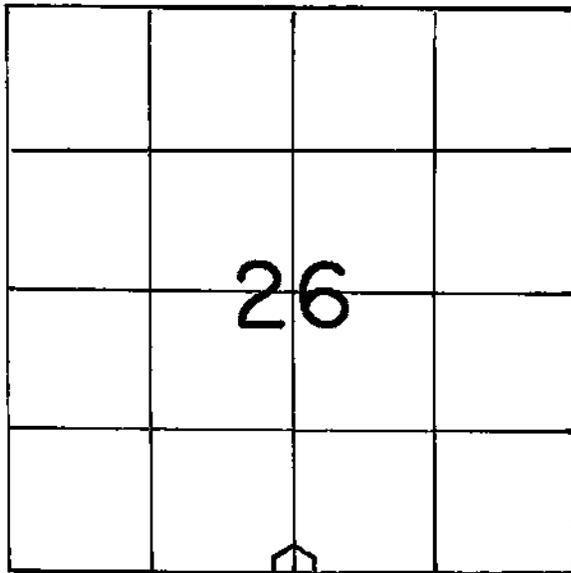

LOCATION OF LANDMARK

WISCONSIN COORDINATE SYSTEM

North

East

Theta Angle

Horiz. Order

Vert. Order

TYPE OF LANDMARK

Brass cap Lunde marker.

BEARINGS ARE REFERENCED TO

Assumed North.

Crew: WILLIAM C. JUNG
 PETER F. FOLLANSBEE

Date: 5/12/1994

Describe any record evidence, monument evidence, testimonial evidence or any other material evidence you considered and whether the monument was found or restored through acceptance of an obliterated evidence location.


Rob Lampman set an iron bar at this corner off of what he believed to be an original bearing tree. He also found what could be a depression from the other bearing tree. I agree with his conclusions. The iron bar was replaced with a brass capped Lunde marker. While digging at the corner Lampman found what appears to be a 1" metal cap that might have been on a wooden staff, such as a Jacob's staff?

Describe or show any material discrepancy between the location of the restored corner and that of the corner previously restored or reestablished.

Bob Chalsma shows this corner in a 1985 survey. I don't know if he set anything as the map has no legend. We found no existing monumentation at this corner. It is hard to say how this final corner fits Chalsma's corner. Lampman and I did not tie into Chalsma's survey as we feel that we have an original bearing tree at the corner.

RECORD OF DURABLE WITNESS MONUMENTS


NO	DESCRIPTION	MAGNETIC	
		BEARING	DISTANCE
1	Ex. Spike in S.-side of 30" White Oak	N 12° W	42.68 Ft.
2	Ex. Spike in SE-side of 8" Hickory	N 53° W	38.44 Ft.
3	Ex. Spike in E.-side of 7" Cherry	N 65° W	23.02 Ft.
4	Ex. Spike in E.-side of double Black Oak	S 81° W	27.58 Ft.

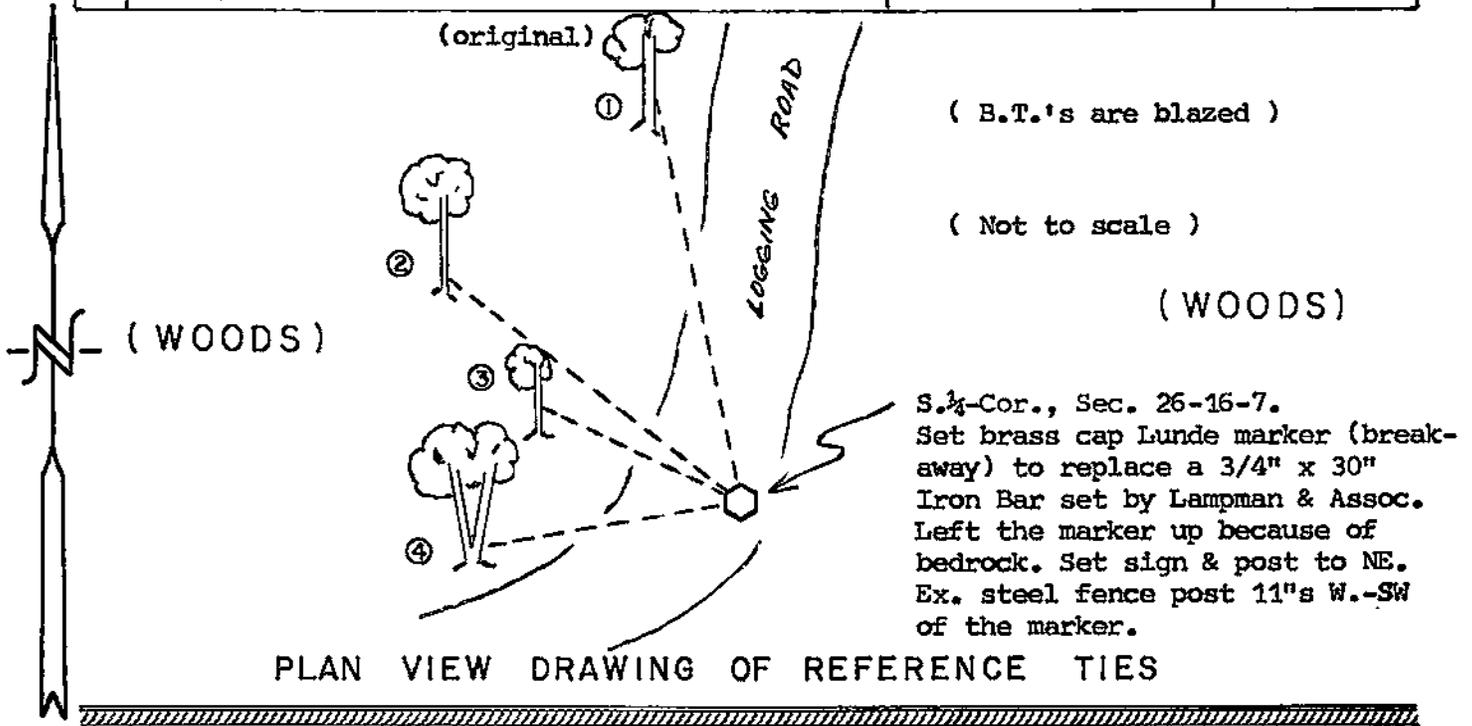

MAP SHOWING DISTANCE AND DIRECTION TO OTHER PUBLIC LAND SURVEY CORNERS USED FOR REESTABLISHING THE CORNER

(not to scale)

(Lampman Measurements)

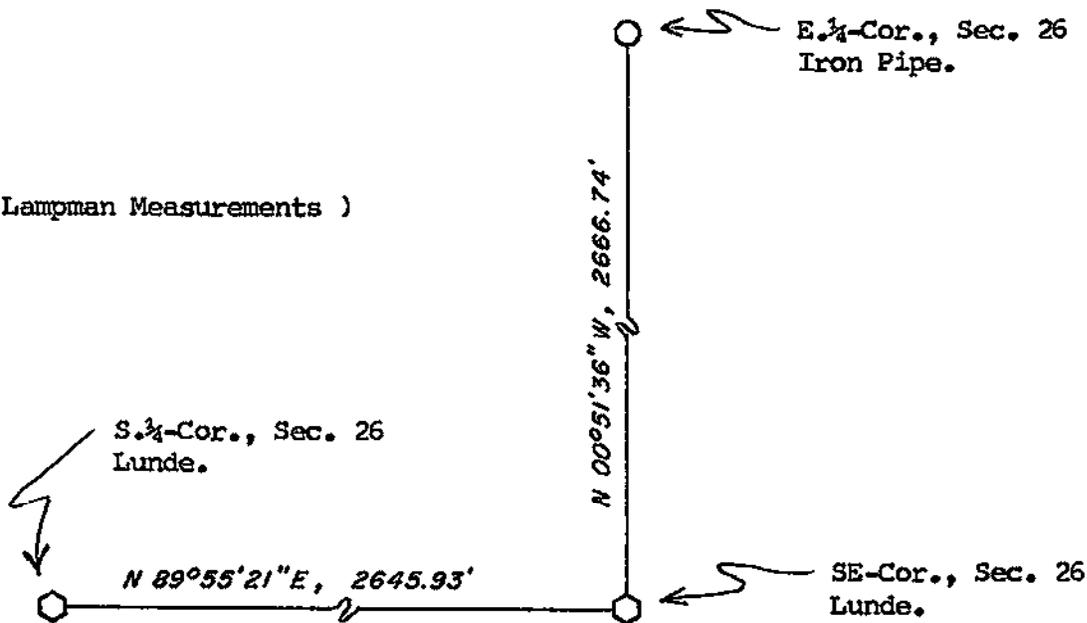

I, William C. Jung, County Surveyor
HEREBY CERTIFY THAT THE CORNER LOCATION SHOWN ON THIS RECORD WAS DETERMINED BY ME OR UNDER MY DIRECTION AND CONTROL AND THAT THIS U. S. PUBLIC LAND SURVEY MONUMENT RECORD IS CORRECT AND COMPLETE TO THE BEST OF MY KNOWLEDGE AND BELIEF.

William C. Jung 9/23/94
Signature Date



Seal