


21607262000

## U. S. PUBLIC LAND SURVEY MONUMENT RECORD

SECTION 26 T 16 N, R 7 W, TOWN OF MEDARY

LA CROSSE COUNTY

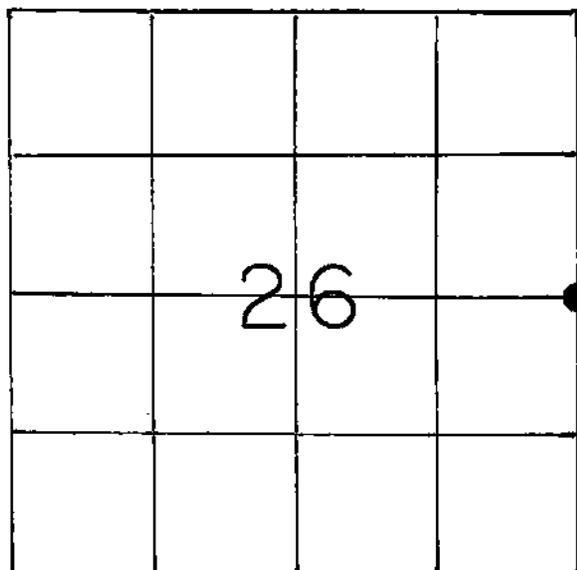

LOCATION OF LANDMARK

## WISCONSIN COORDINATE SYSTEM

North

East

Theta Angle

N/A

Horiz. Order

Vert. Order

## TYPE OF LANDMARK

1" IRON PIPE

BEARINGS ARE REFERENCED TO

C.S.M. VOL. 4 P. 94

Describe any record evidence, monument evidence, testimonial evidence or any other material evidence you considered and whether the monument was found or restored through acceptance of an obliterated evidence location.


A fence corner exists where the pipe was set. This location was referred to on Certified Survey Map in Volume 4, page 94. The line between the East & West corner 1/4 coincides and checks out well with data shown on a survey done by Bob Chalsma on the other side of the section.

Describe or show any material discrepancy between the location of the restored corner and that of the corner previously restored or reestablished.

Survey by Joe Murphy for Erhardt Oertel property on July 15, 1972 indicates stone monument found 1004.10 feet from centerline of Smith Valley Road. Neither I or Willbur Clark could find and identify this stone. A stone resembling this description was found in the location shown on the plan view. The stone was found laying down and had no definite marks distinguishing it as a corner marker. It was brought back to the office for further analysis but revealed nothing and remains here. The distance from the centerline of Smith Valley Road to the iron pipe set is 994.75. A 30" Burr Oak shown on the plan view could not be determined to be a bearing tree.


RECORD OF DURABLE WITNESS MONUMENTS

NO	DESCRIPTION	BEARING	DISTANCE
1	SPIKE IN 13" HICKORY	N 36° W ±	15.3'
2	SPIKE IN 11" HICKORY	N 72° E ±	10.3'
3	SPIKE IN 12" HICKORY	S 62° W ±	12.25'
4	R.R. SPIKE IN PLACE OF STONE (See narrative)	S 82° W ±	9.1'

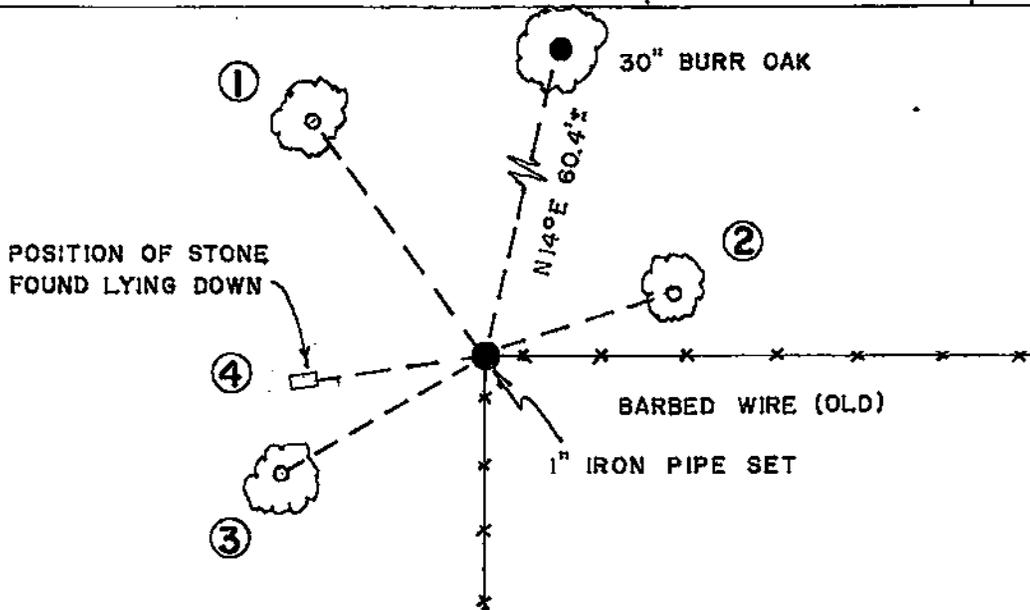

PLAN VIEW DRAWING OF REFERENCE TIES


MAP SHOWING DISTANCE AND DIRECTION TO OTHER PUBLIC LAND SURVEY CORNERS USED FOR REESTABLISHING THE CORNER

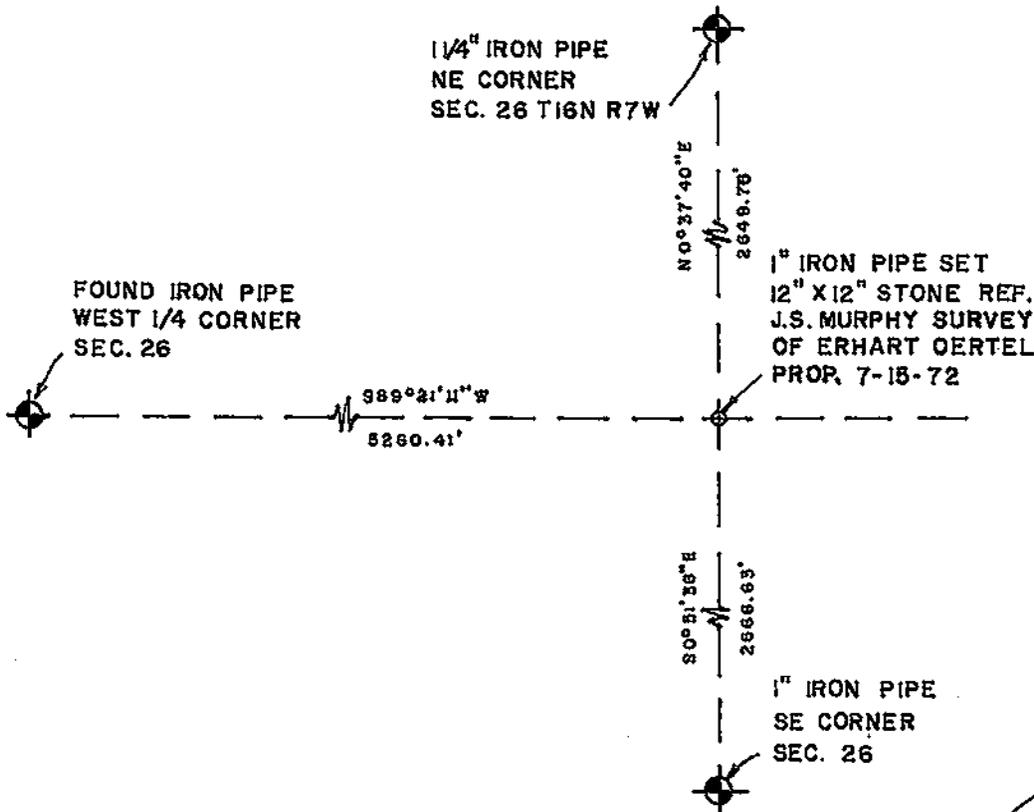

I, RODNEY H. MAXWELL, R.L.S. 1826,  
 HEREBY CERTIFY THAT THE CORNER LOCATION SHOWN ON THIS RECORD  
 WAS DETERMINED BY ME OR UNDER MY DIRECTION AND CONTROL AND  
 THAT THIS U. S. PUBLIC LAND SURVEY MONUMENT RECORD IS CORRECT  
 AND COMPLETE TO THE BEST OF MY KNOWLEDGE AND BELIEF.

Rodney H. Maxwell  
 Signature

12/11/89  
 Date

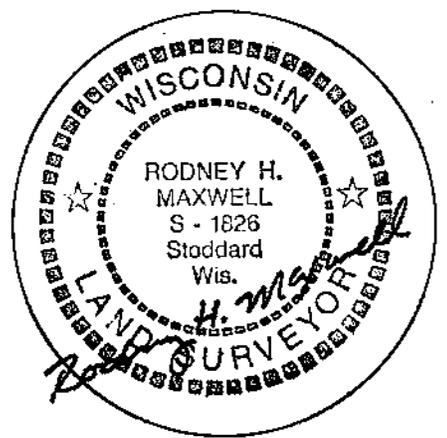

Seal