


U. S. PUBLIC LAND SURVEY MONUMENT RECORD

SECTION 35 T 16 N, R 7 W, TOWN OF MEDARY  
 LA CROSSE COUNTY

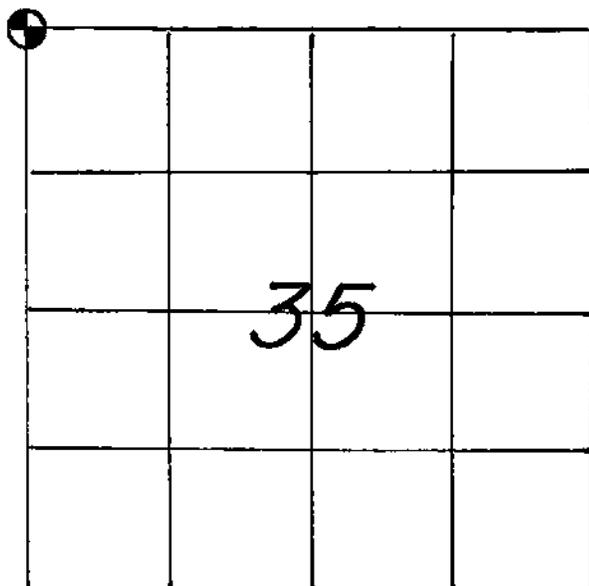

LOCATION OF LANDMARK

WISCONSIN COORDINATE SYSTEM
North
East
Theta Angle
Horiz. Order
Vert. Order
TYPE OF LANDMARK <u>3/4" Bar w/Cap</u> <del>Top of steel fencepost.</del>
BEARINGS ARE REFERENCED TO

Crew: WILLIAM C. JUNG  
 PETER F. FOLLANSBEE  
 Date: 1/10/1996

Crew: William C. Jung  
 Peter Follansbee  
 Date: 7/5/02 \*\*\*\*\*

Describe any record evidence, monument evidence, testimonial evidence or any other material evidence you considered and whether the monument was found or restored through acceptance of an obliterated evidence location.

I found a bent iron pipe at the corner. This had been used as the corner in previous surveys. I accepted this pipe as the best available evidence of the original government corner position. I drove a steel fence post in at the corner location. The post is the corner, with the bent pipe to the North of it.

\*\*\*\*\* 7/5/02 Set a 3/4"x30" round iron bar with a Berntsen cap at the corner.

Describe or show any material discrepancy between the location of the restored corner and that of the corner previously restored or reestablished.

None Known.


(This tree is standing but is "dead" due to storm damage.)

RECORD OF DURABLE WITNESS MONUMENTS  
MAGNETIC

NO	DESCRIPTION	BEARING	DISTANCE
1	Set P.K. Nail in SW-side 14½" Hickory	N 15° W	17.52 Ft.
2	Set P.K. Nail in N.-side 21" Oak	S 88° W	35.71 Ft.
3	Set P.K. Nail in SW-side 16" Oak	S 51° E	47.29 Ft.
4	Distance to center of unblazed 5½" elm w/sign	S 70° E	8.5 Ft.

( Note: the Bearing Trees are double blazed unless noted. )

( Scale: 1" = 20' )

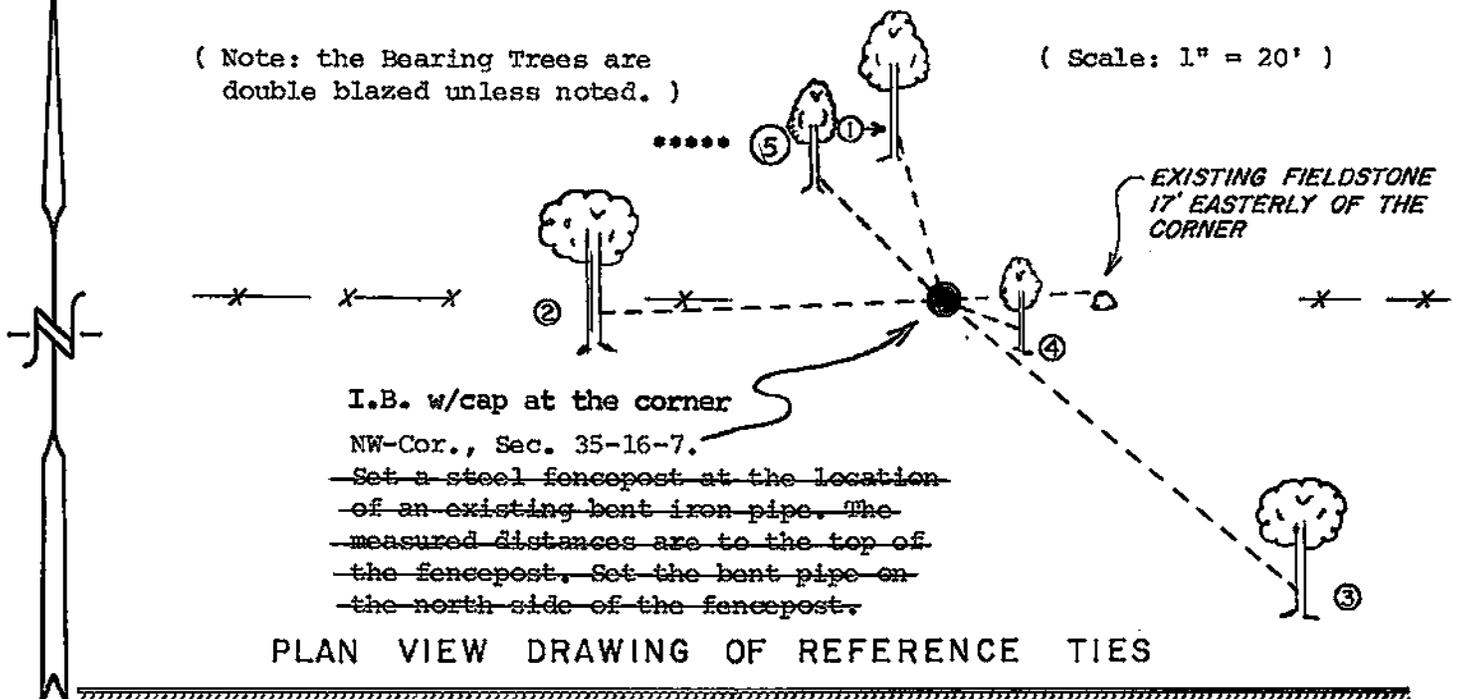

I.B. w/cap at the corner  
NW-Cor., Sec. 35-16-7.  
~~Set a steel fencepost at the location of an existing bent iron pipe. The measured distances are to the top of the fencepost. Set the bent pipe on the north side of the fencepost.~~

PLAN VIEW DRAWING OF REFERENCE TIES

MAP SHOWING DISTANCE AND DIRECTION TO OTHER PUBLIC LAND SURVEY CORNERS USED FOR REESTABLISHING THE CORNER

I made no section measurements at this time. This location had been confirmed through previous survey work.


\*\*\*\*\* Set a nail on the Southwest side of a 9½" hickory, N45°W, 17.70 ft. from the corner.  
⑤

I, William C. Jung, County Surveyor  
HEREBY CERTIFY THAT THE CORNER LOCATION SHOWN ON THIS RECORD WAS DETERMINED BY ME OR UNDER MY DIRECTION AND CONTROL AND THAT THIS U. S. PUBLIC LAND SURVEY MONUMENT RECORD IS CORRECT AND COMPLETE TO THE BEST OF MY KNOWLEDGE AND BELIEF.

William C. Jung  
Signature

1/11/96  
Date

Revised: 7/8/02 *wey*

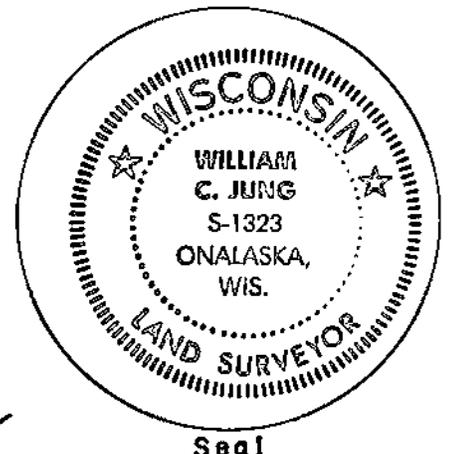

Seal