


21607270020

## U. S. PUBLIC LAND SURVEY MONUMENT RECORD

SECTION 27 T 16 N, R 7 W, TOWN OF MEDARY

LA CROSSE COUNTY

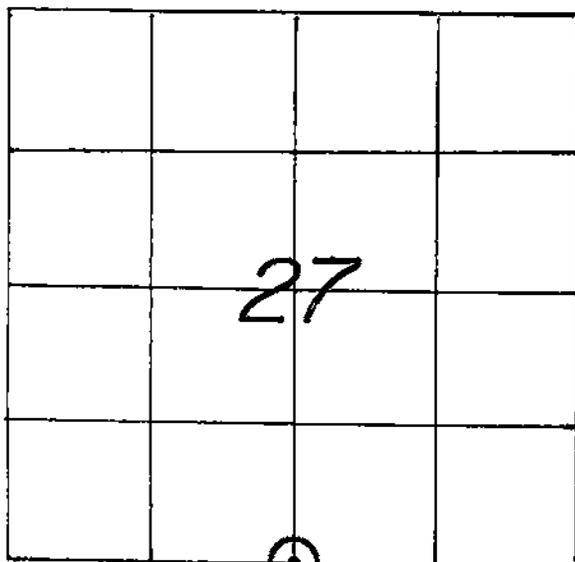

LOCATION OF LANDMARK

CREW: WILLIAM C. JUNG  
 PETER F. FOLLANSBEE  
 DATE: 3/29/2005

WISCONSIN COORDINATE SYSTEM	
North	667,909.002
East	1,651,924.012
Theta Angle	
Horiz. Order	
Vert. Order	
DATUM:	1983('91)
TYPE OF LANDMARK	
IRON BAR WITH PLASTIC CAP INSIDE IRON PIPE.	
BEARINGS ARE REFERENCED TO	

Describe any record evidence, monument evidence, testimonial evidence or any other material evidence you considered and whether the monument was found or restored through acceptance of an obliterated evidence location.

An iron pipe at this corner had been used as the corner in numerous previous surveys. I accepted this pipe as the best available evidence of the original government corner position. I set an iron bar with a cap inside of the existing iron pipe.

Describe or show any material discrepancy between the location of the restored corner and that of the corner previously restored or reestablished.

**NONE KNOWN.**

