


21607272000

U. S. PUBLIC LAND SURVEY MONUMENT RECORD

SECTION 26 T 16 N, R 7 W, TOWN OF MEDARY

LA CROSSE COUNTY

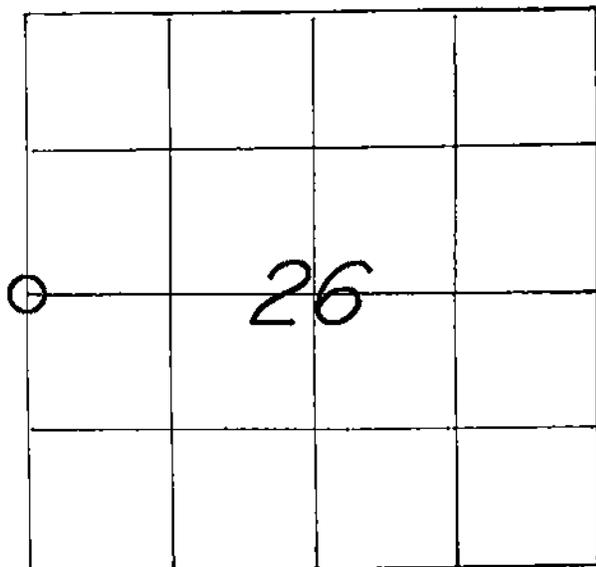

LOCATION OF LANDMARK

CREW: WILLIAM C. JUNG
 PETER F. FOLLANSBEE
 DATE: 8/26/1998

WISCONSIN COORDINATE SYSTEM

North

East

Theta Angle

Horiz. Order

Vert. Order

TYPE OF LANDMARK

EXISTING 1" IRON PIPE

BEARINGS ARE REFERENCED TO

Describe any record evidence, monument evidence, testimonial evidence or any other material evidence you considered and whether the monument was found or restored through acceptance of an obliterated evidence location.

Greg Hofmeister set an iron pipe at this corner off of what he believed to be an original bearing tree. I agree that the tree is an original and accepted Greg's pipe. Maxwell and Hurlburt used this pipe in later surveys.


Describe or show any material discrepancy between the location of the restored corner and that of the corner previously restored or reestablished.

NONE KNOWN.

RECORD OF DURABLE WITNESS MONUMENTS

MAGNETIC

NO	DESCRIPTION	BEARING	DISTANCE
1	SET A NAIL IN THE S.-SIDE OF A 16-1/2" HICKORY	WEST ±	18.50 FT.
2	SET A NAIL IN THE N.E.-SIDE OF A 9" HICKORY	N 55° W	38.25 FT.
3	SET A NAIL IN THE N.E.-SIDE OF A 4-1/2" HICKORY	N 22° W	20.62 FT.
4	SET A NAIL IN THE S.E.-SIDE OF A 33" WHITE OAK	N 33° E	11.63 FT.

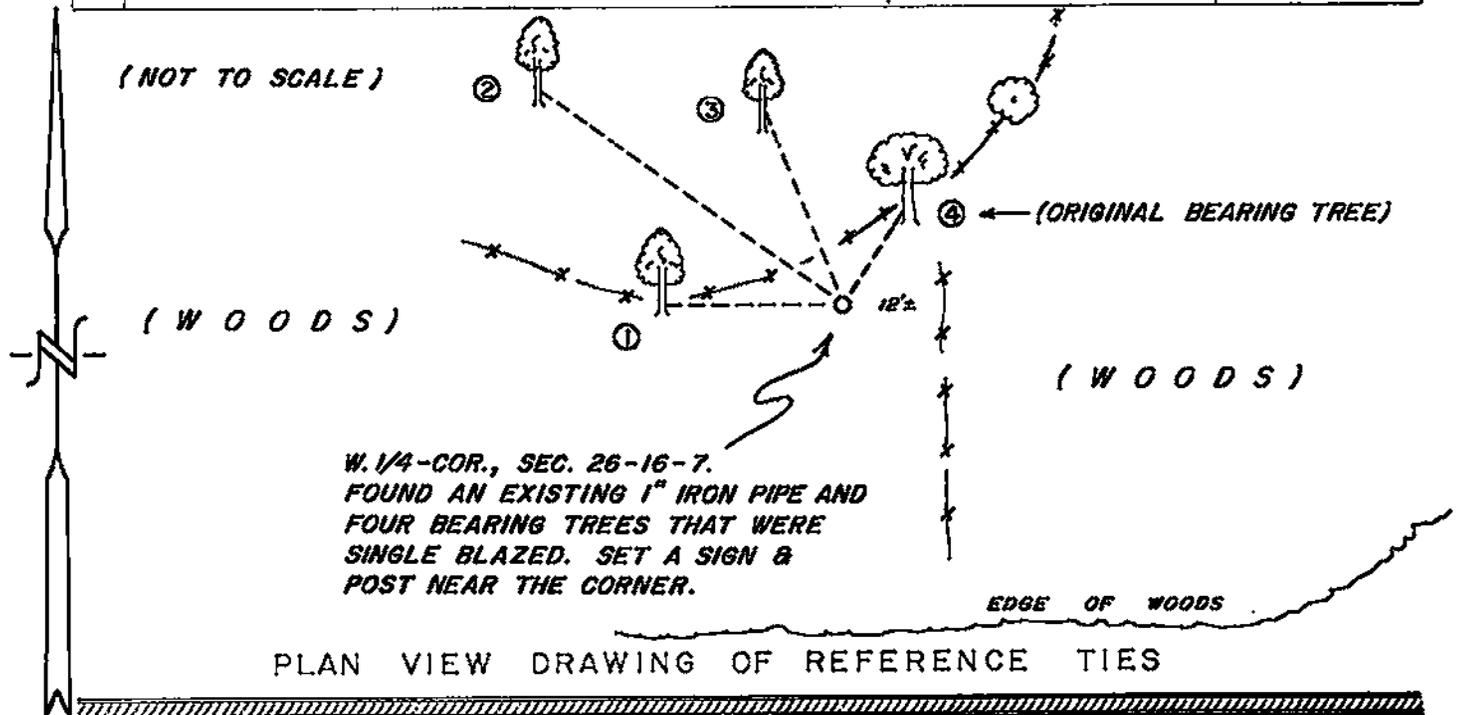


MAP SHOWING DISTANCE AND DIRECTION TO OTHER PUBLIC LAND SURVEY CORNERS USED FOR REESTABLISHING THE CORNER

No section measurements were made by me at this time. The position of this corner was confirmed through the section work of others.

I, WILLIAM C. JUNG, COUNTY SURVEYOR
 HEREBY CERTIFY THAT THE CORNER LOCATION SHOWN ON THIS RECORD WAS DETERMINED BY ME OR UNDER MY DIRECTION AND CONTROL AND THAT THIS U. S. PUBLIC LAND SURVEY MONUMENT RECORD IS CORRECT AND COMPLETE TO THE BEST OF MY KNOWLEDGE AND BELIEF.

William C. Jung October 27, 1998
 Signature Date

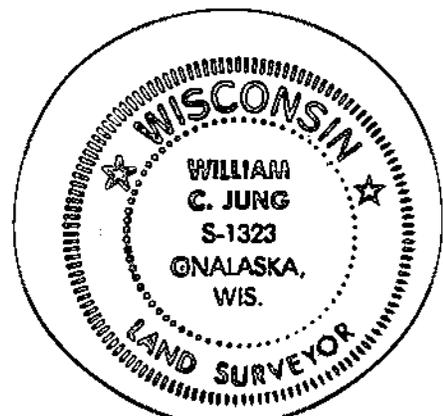

Seal