


21607280000

## U. S. PUBLIC LAND SURVEY MONUMENT RECORD

SECTION 33 T 16 N, R 7 W, TOWN OF Medary

LA CROSSE COUNTY

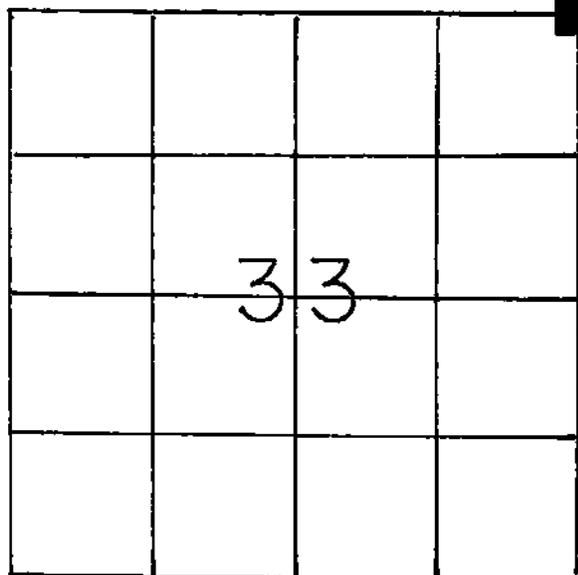

LOCATION OF LANDMARK

## WISCONSIN COORDINATE SYSTEM

North

East

Theta Angle

Horiz. Order

Vert. Order

## TYPE OF LANDMARK

Existing stone

## BEARINGS ARE REFERENCED TO

Crew: William C. Jung  
Peter F. Follansbee

Date: March 21, 1990

Describe any record evidence, monument evidence, testimonial evidence or any other material evidence you considered and whether the monument was found or restored through acceptance of an obliterated evidence location.


We found a stone at the corner. The stone had been found and used by Chalsma in previous survey work. It measures 4"x6", is up 2.5', and leans Northeast. It also has a chiselled cross. The stone is on the South side of a draw "deep in the woods".

Describe or show any material discrepancy between the location of the restored corner and that of the corner previously restored or reestablished.

None known.

RECORD OF DURABLE WITNESS MONUMENTS  
Magnetic

NO	DESCRIPTION	BEARING	DISTANCE
1	P.K. nail in single blazed 12" black oak	S2°E	slope=23.82
2	" 14" "	S80°W	" =30.71
3	" 21" "	N11°E	" =41.15
4	Set P.K. nail in ex. blaze on 29" cottonwood	-----	1.77

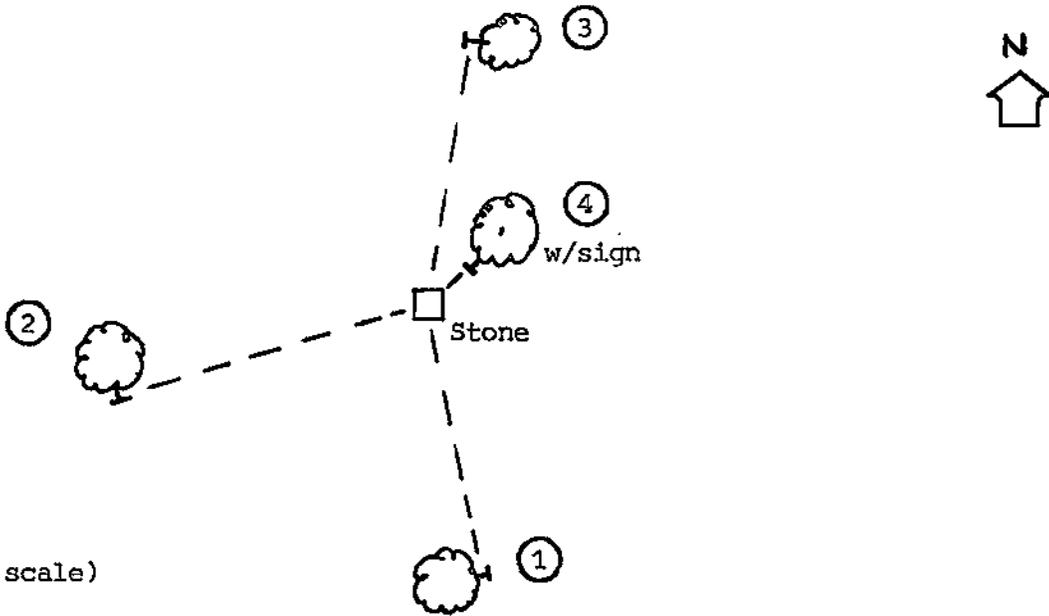

PLAN VIEW DRAWING OF REFERENCE TIES


MAP SHOWING DISTANCE AND DIRECTION TO OTHER PUBLIC LAND SURVEY CORNERS USED FOR REESTABLISHING THE CORNER

No section measurements made by me at this time.

I, William C. Jung, Deputy County Surveyor,  
HEREBY CERTIFY THAT THE CORNER LOCATION SHOWN ON THIS RECORD  
WAS DETERMINED BY ME OR UNDER MY DIRECTION AND CONTROL AND  
THAT THIS U. S. PUBLIC LAND SURVEY MONUMENT RECORD IS CORRECT  
AND COMPLETE TO THE BEST OF MY KNOWLEDGE AND BELIEF.

William C. Jung  
Signature

February 12, 1991  
Date

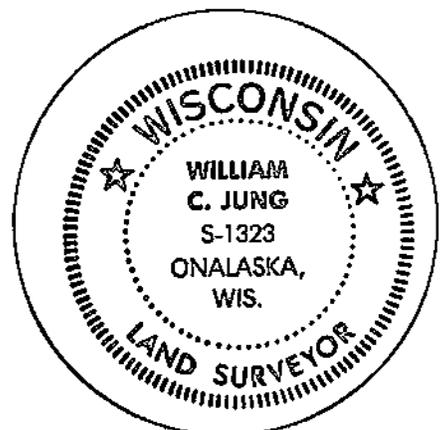

Seal