


21607282000

U. S. PUBLIC LAND SURVEY MONUMENT RECORD

SECTION 28 T 16 N, R 7 W, TOWN OF MEDARY

LA CROSSE COUNTY

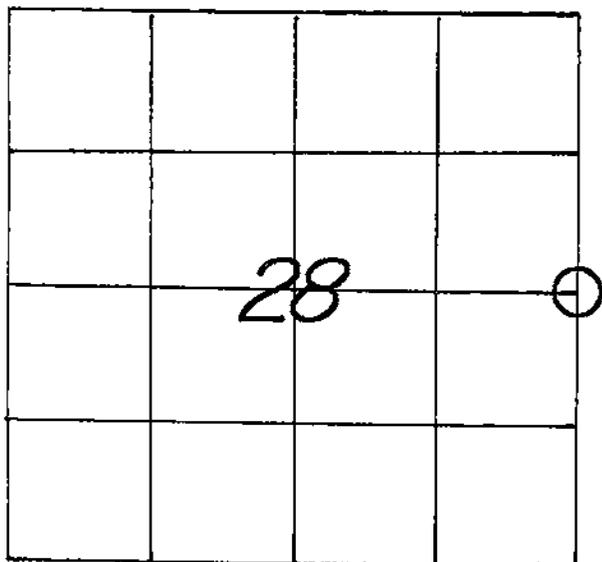

WISCONSIN COORDINATE SYSTEM

North

East

Theta Angle

Horiz. Order

Vert. Order

TYPE OF LANDMARK

1" IRON PIPE.

BEARINGS ARE REFERENCED TO

LOCATION OF LANDMARK

CREW: WILLIAM C. JUNG
 PETER F. FOLLANSBEE
 DATE: 4/05/2005

Describe any record evidence, monument evidence, testimonial evidence or any other material evidence you considered and whether the monument was found or restored through acceptance of an obliterated evidence location.

We found an iron pipe at the corner that had been used as the corner in numerous previous surveys. I accepted this pipe as the best available evidence of the original government corner position.

Describe or show any material discrepancy between the location of the restored corner and that of the corner previously restored or reestablished.


NONE KNOWN.

RECORD OF DURABLE WITNESS MONUMENTS


NO	DESCRIPTION	MAGNETIC BEARING	DISTANCE
1	SET A NAIL IN N.W.-SIDE OF A 7-1/2" CEDAR	S 41° W	21.43 FT.
2	SET A NAIL IN S.W.-SIDE OF A 10" BIRCH	N 79° W	15.53 FT.
3	SET A NAIL IN S.E.-SIDE OF A 32" OAK	N 60° E	20.16 FT.
4	SET A NAIL IN S.E.-SIDE OF A 21" WHITE OAK	N 85° E	SLOPE = 60.60'

(NOTE: BEARING TREES 1 AND 2 ARE DOUBLE BLAZED, No. 3 IS UNBLAZED WHILE No. 4 HAS AN EXISTING SINGLE BLAZE.)

(NOT TO SCALE)

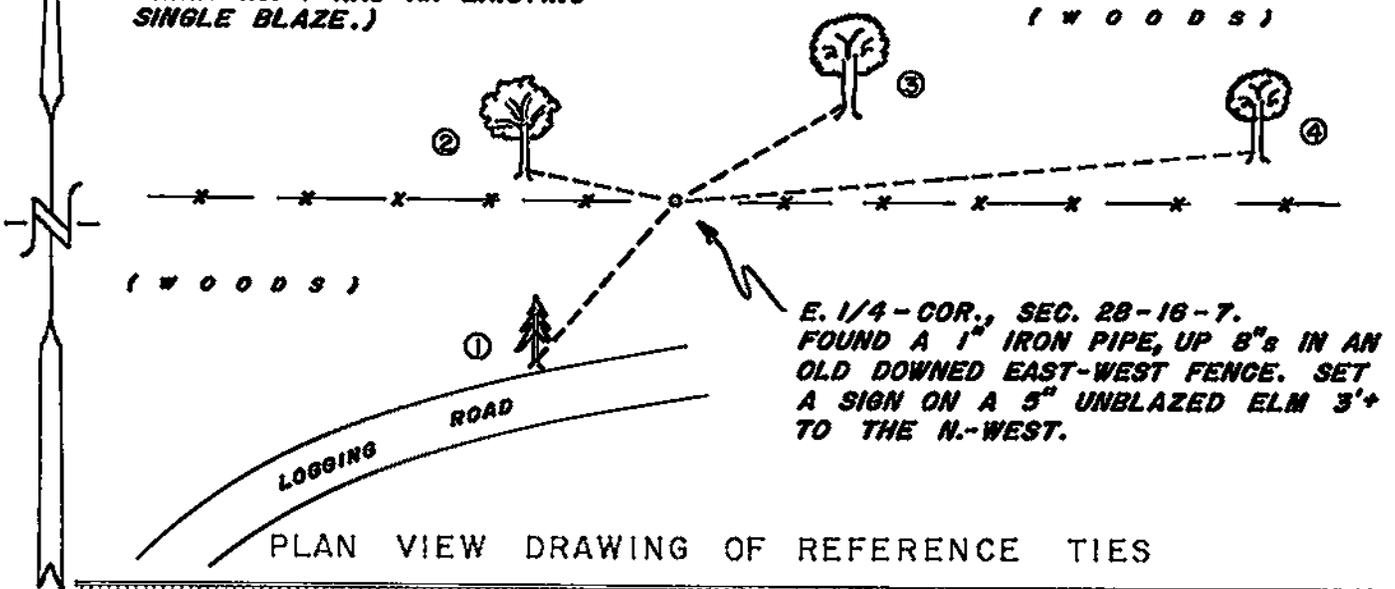


MAP SHOWING DISTANCE AND DIRECTION TO OTHER PUBLIC LAND SURVEY CORNERS USED FOR REESTABLISHING THE CORNER

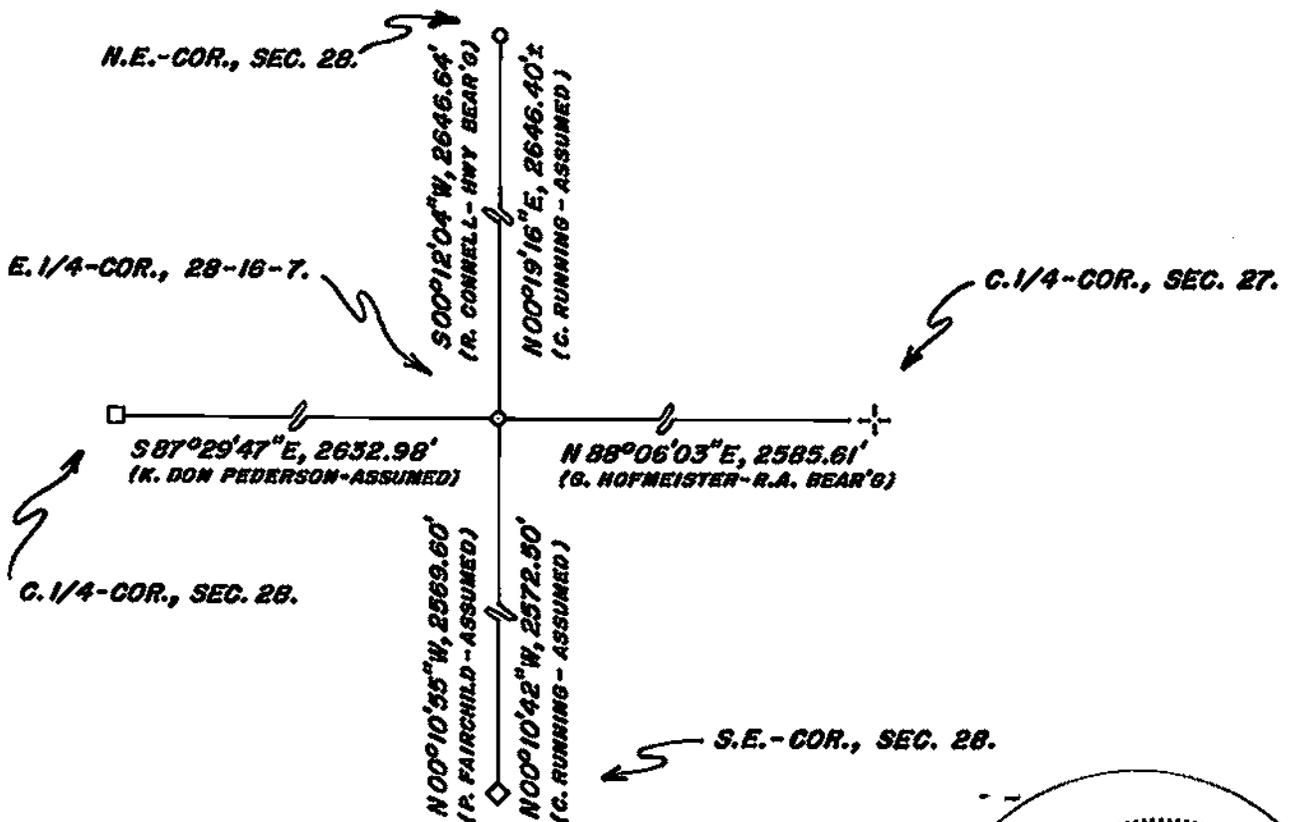

I, WILLIAM G. JUNG, COUNTY SURVEYOR
HEREBY CERTIFY THAT THE CORNER LOCATION SHOWN ON THIS RECORD WAS DETERMINED BY ME OR UNDER MY DIRECTION AND CONTROL AND THAT THIS U. S. PUBLIC LAND SURVEY MONUMENT RECORD IS CORRECT AND COMPLETE TO THE BEST OF MY KNOWLEDGE AND BELIEF.

William C. Jung 6/30/05
Signature Date

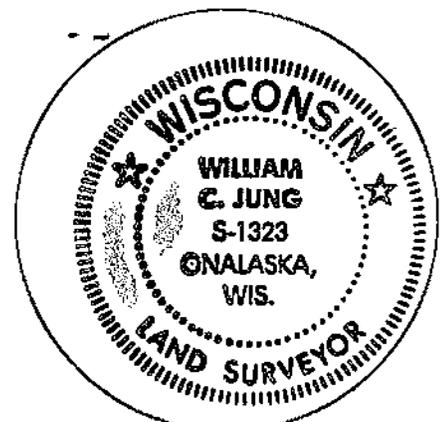

Seal