


21607290000

U. S. PUBLIC LAND SURVEY MONUMENT RECORD

SECTION 32 T 16 N, R 7 W, ~~TOWN~~ OF CITY OF LA CROSSE
 LA CROSSE COUNTY

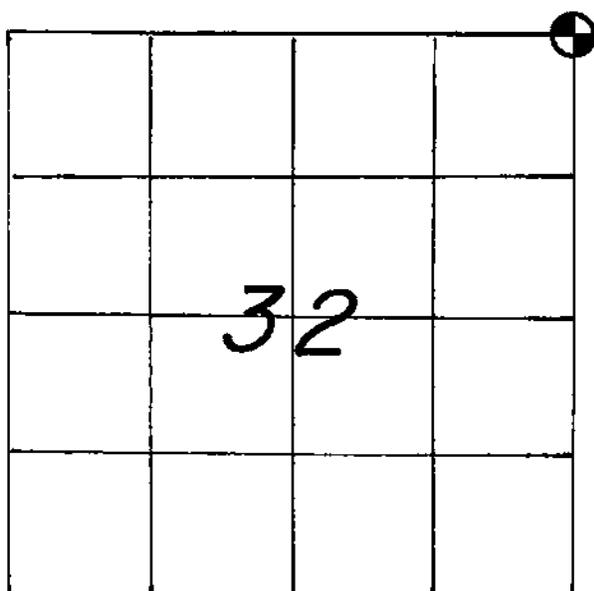

LOCATION OF LANDMARK

WISCONSIN COORDINATE SYSTEM
North
East
Theta Angle
Horiz. Order
Vert. Order
TYPE OF LANDMARK
1" x 24" IRON PIPE.
BEARINGS ARE REFERENCED TO

Crew: WILLIAM C. JUNG
 PETER F. FOLLANSBEE
 Date: 8/07/1995

Describe any record evidence, monument evidence, testimonial evidence or any other material evidence you considered and whether the monument was found or restored through acceptance of an obliterated evidence location.

Bill Woodman set a nail at this corner after doing a great deal of section work. I removed his nail and set an iron pipe in the tree roots. I could find no evidence of the old corner.

Describe or show any material discrepancy between the location of the restored corner and that of the corner previously restored or reestablished.

None Known.

RECORD OF DURABLE WITNESS MONUMENTS

NO	DESCRIPTION	MAGNETIC	
		BEARING	DISTANCE
1	Set P.K. Nail in SE-side 11" Maple	N 16° E	47.71 Ft.
2	Exist. Nail in large double Maple (N.-side)	N 86° E	3.42 Ft.
3	Exist. Nail in large double Maple (SW-side)	S 41° E	40.05 Ft.
4	Exist. Nail in multi-trunk tree (E.-side)	S 01° W	46.43 Ft.

(Note: trees 2,3 & 4 have existing double blazes.)


(SWAMP GRASS)

NE-Cor., Sec. 32-16-7.
Set a 1" x 24" Iron Pipe to replace Bill Woodman's Nail. The pipe was pounded into part of a tree root.

(SWAMP)

EXISTING POWER-LINE 98'± SOUTH OF CORNER

PLAN VIEW DRAWING OF REFERENCE TIES

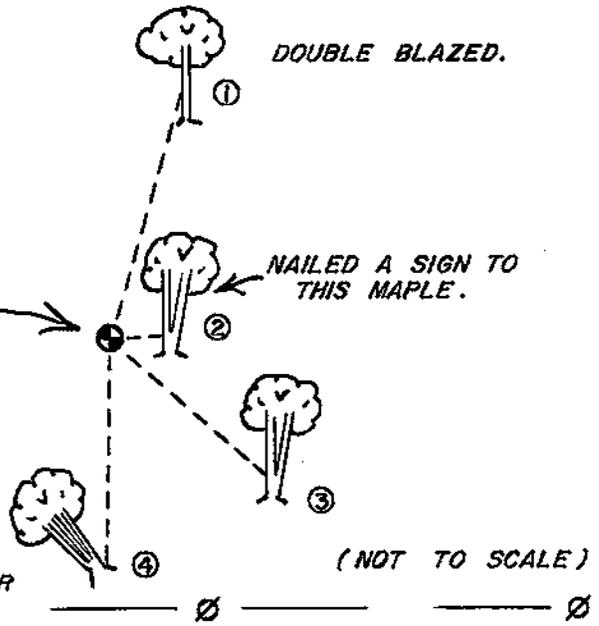

MAP SHOWING DISTANCE AND DIRECTION TO OTHER PUBLIC LAND SURVEY CORNERS USED FOR REESTABLISHING THE CORNER

The corner location was confirmed by Bill Woodman's measurements.

I, William C. Jung, County Surveyor
HEREBY CERTIFY THAT THE CORNER LOCATION SHOWN ON THIS RECORD WAS DETERMINED BY ME OR UNDER MY DIRECTION AND CONTROL AND THAT THIS U. S. PUBLIC LAND SURVEY MONUMENT RECORD IS CORRECT AND COMPLETE TO THE BEST OF MY KNOWLEDGE AND BELIEF.

William C. Jung 9/6/95
Signature Date



Seal