


21607310000

U. S. PUBLIC LAND SURVEY MONUMENT RECORD

SECTION 32 T 16 N, R 7 W, ~~TOWN~~ CITY OF LA CROSSE

LA CROSSE COUNTY

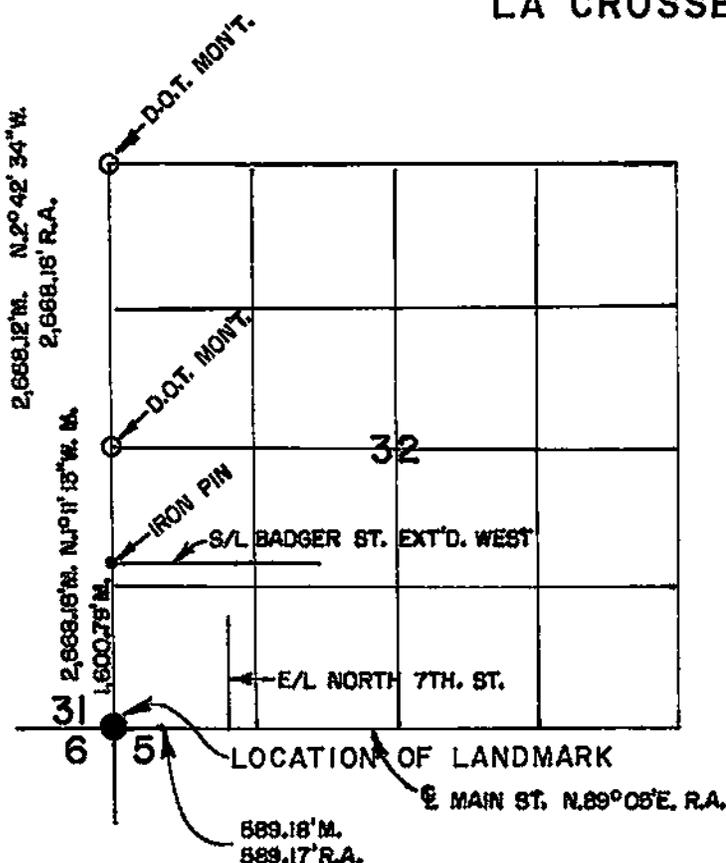

WISCONSIN COORDINATE SYSTEM
North
East
Theta Angle
Horiz. Order
Vert. Order

TYPE OF LANDMARK
 SET → 3/4" ϕ SOLID IRON BAR

BEARINGS ARE REFERENCED TO
 EAST LINE OF NORTH 7TH STREET
 AS "NORTH"

Describe any record evidence, monument evidence, testimonial evidence or any other material evidence you considered and whether the monument was found or restored through acceptance of an obliterated evidence location.

NAIL & TAB SET AT THIS CORNER IN NOVEMBER OF 1982 FROM TIES TO ϕ OF ALLEY. THE SECTION LINE IS 10' WEST OF THE EAST LINE OF THE ALLEY AS PER BURN'S, FARNAM & BURN'S ADDITION TO THE CITY OF LA CROSSE.

Describe or show any material discrepancy between the location of the restored corner and that of the corner previously restored or reestablished.


FOUND RAILROAD SPIKE* SET BY UNKNOWN PERSON, 0.17' WEST & 0.06' NORTH OF NAIL & TAB IN MAY OF 1989. C.S.M., VOL.1, PAGE 38, MADE BY F.J. KRAFT, SHOWS THAT HE SET A 1" IRON PIPE. (JUNE 5, 1973)

*RAILROAD SPIKE SHOWN ON C.S.M., VOL.2, PAGE 190, DOC. #938596, DATED 4-25-84, RECORDED 7-2-84, BY KAYE D. PEDERSON. (SET)


USED SWING TIES FROM BUILDINGS ON NORTH SIDE OF MAIN STREET AT 16' ALLEY FROM DAVY ENGR. CO., NOTEBOOK #216, AND FOUND TIES TO BE 0.43' WEST OF 3/4" ϕ SOLID IRON BAR SET. (BOTH BUILDINGS HAD "NEW" OR FALSE FRONTS ON THEM.) TIES USED BY L.J. MARCOU, R.L.S., IN 1962 FOR "SURVEY OF ST. JOSEPH THE WORKMAN CATHEDRAL AND RECTORY."

RECORD OF DURABLE WITNESS MONUMENTS

NO	DESCRIPTION	BEARING	DISTANCE
1	DRILL HOLE IN CONCRETE ALLEY	N - E'LY	157.71'
2	DRILL HOLE IN CONCRETE ALLEY	N - E'LY	39.95'
3	DRILL HOLE IN SIDEWALK (TOP N.S.P. VAULT)	S - W'LY	35.00'
4			

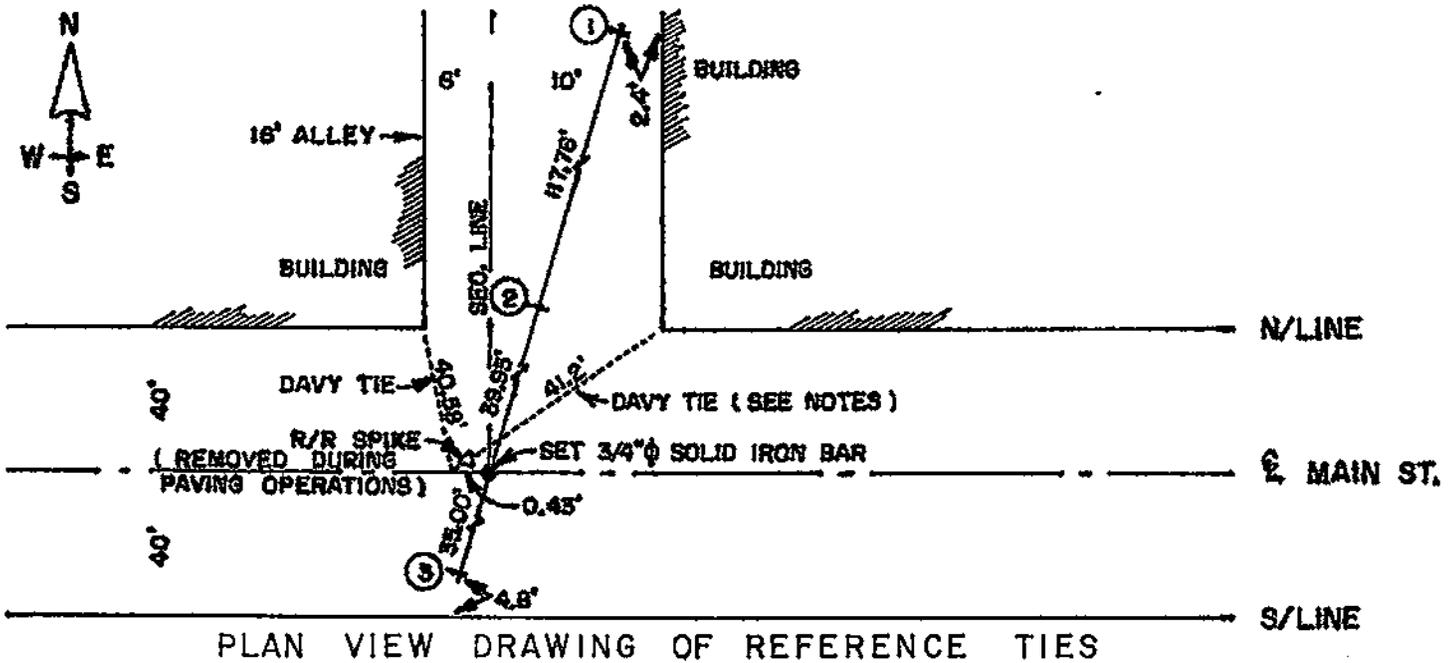

MAP SHOWING DISTANCE AND DIRECTION TO OTHER PUBLIC LAND SURVEY CORNERS USED FOR REESTABLISHING THE CORNER

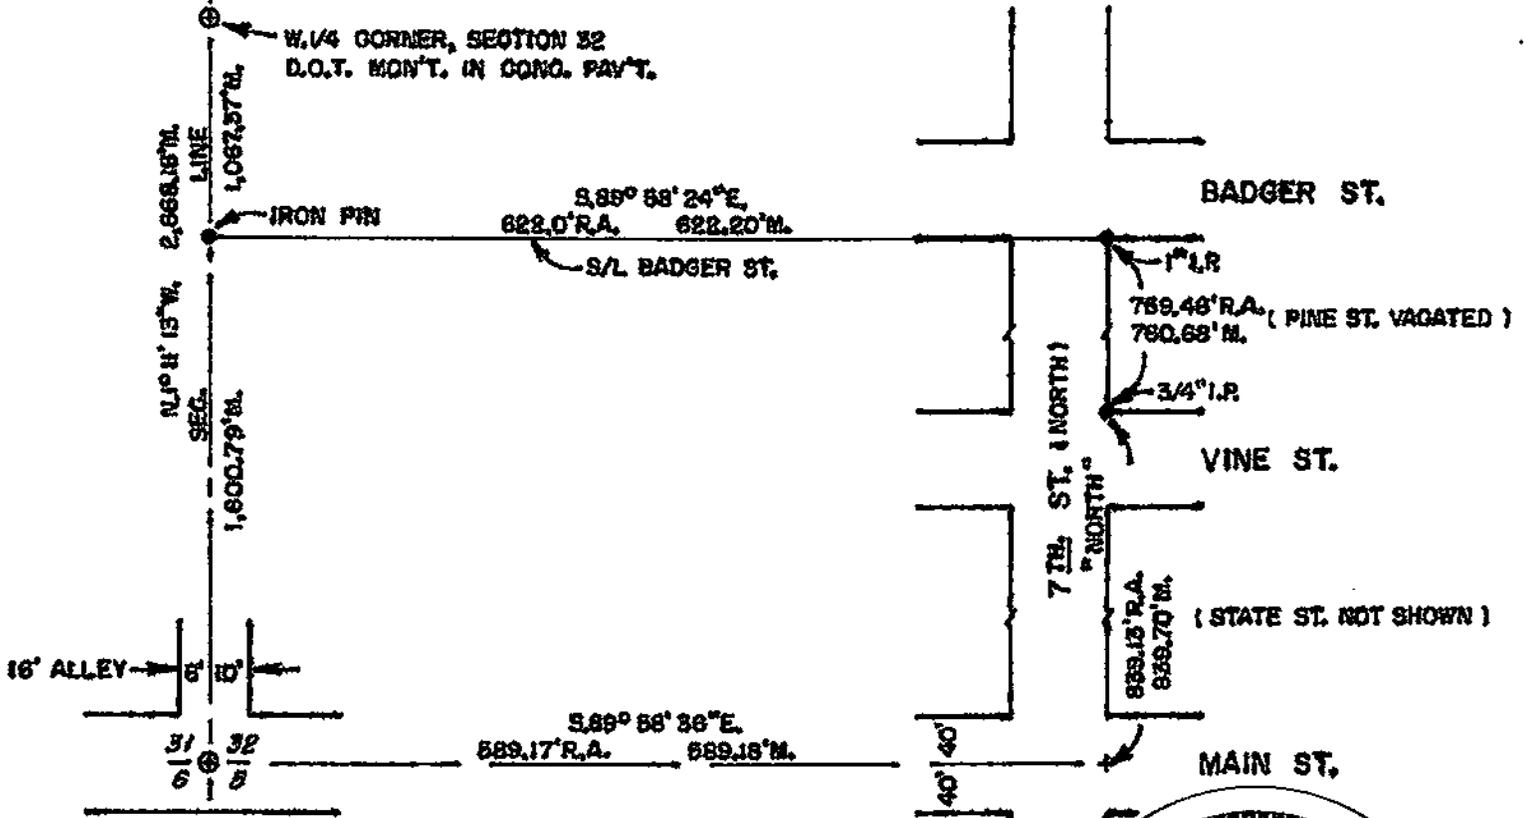

I, Wilbur L. Clark
 HEREBY CERTIFY THAT THE CORNER LOCATION SHOWN ON THIS RECORD
 WAS DETERMINED BY ME OR UNDER MY DIRECTION AND CONTROL AND
 THAT THIS U. S. PUBLIC LAND SURVEY MONUMENT RECORD IS CORRECT
 AND COMPLETE TO THE BEST OF MY KNOWLEDGE AND BELIEF.


Wilbur L. Clark 6-1-1989.
 Signature Date



Seal

Tie Sheet, City of La Crosse

Section 32 Township 16 N Range 7 W

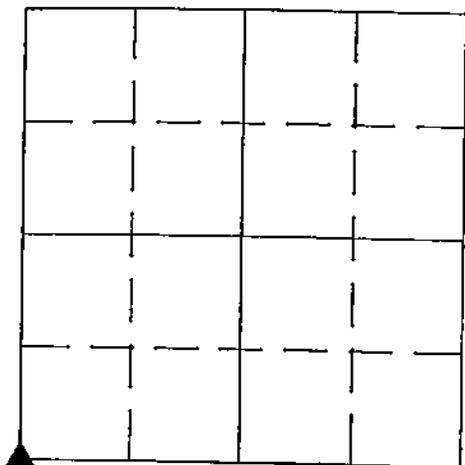


Project Section Corner
 Sta No _____
 Monument _____
 Coord. System _____
 North _____
 East _____
 Elev _____
 Surveyor County

Comments:

Date _____

Space for copy of field notes or ties to above described monument:

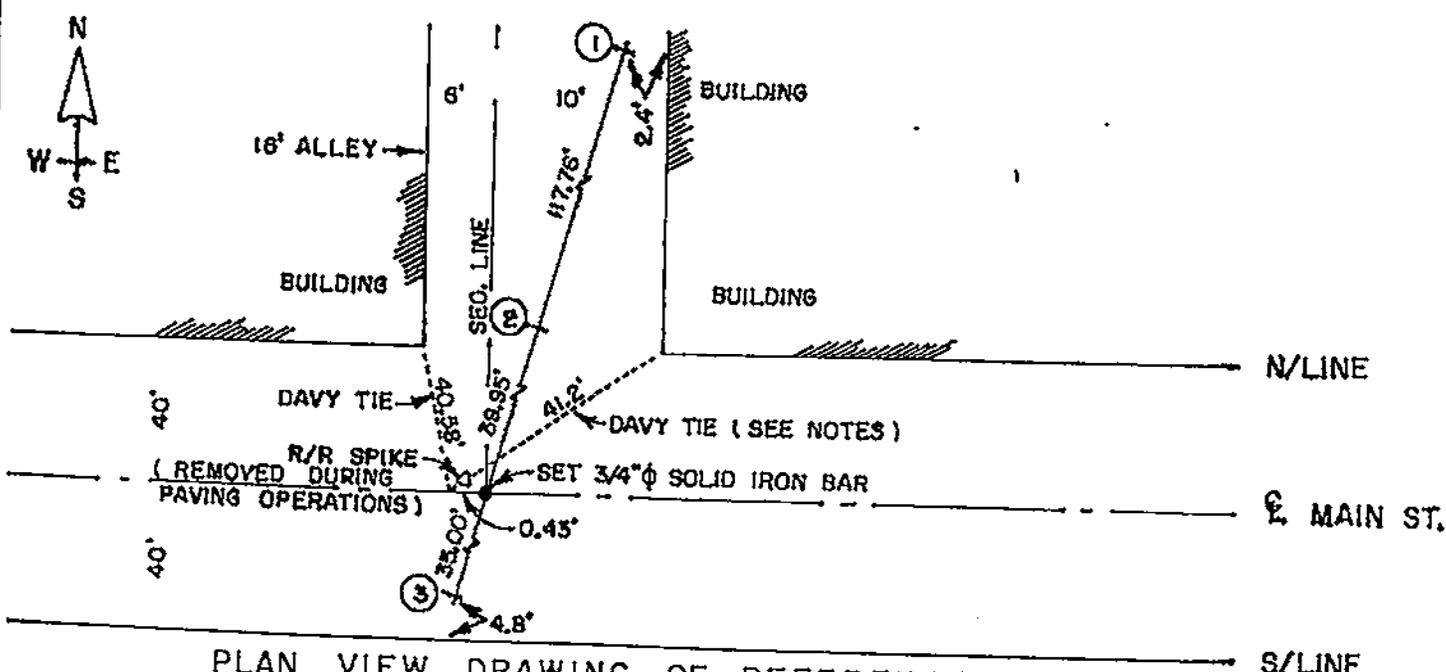

PLAN VIEW DRAWING OF REFERENCE TIES

MAP SHOWING DISTANCE AND DIRECTION TO OTHER PUBLIC LAND SURVEY CORNERS USED FOR REESTABLISHING THE CORNER