


21607322000

U. S. PUBLIC LAND SURVEY MONUMENT RECORD

SECTION 33 T 16 N, R 7 W, ^{CITY} ~~TOWN~~ OF LACROSSE
 LA CROSSE COUNTY

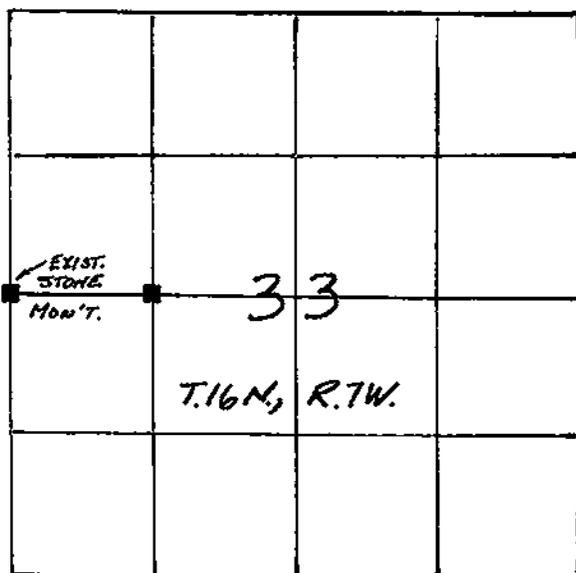

LOCATION OF LANDMARK

WISCONSIN COORDINATE SYSTEM	
North	
East	
Theta Angle	
Horiz. Order	
Vert. Order	
TYPE OF LANDMARK	5 1/2" x 8" STONE
	W. 1/4 CORNER, SEC. 33, MON'T.
BEARINGS ARE REFERENCED TO	

Describe any record evidence, monument evidence, testimonial evidence or any other material evidence you considered and whether the monument was found or restored through acceptance of an obliterated evidence location.


EXISTING 5 1/2" x 8" STONE MON'T. ON WEST LINE OF EAST AVE. AND 238' NORTH OF THE C_E OF LACROSSE ST. STONE IS UP 12" TO 10" ±, ON WEST SIDE OF OAK GROVE CEMETERY.

Describe or show any material discrepancy between the location of the restored corner and that of the corner previously restored or reestablished.

N/A.

RECORD OF DURABLE WITNESS MONUMENTS

NO	DESCRIPTION	BEARING	DISTANCE
1	NAIL & TAB IN CEM. DRIVE	N.W. OF MONT.	25.23'
2	" " " " " "	S.W. OF MONT.	21.12'
3	"THORE O. THORSEN" GRAVE STONE, CENTER OF "9" IN DATE OF DEATH, 1910.	N.W. OF MONT.	9.66'
4	"AMUNNSEN" GRAVE STONE, 3.6' HIGH, OUTSIDE CORNER (N.E.) OF LOWER BASE.	S.W. OF MONT.	12.16'

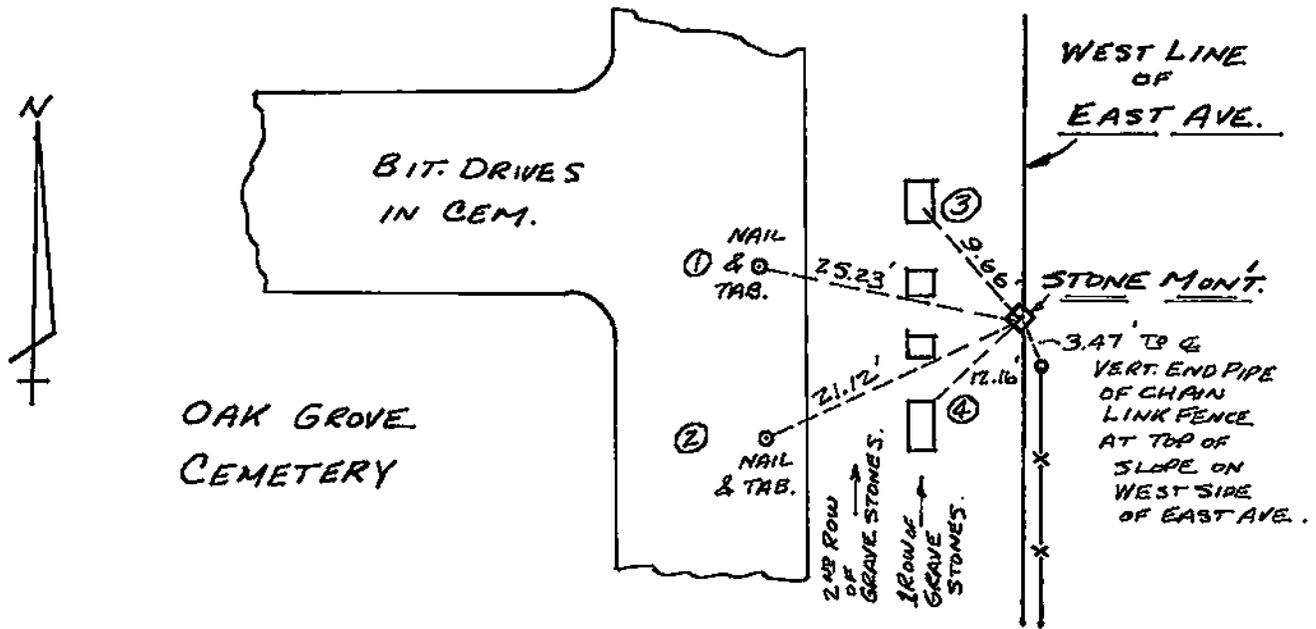

PLAN VIEW DRAWING OF REFERENCE TIES

MAP SHOWING DISTANCE AND DIRECTION TO OTHER PUBLIC LAND SURVEY CORNERS USED FOR REESTABLISHING THE CORNER

I, WILBUR L. CLARK
 HEREBY CERTIFY THAT THE CORNER LOCATION SHOWN ON THIS RECORD
 WAS DETERMINED BY ME OR UNDER MY DIRECTION AND CONTROL AND
 THAT THIS U. S. PUBLIC LAND SURVEY MONUMENT RECORD IS CORRECT
 AND COMPLETE TO THE BEST OF MY KNOWLEDGE AND BELIEF.

Wilbur L. Clark 12-4-1991.
 Signature Date



Seal

NO. 148

Zoning and Planning Department

LA CROSSE COUNTY, WISCONSIN

Courthouse, La Crosse, Wisconsin 54601



Telephone: 785-9722

West 1/4 Corner, Section 33-T16N-R7W, City of LaCrosse

January 4, 1993

To Whom It May Concern:

This is to certify that on March 26, 1992, Peter Follansbee and I found the corner of record, buried a wine bottle to the NE of the stone, set a sign and post to the NE, and set a Lunde also to the NE of the stone. The Lunde is merely a witness. The stone is the corner.

William C. Jung

William C. Jung
Registered Land Surveyor
Deputy County Surveyor

