


## U. S. PUBLIC LAND SURVEY MONUMENT RECORD

SECTION 32 T 16 N, R 7 W, ~~TOWN OF~~ CITY OF LA CROSSE  
LA CROSSE COUNTY

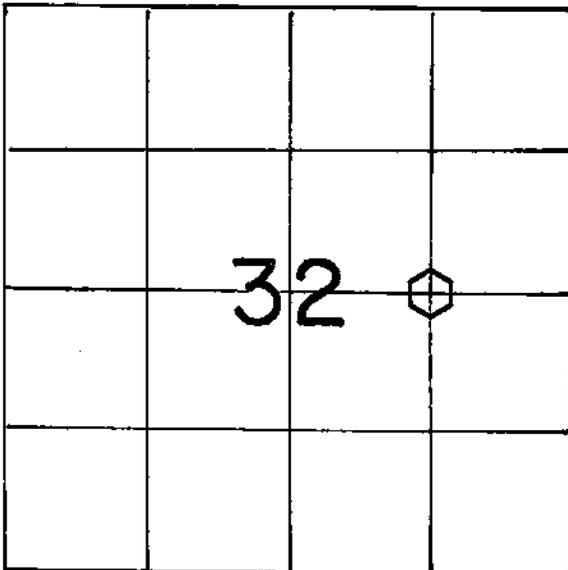

LOCATION OF LANDMARK

## WISCONSIN COORDINATE SYSTEM

North

East

Theta Angle

Horiz. Order

Vert. Order

## TYPE OF LANDMARK

Set brass cap Lunde marker.

BEARINGS ARE REFERENCED TO

Crew: WILLIAM C. JUNG

Date: 6/22/1993

Describe any record evidence, monument evidence, testimonial evidence or any other material evidence you considered and whether the monument was found or restored through acceptance of an obliterated evidence location.

Otto Mueller set a 4"x4"x24" cedar stake at this corner in August of 1891. This is recorded in Volume 6 of Plats, Page 1. Bill Woodman, RLS, verified the location of this corner while doing further surveying in the cemetery. I monumented the location with a brass capped Lunde marker.

Describe or show any material discrepancy between the location of the restored corner and that of the corner previously restored or reestablished.

None Known

