


U. S. PUBLIC LAND SURVEY MONUMENT RECORD

SECTION 33 T 16 N, R 7 W, <sup>City</sup> ~~TOWN~~ OF LaCrosse

LA CROSSE COUNTY

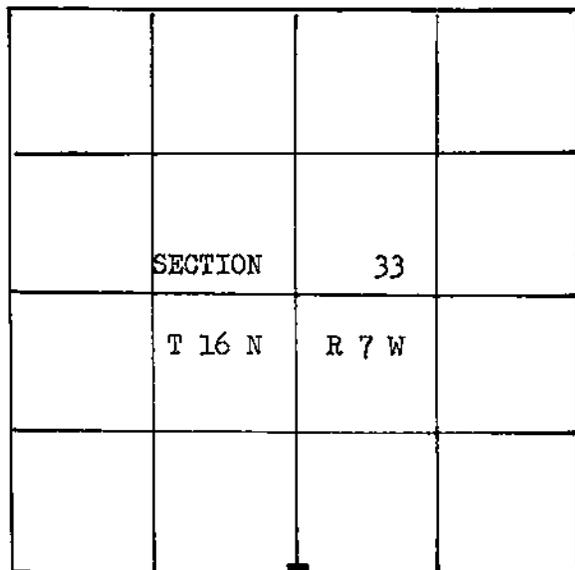

LOCATION OF LANDMARK

WISCONSIN COORDINATE SYSTEM
North
East
Theta Angle
Horiz. Order
Vert. Order

TYPE OF LANDMARK  
S 1/4 Cor. (set p.k. nail)

BEARINGS ARE REFERENCED TO  
S.T.H. "16" right-of-way project  
no. 7575-02-21 (Wisconsin coordinate  
system)

Describe any record evidence, monument evidence, testimonial evidence or any other material evidence you considered and whether the monument was found or restored through acceptance of an obliterated evidence location.


The S1/4 corner of Section 33 was established using recorded measurements and angles as tied to the plat of Jarcho Addition and E.H. Saenger's Addition, City of La Crosse.

Describe or show any material discrepancy between the location of the restored corner and that of the corner previously restored or reestablished.

N/A

RECORD OF DURABLE WITNESS MONUMENTS

NO	DESCRIPTION	BEARING	DISTANCE
1	Southerly corner of rectangular stone base on First Congregational Church sign	N19°35'26"E	47.57'
2	Power Pole (set p.k.nail on west side)	S31°51'16"E	31.46'
3	Existing 3/4" Iron pipe at SW corner of Lot 1 of Block 1, The Jarcho Addition.	N0°47'56"W	297.49'
4	Existing 3/4" Iron Bar at the intersection of the North R/W of Main St. and East R/W of Losey Blvd.	N0°47'56"W	40.00'

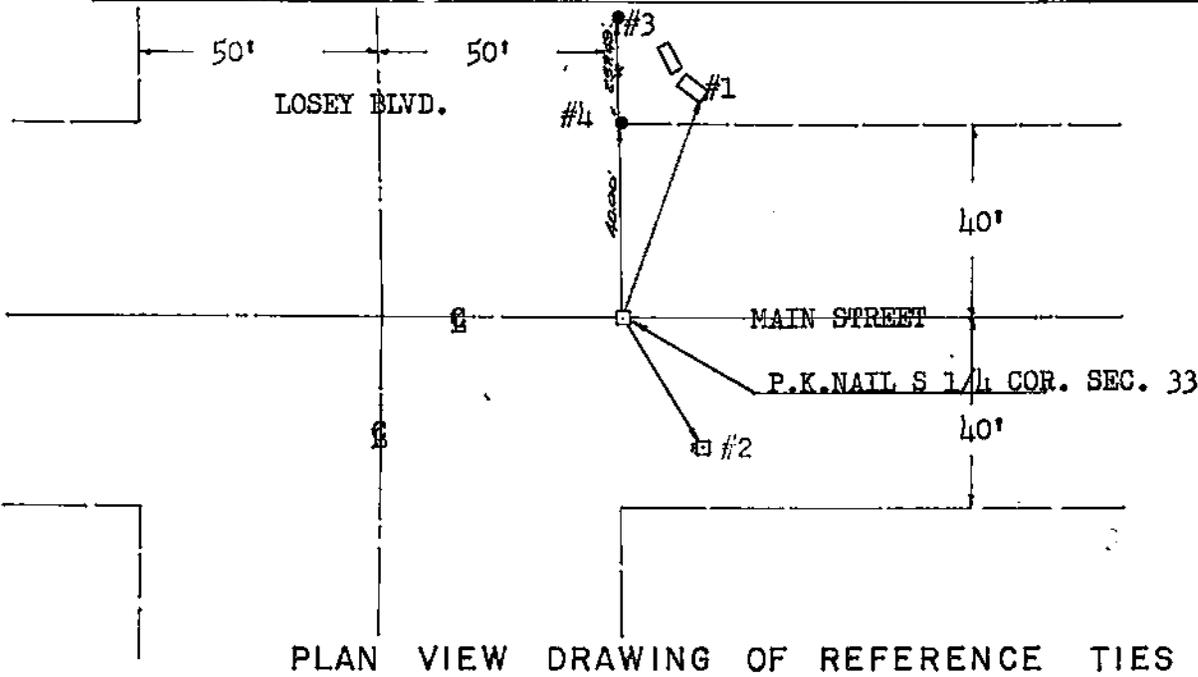

PLAN VIEW DRAWING OF REFERENCE TIES

MAP SHOWING DISTANCE AND DIRECTION TO OTHER PUBLIC LAND SURVEY CORNERS USED FOR REESTABLISHING THE CORNER

N/A

I, Robert M. Lampman, Registered Land Surveyor, do  
 HEREBY CERTIFY THAT THE CORNER LOCATION SHOWN ON THIS RECORD  
 WAS DETERMINED BY ME OR UNDER MY DIRECTION AND CONTROL AND  
 THAT THIS U. S. PUBLIC LAND SURVEY MONUMENT RECORD IS CORRECT  
 AND COMPLETE TO THE BEST OF MY KNOWLEDGE AND BELIEF.

Robert M. Lampman  
 Signature


6-6-84  
 Date



Seal

U. S. PUBLIC LAND SURVEY MONUMENT RECORD

SECTION 33 T 16 N, R 7 W, <sup>CITY</sup>~~TOWN~~ OF LA CROSSE  
 LA CROSSE COUNTY

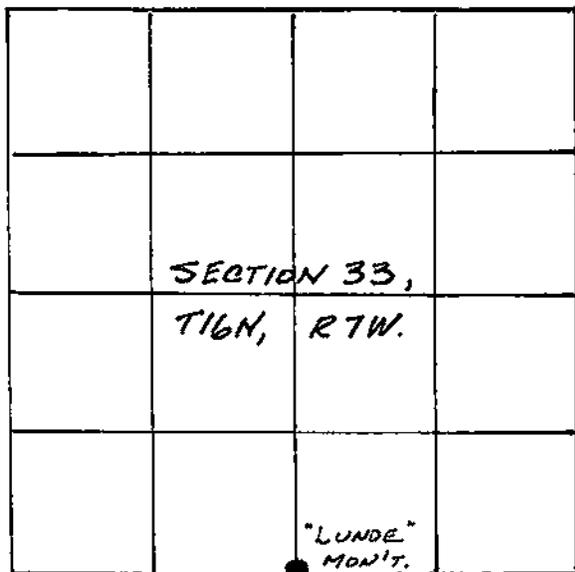

LOCATION OF LANDMARK

WISCONSIN COORDINATE SYSTEM
North
East
Theta Angle
Horiz. Order
Vert. Order
TYPE OF LANDMARK "LUNDE" SOUTH 1/4 CORNER = MONUMENT.
BEARINGS ARE REFERENCED TO

Describe any record evidence, monument evidence, testimonial evidence or any other material evidence you considered and whether the monument was found or restored through acceptance of an obliterated evidence location.

P.K. NAIL EXISTED; SEE TIE SHEET SUBMITTED BY  
 ROBERT M. LAMPMAN, DATED 6-6-1984.

REPLACED P.K. WITH "LUNDE" MONUMENT ON MAY 10, 1991,  
 WITH BILL JUNG, LA CROSSE COUNTY, DEPUTY CO. SURVEYOR.


FOUND STONE, DOWN 3'±, PLACED GLASS BOTTLE W/BRASS CASING  
 INSIDE (SHELL CASING). SET 2-2 FOOT OFFSET DRILL HOLES - SEE SKETCH.

Describe or show any material discrepancy between the location of the restored (over) corner and that of the corner previously restored or reestablished.

N/A.

RECORD OF DURABLE WITNESS MONUMENTS

NO	DESCRIPTION	BEARING	DISTANCE
1	SEE → ROBERT LAMPMAN TIE SHEET		✓
2	OF 6-6-1984.		31.62' <del>31.46'</del>
3			
4			✓

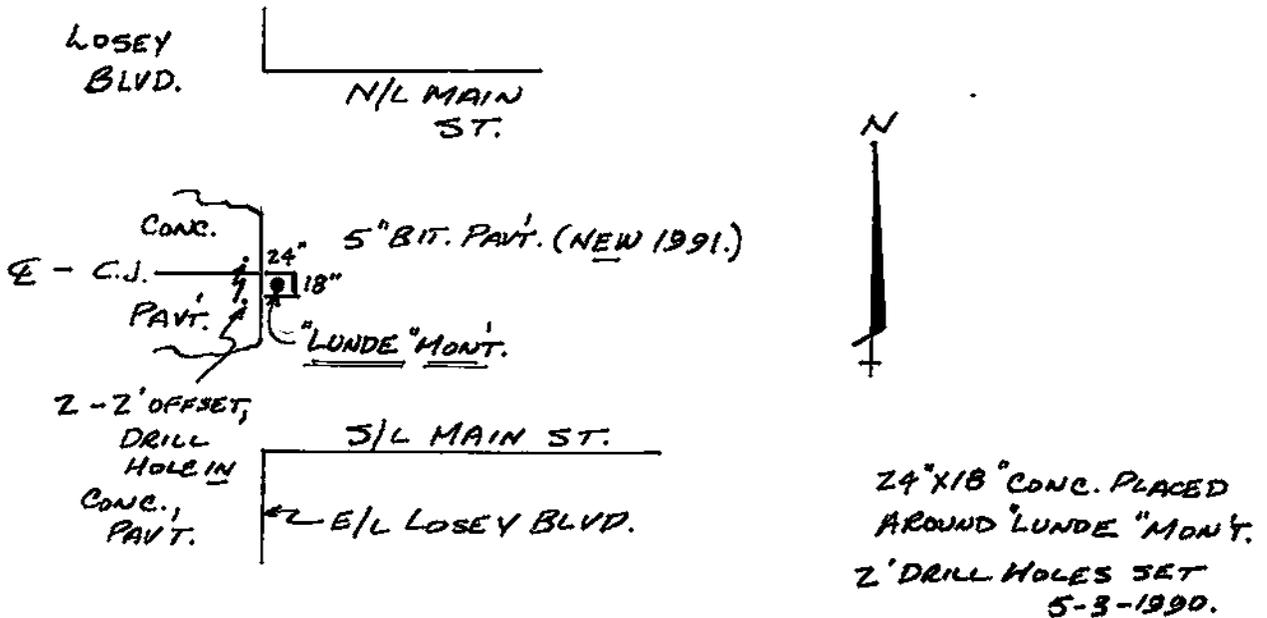

PLAN VIEW DRAWING OF REFERENCE TIES



MAP SHOWING DISTANCE AND DIRECTION TO OTHER PUBLIC LAND SURVEY CORNERS USED FOR REESTABLISHING THE CORNER

N/A (REPLACED EXISTING P.K. WITH "LUNDE" MONUMENT DUE TO NEW STREET CONSTRUCTION & PAVING.)

I, WILBUR L. CLARK  
 HEREBY CERTIFY THAT THE CORNER LOCATION SHOWN ON THIS RECORD WAS DETERMINED BY ME OR UNDER MY DIRECTION AND CONTROL AND THAT THIS U. S. PUBLIC LAND SURVEY MONUMENT RECORD IS CORRECT AND COMPLETE TO THE BEST OF MY KNOWLEDGE AND BELIEF.


Wilbur L. Clark - 12-4-1991.  
 Signature Date



Seal

# Tie Sheet, City of La Crosse

Section 33 Township 16 N Range 7 W

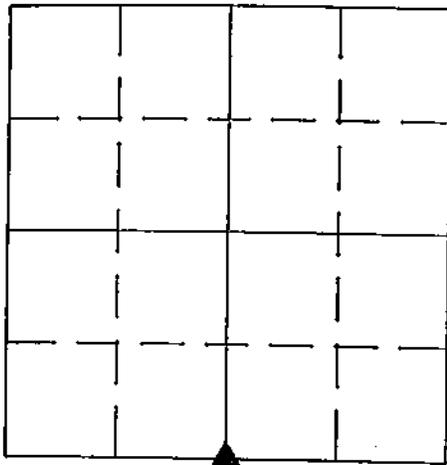


Project Section Corner  
 Sta No \_\_\_\_\_  
 Monument \_\_\_\_\_  
 Coord. System \_\_\_\_\_  
 North \_\_\_\_\_  
 East \_\_\_\_\_  
 Elev \_\_\_\_\_  
 Surveyor County

Comments:

Date \_\_\_\_\_

Space for copy of field notes or ties to above described monument:

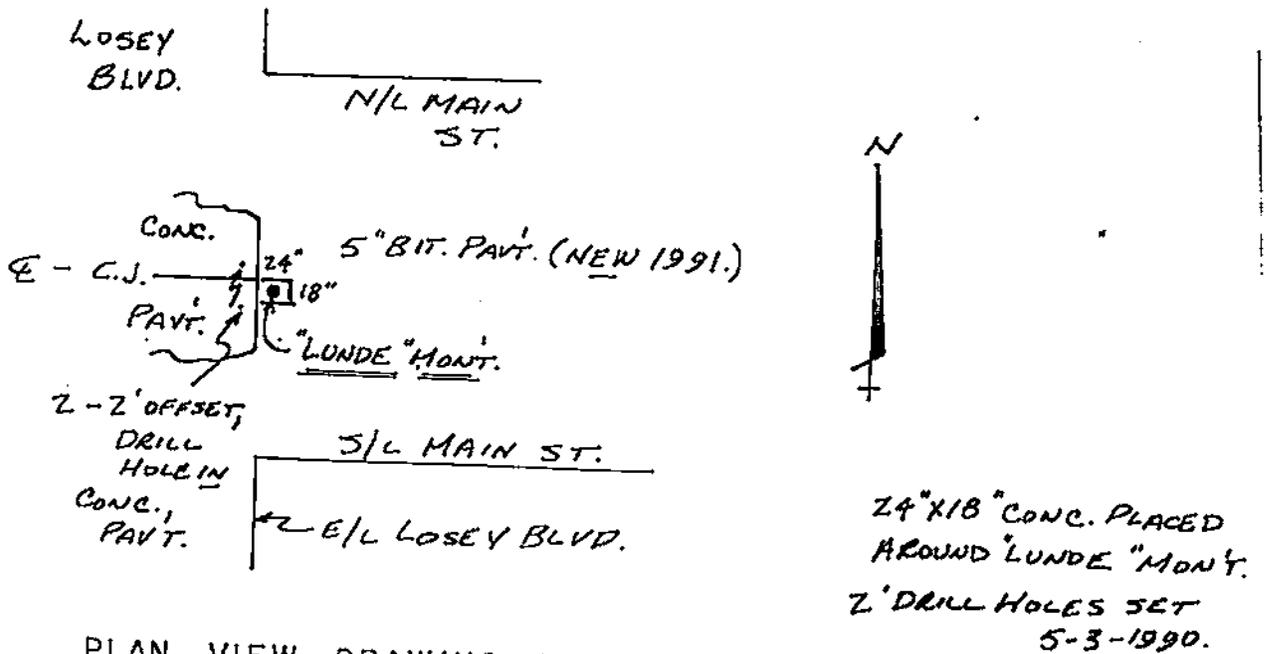

PLAN VIEW DRAWING OF REFERENCE TIES

MAP SHOWING DISTANCE AND DIRECTION TO OTHER PUBLIC LAND SURVEY CORNERS USED FOR REESTABLISHING THE CORNER