


21607332000

U. S. PUBLIC LAND SURVEY MONUMENT RECORD

SECTION 33 T 16 N, R 7 W, ^{City} TOWN OF LaCrosse
 LA CROSSE COUNTY

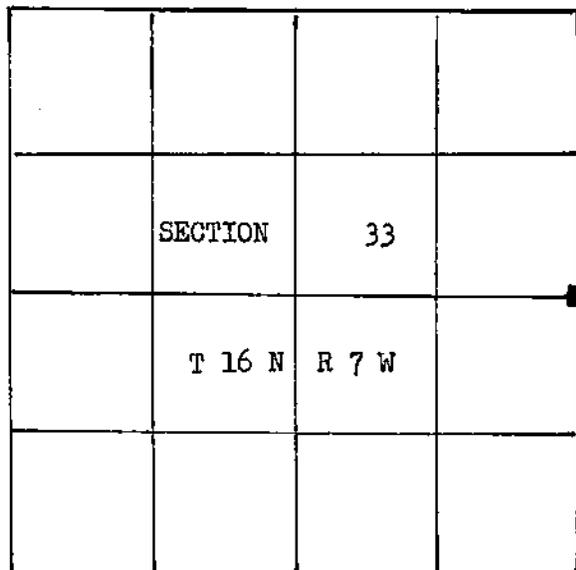

LOCATION OF LANDMARK

WISCONSIN COORDINATE SYSTEM
North
East
Theta Angle
Horiz. Order
Vert. Order
TYPE OF LANDMARK
E 1/4 Cor. (existing 3/4" I.P in conc.)
BEARINGS ARE REFERENCED TO
S.T.H. "16" right-of-way project
no. 7575-02-21 (Wisconsin Coordinate system)

Describe any record evidence, monument evidence, testimonial evidence or any other material evidence you considered and whether the monument was found or restored through acceptance of an obliterated evidence location.

Found existing 3/4" iron pipe set in concrete at the East 1/4 Corner of Section 33, T 16 N, R 7 W.

Describe or show any material discrepancy between the location of the restored corner and that of the corner previously restored or reestablished.

N/A

