


U. S. PUBLIC LAND SURVEY MONUMENT RECORD

SECTION 35 T 16 N, R 7 W, TOWN OF MEDARY

LA CROSSE COUNTY

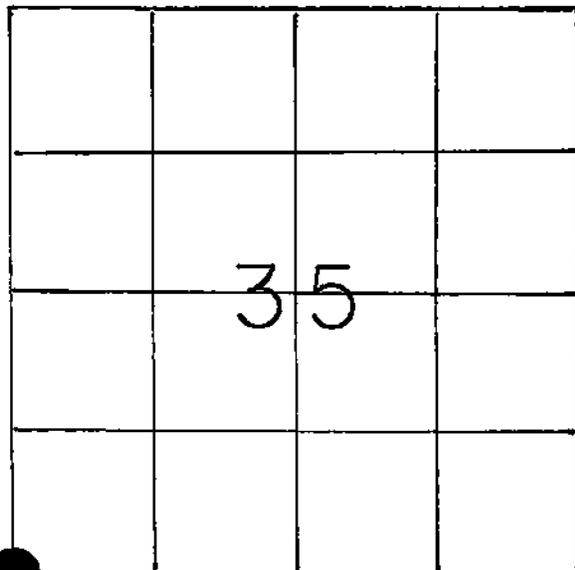

LOCATION OF LANDMARK

CREW: WILLIAM C. JUNG
 PETER F. FOLLANSBEE
 09/22/1987

WISCONSIN COORDINATE SYSTEM
North
East
Theta Angle
Horiz. Order
Vert. Order
TYPE OF LANDMARK
SET 8" NAIL IN EXIST. I.P.
BEARINGS ARE REFERENCED TO

Describe any record evidence, monument evidence, testimonial evidence or any other material evidence you considered and whether the monument was found or restored through acceptance of an obliterated evidence location.


I found an iron pipe at the corner used in previous surveys and accepted it as the best available evidence of the original government corner position. I set an 8" timber nail in the pipe and brought it to the surface of the road. It was very hard digging.

Describe or show any material discrepancy between the location of the restored corner and that of the corner previously restored or reestablished.

There is an old map on file showing a "marked stone" at this corner. However, the road embankment has been built up considerably here. It would not be economically feasible or practical to dig at this location.

RECORD OF DURABLE WITNESS MONUMENTS

NO	DESCRIPTION	BEARING	DISTANCE
1	FOUND EXISTING 1 1/2" IRON PIPE	WEST ±	33.1 Ft.
2	SET P.K. NAIL APPROX. INTERS. BRIARWOOD & "F"	NORTH ±	201.2 Ft.
3	FOUND EXISTING 1 1/2" IRON PIPE	EAST ±	35.8 Ft.
4			

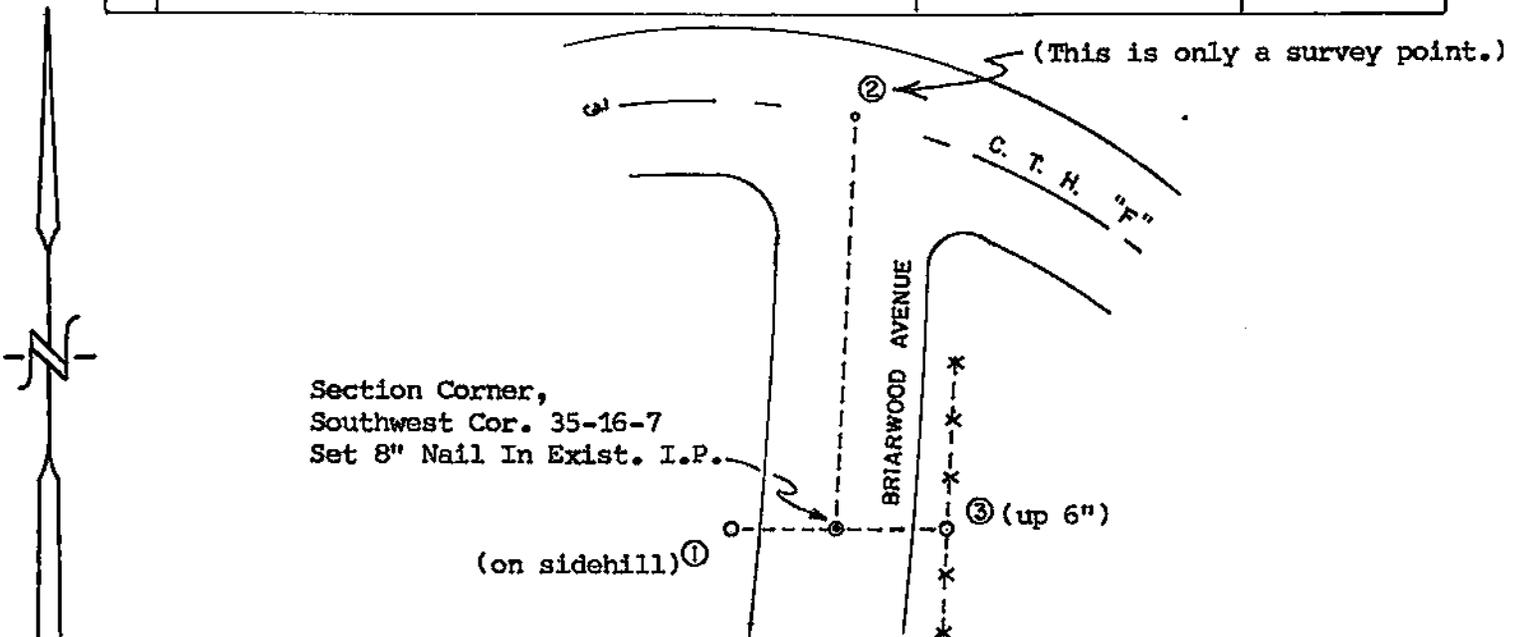


PLAN VIEW DRAWING OF REFERENCE TIES

MAP SHOWING DISTANCE AND DIRECTION TO OTHER PUBLIC LAND SURVEY CORNERS USED FOR REESTABLISHING THE CORNER

(no measurements made by me at this time)

I, WILLIAM C. JUNG
 HEREBY CERTIFY THAT THE CORNER LOCATION SHOWN ON THIS RECORD
 WAS DETERMINED BY ME OR UNDER MY DIRECTION AND CONTROL AND
 THAT THIS U. S. PUBLIC LAND SURVEY MONUMENT RECORD IS CORRECT
 AND COMPLETE TO THE BEST OF MY KNOWLEDGE AND BELIEF.

William C. Jung Deputy County Surveyor, December 15, 1987
 Signature Date

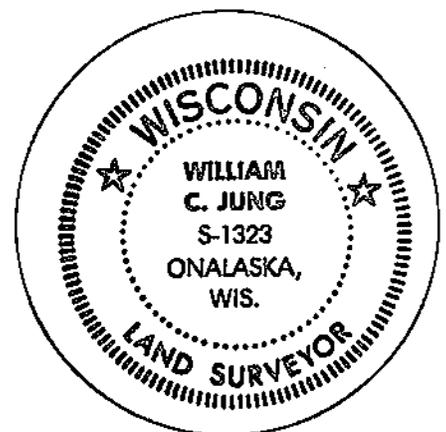

Seal