


21607342000

U. S. PUBLIC LAND SURVEY MONUMENT RECORD

SECTION 35 T 16 N, R 7 W, TOWN OF MEDARY

LA CROSSE COUNTY

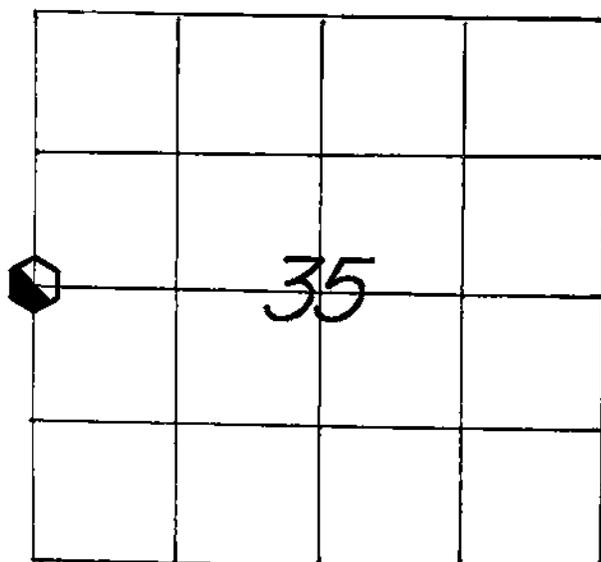

WISCONSIN COORDINATE SYSTEM	
North	665,274.944
East	1,654,584.607
Theta Angle	
Horiz. Order	
Vert. Order	
DATUM:	1983('91)
TYPE OF LANDMARK	
30" ALUMINUM BERNTSEN MARKER.	
BEARINGS ARE REFERENCED TO	
GRID NORTH AS PER SECTION DATA.	

LOCATION OF LANDMARK

CREW: WILLIAM G. JUNG
 PETER F. FOLLANSBEE
 DATE: 7/07/2005

Describe any record evidence, monument evidence, testimonial evidence or any other material evidence you considered and whether the monument was found or restored through acceptance of an obliterated evidence location.

I set this corner by intersecting the old occupied 1/4 line to the East with the West line of the section. I set a Berntsen marker at the corner. It falls about four feet North of the fence, but the fence at this point meanders around a bit. After reviewing all the section data and evidence, this appears to me to be the best way to set this corner.

Describe or show any material discrepancy between the location of the restored corner and that of the corner previously restored or reestablished.

I do not believe that the existing iron pipe 99.93 feet to the East is the corner. In 1976 O. Bergman found this pipe and apparently assumed it to be the 1/4 corner. In 1984 Rob Lampman found this pipe, used it as the 1/4 corner, and also filed a tie sheet. Phil Schölze used this pipe as the corner in a 1988 survey. Actually this pipe appears to be the property corner pipe as called for in Volume 194 Deeds, Page 48, recorded in 1941. Randy Connell agreed with me years ago. That's why his two surveys to the southeast show this as an existing lot corner, not the 1/4 corner. It is clear in studying 194/48 that whoever made the measurements for that deed did not know the location of the 1/4 corner. If he did, why did he go all the way to the East to the "forty" corner? Clearly to me the pipe that Bergman found was not the correct corner.

RECORD OF DURABLE WITNESS MONUMENTS

NO	DESCRIPTION	MAGNETIC	
		BEARING	DISTANCE
1	SET A NAIL IN N.-SIDE OF A 24" OAK	S 88° W	28.50 FT.
2	SET A NAIL IN S.W.-SIDE OF A 12½" WHITE OAK	N 16° W	8.23 FT.
3	SET A NAIL IN S.-SIDE OF A 9½" OAK	N 78° E	40.62 FT.
4	TOP OF EX. 1½" I. PIPE, UP 12" AND LEANING S.-S.EAST	EAST ±	99.93 FT.

(NOT TO SCALE)


(NOTE: THE THREE BEARING TREES ARE DOUBLE BLAZED.)

(WOODED - SIDEHILL)

(WOODS)

W. 1/4 - COR., 35-16-7.
SET A 30" ALUMINUM BERNTSEN MARKER 4' NORTH OF THE FENCE IN A SMALL, ROCKY DRY RUN. MOUNDED THE MARKER WITH ROCKS AND SET A SIGN & POST NEARBY.


IRON PIPE IS APPROX. 4' NORTH OF FENCE.

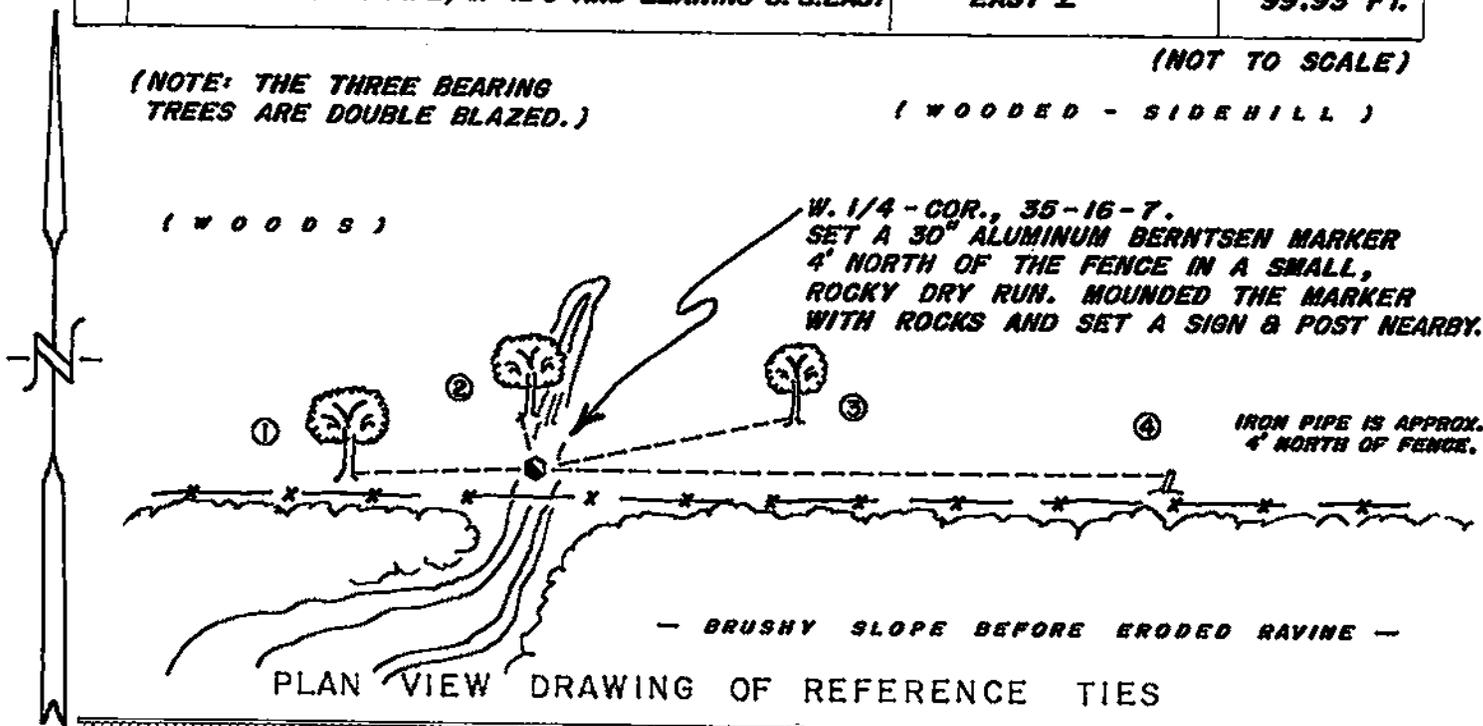

PLAN VIEW DRAWING OF REFERENCE TIES

MAP SHOWING DISTANCE AND DIRECTION TO OTHER PUBLIC LAND SURVEY CORNERS USED FOR REESTABLISHING THE CORNER

(GRID BEARINGS AND DISTANCES)
(GRID FACTOR: 0.9999267)
(NOT TO SCALE)

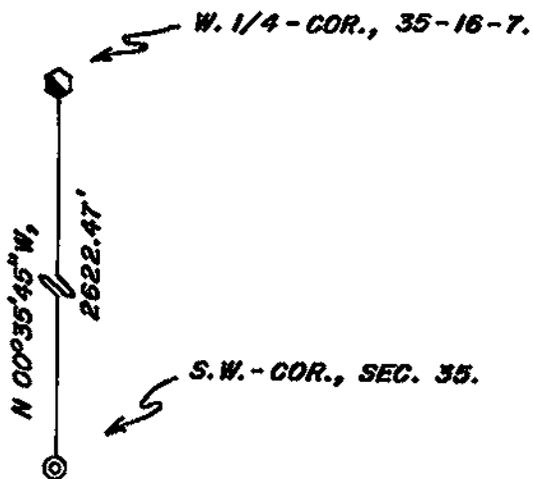

I, WILLIAM C. JUNG, COUNTY SURVEYOR
HEREBY CERTIFY THAT THE CORNER LOCATION SHOWN ON THIS RECORD WAS DETERMINED BY ME OR UNDER MY DIRECTION AND CONTROL AND THAT THIS U. S. PUBLIC LAND SURVEY MONUMENT RECORD IS CORRECT AND COMPLETE TO THE BEST OF MY KNOWLEDGE AND BELIEF.

William C. Jung 12/8/05
Signature Date




Seal

U. S. PUBLIC LAND SURVEY MONUMENT RECORD

SECTION 34 T 16 N, R 7 W, ^{City} ~~TOWN~~ OF LaCrosse

LA CROSSE COUNTY

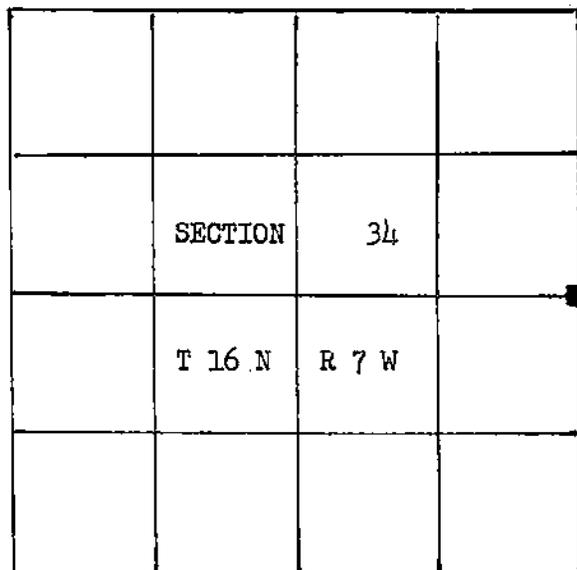

LOCATION OF LANDMARK

WISCONSIN COORDINATE SYSTEM
North
East
Theta Angle
Horiz. Order
Vert. Order
TYPE OF LANDMARK
EL/4 Cor. (Existing 1" I.P.)

BEARINGS ARE REFERENCED TO S.T.H."16" right-of-way project no. 7575-02-21 (Wisconsin coordinate system)

Describe any record evidence, monument evidence, testimonial evidence or any other material evidence you considered and whether the monument was found or restored through acceptance of an obliterated evidence location.


Found existing 1" iron pipe at the EL/4 corner of Section 34, T 16 N, R 7 W as indicated by O. Bergman R.L.S. S-195 Sept. 23, 1976.

Describe or show any material discrepancy between the location of the restored corner and that of the corner previously restored or reestablished.

N/A

RECORD OF DURABLE WITNESS MONUMENTS

NO	DESCRIPTION	BEARING	DISTANCE
1	6" diam. Bl. Oak with nail and tab at base (existing B.T.)	N22°39'53"E	5.27'
2	13" diam. Hickory with nail and tab at base (existing B.T.)	S17°35'45"E	35.88'
3	12" diam. Hickory with nail and tab at base (existing B.T.)	S51°56'05"W	16.97'
4	12" diam. Wt. Oak with nail and tab at base (existing B.T.)	N60°14'00"W	43.47'

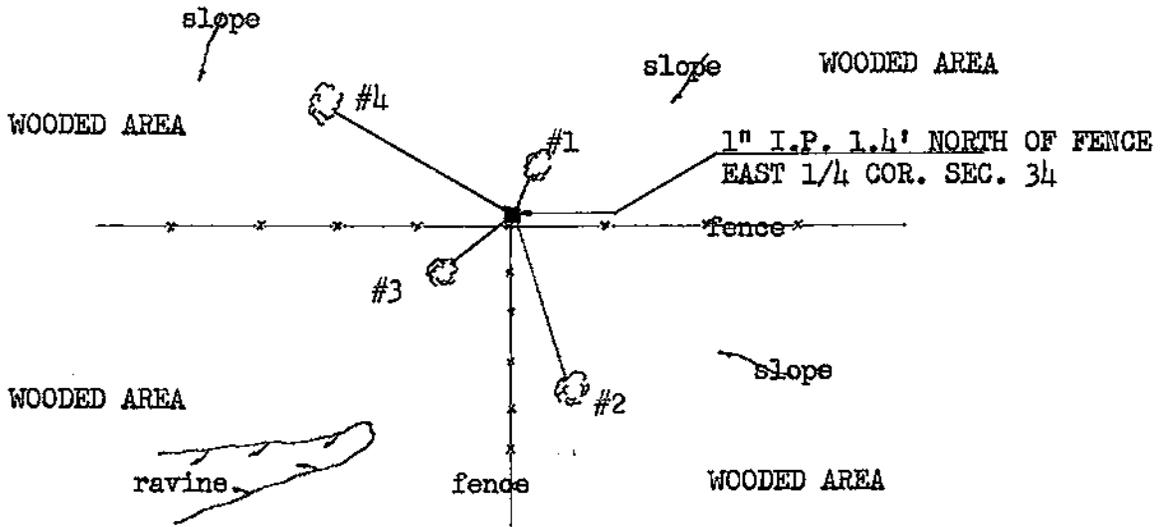

PLAN VIEW DRAWING OF REFERENCE TIES


MAP SHOWING DISTANCE AND DIRECTION TO OTHER PUBLIC LAND SURVEY CORNERS USED FOR REESTABLISHING THE CORNER

N/A

I, Robert M. Lampman, Registered Land Surveyor, do
 HEREBY CERTIFY THAT THE CORNER LOCATION SHOWN ON THIS RECORD
 WAS DETERMINED BY ME OR UNDER MY DIRECTION AND CONTROL AND
 THAT THIS U. S. PUBLIC LAND SURVEY MONUMENT RECORD IS CORRECT
 AND COMPLETE TO THE BEST OF MY KNOWLEDGE AND BELIEF.

Robert M. Lampman
 Signature

6-6-84
 Date

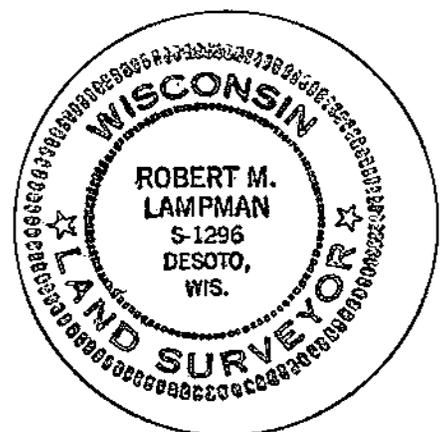

Seal