


21607350020

U. S. PUBLIC LAND SURVEY MONUMENT RECORD

SECTION 35 T 16 N, R 7 W, TOWN OF MEDARY

LA CROSSE COUNTY

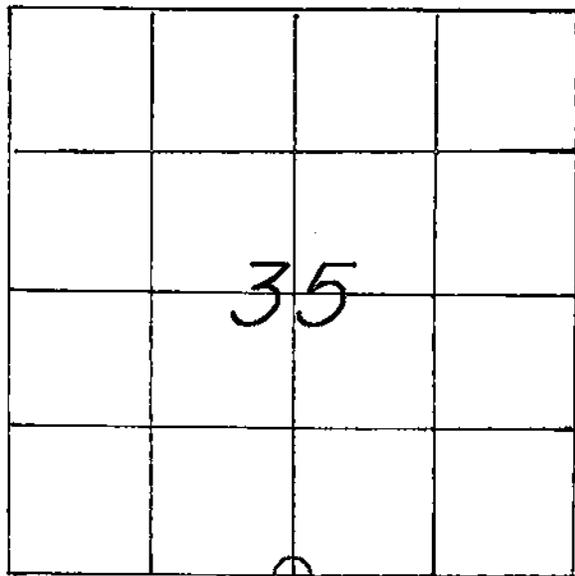

LOCATION OF LANDMARK

Crew: WILLIAM C. JUNG
 PETER F. FOLLANSBEE
 Date: 5/30/1997

WISCONSIN COORDINATE SYSTEM
North
East
Theta Angle
Horiz. Order
Vert. Order
TYPE OF LANDMARK
Existing 2" Iron Pipe.
BEARINGS ARE REFERENCED TO
Grid

Describe any record evidence, monument evidence, testimonial evidence or any other material evidence you considered and whether the monument was found or restored through acceptance of an obliterated evidence location.

I found an iron pipe at the corner. This pipe had been used as the ^{corner} in many previous surveys. I accepted this pipe as the best available evidence of the original government corner position. The old white oak to the NE appears to be an original B.T.

Describe or show any material discrepancy between the location of the restored corner and that of the corner previously restored or reestablished.

None Known.

