


U. S. PUBLIC LAND SURVEY MONUMENT RECORD

SECTION 36 T 16 N, R 7 W, TOWN OF MEDARY
LACROSSE COUNTY

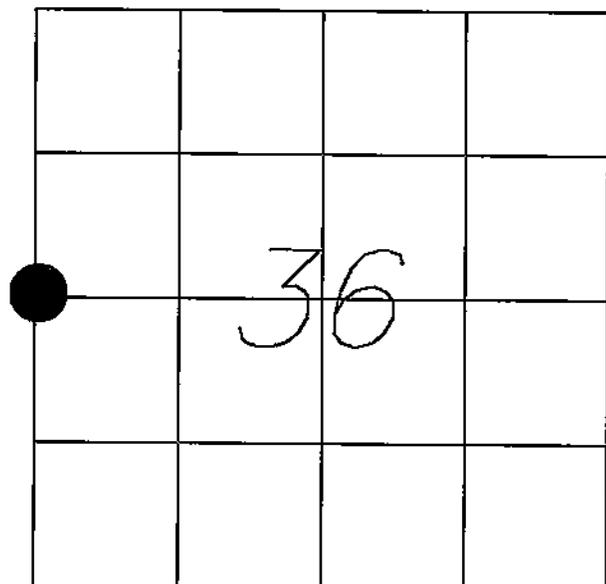

LOCATION OF LANDMARK

CREW: *SCOTT DUNNUM*DATE: *11/04/01*

Describe any record evidence, monument evidence, testimonial evidence, or any other material evidence you considered and whether the monument was found or restored through acceptance of an obliterated evidence location.

*I found a 1 inch iron pipe by the intersecting fences.
 This pipe has been used in previous surveys as the corner.*

Describe or show any material discrepancy between the location of the restored corner and that of the corner previously restored or reestablished.

NONE KNOWN

WISCONSIN COORDINATE SYSTEM

North

East

Theta Angle

Horiz. Order

Vert. Order

TYPE OF LANDMARK


1" IP

BEARINGS ARE REFERENCED TO


*The West line of the NW 1/4, 36-16-7
 previously recorded as N 01°46'05" W*

RECORD OF DURABLE WITNESS MONUMENTS

NO	DESCRIPTION	BEARING	DISTANCE
1	P.K. NAIL IN 16" EVERGREEN (UNBLAZED)	S 80° E	71.5 FT.
2	P.K. NAIL IN 12" EVERGREEN (UNBLAZED)	S 50° W	93.0 FT.
3	P.K. NAIL IN 12" CHERRY (UNBLAZED)	N 78° W	18.9 FT.
4	P.K. NAIL IN 11" WHITE OAK (UNBLAZED)	N 26° W	30.6 FT.

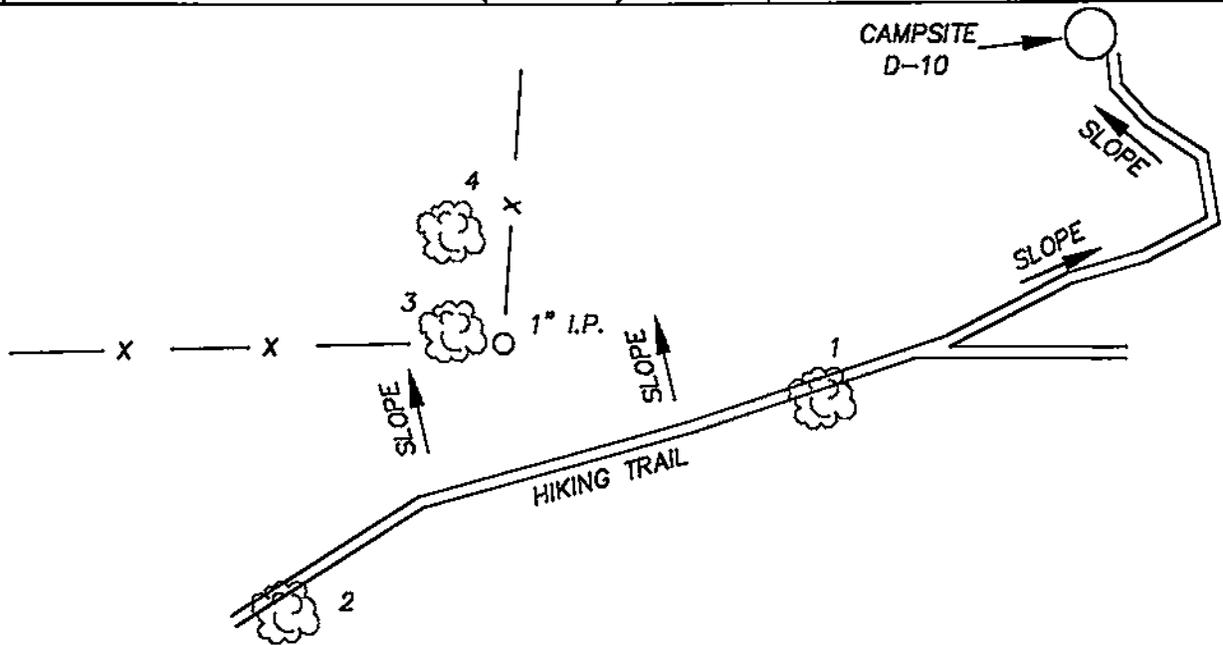


MAP SHOWING DISTANCE AND DIRECTION TO OTHER PUBLIC LAND SURVEY CORNERS USED FOR REESTABLISHING THE CORNER

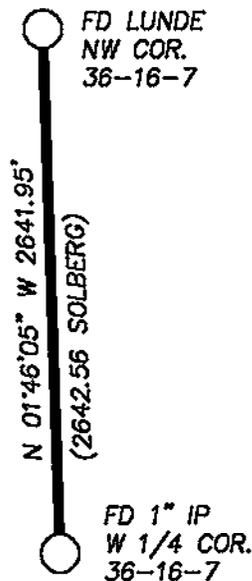

I, Scott M. Dunnun RLS# 2485

HEREBY CERTIFY THAT THE CORNER LOCATION SHOWN ON THIS RECORD WAS DETERMINED BY ME OR UNDER MY DIRECTION AND CONTROL AND THAT THIS U. S. PUBLIC LAND SURVEY MONUMENT RECORD IS CORRECT AND COMPLETE TO THE BEST OF MY KNOWLEDGE AND BELIEF.

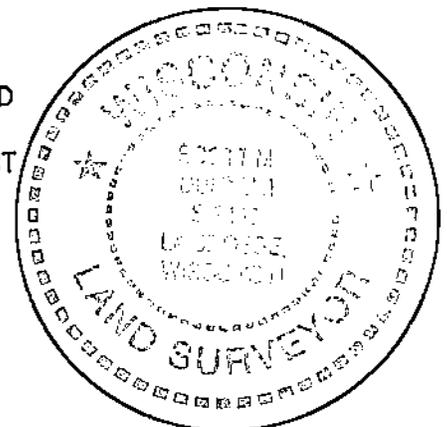

Scott M. Dunnun
Signature

12/9/02
Date

Seal