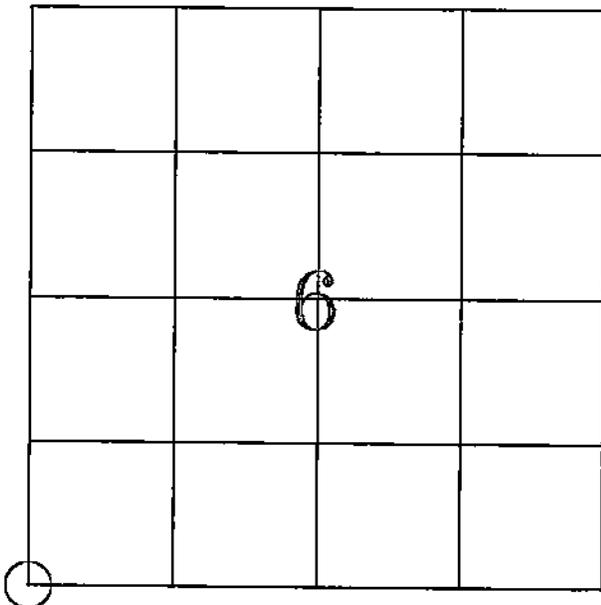


U. S. PUBLIC LAND SURVEY MONUMENT RECORD

SECTION 6, TOWNSHIP 16 NORTH, RANGE 7 WEST

CITY of LA CROSSE
LA CROSSE COUNTY, WISCONSIN

COORDINATE SYSTEM
NORTHING
EASTING
THETA ANGLE
HORIZ. ORDER
VERT. ORDER
TYPE OF MONUMENT Punch mark on M.H. lid
BEARINGS ARE REFERENCED TO: Grid (GPS) Bearings

Describe any record evidence, monument evidence, testimonial evidence or any other material evidence you considered and whether the monument was found or restored through acceptance of an obliterated evidence location.

Corner lies on M.H. lid. Found two of four pk ties from Graham (1984).

Found one of two Bernsten ties from Clark (1967). All other Clark ties destroyed.

South line distance of 5,243.10' matches well to Clark's 5,243.18'.

West line of SW $\frac{1}{4}$ at 2651.85' compares with Harding(2651.99'), Burt(2652.08'), & Graham(2651.81').

Describe or show any material discrepancy between the location of the restored corner and that of the corner previously restored or reestablished.

Missed Clark's tie to Bernsten by 0.16' in 40.00'.


SECTION 6, TOWNSHIP 16 NORTH, RANGE 7 WEST

REFERENCE TIES


#	DESCRIPTION	BEARING	DISTANCE
1	Bernsten Monument	N 51° W	39.84'
2	2" Iron Pipe	N 56° E	58.49'
3	2" Iron Pipe	S 55° E	58.31'
4	2" Iron Pipe	S 34° E	58.22'

☐ = PK nail in P.P. (auxiliary)


PLAN VIEW OF REFERENCE TIES

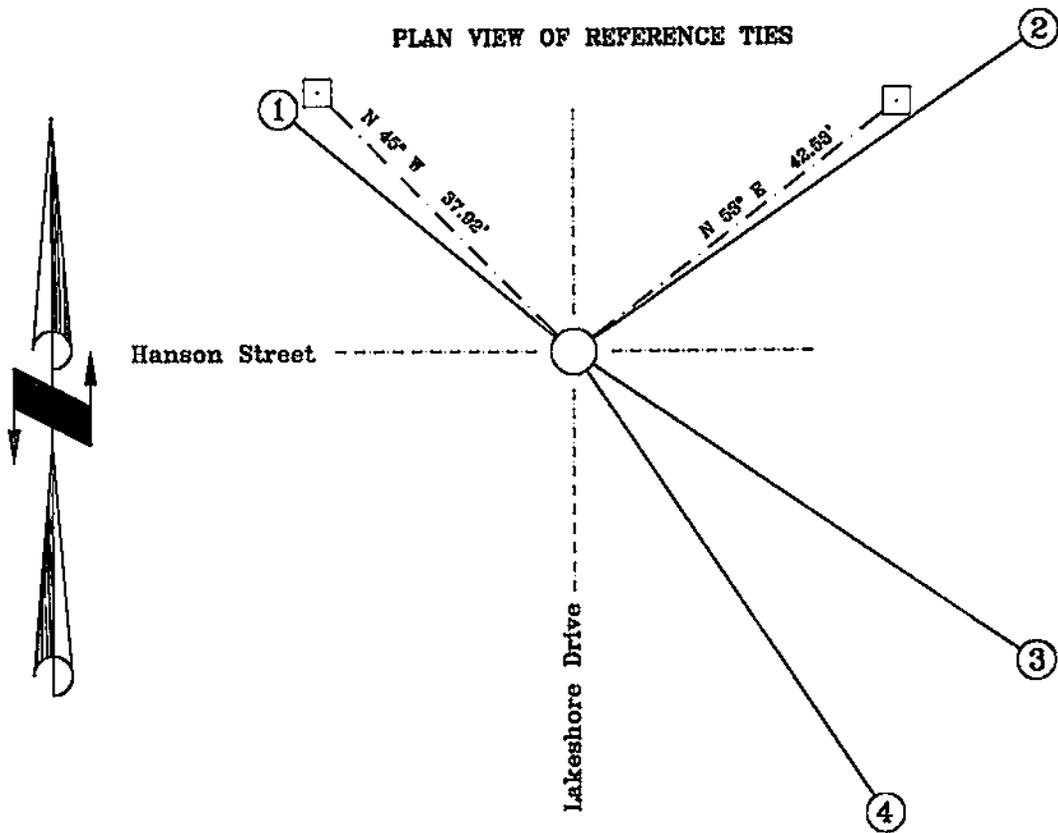

DISTANCE AND DIRECTION TO OTHER P.L.S.S. CORNERS USED

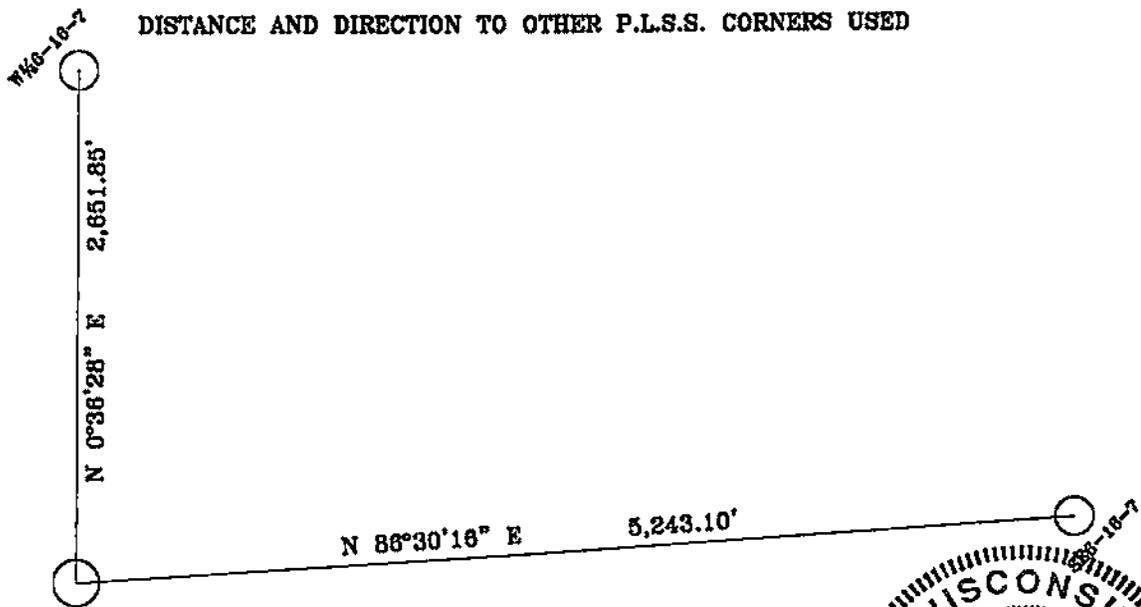


I, DAVID J. KARL, WISCONSIN REGISTERED SURVEYOR #2136 CERTIFY THAT THE CORNER LOCATION SHOWN ON THIS RECORD WAS RESET OR DETERMINED BY ME OR UNDER MY DIRECTION AND CONTROL. I FURTHER CERTIFY THAT THIS DOCUMENT IS CORRECT AND COMPLETE TO THE BEST OF MY KNOWLEDGE.

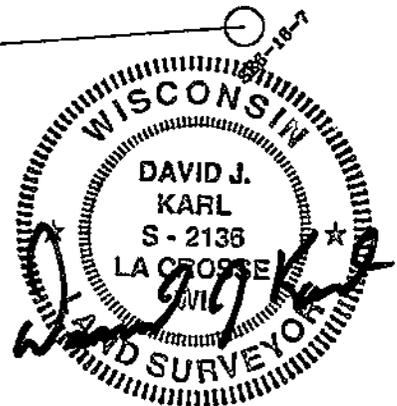

2-15-2001

U. S. PUBLIC LAND SURVEY MONUMENT RECORD

SECTION 7 T 16 N, R 7 W, TOWN OF CAMPBELL AND
 LA CROSSE COUNTY CITY OF LACROSSE.

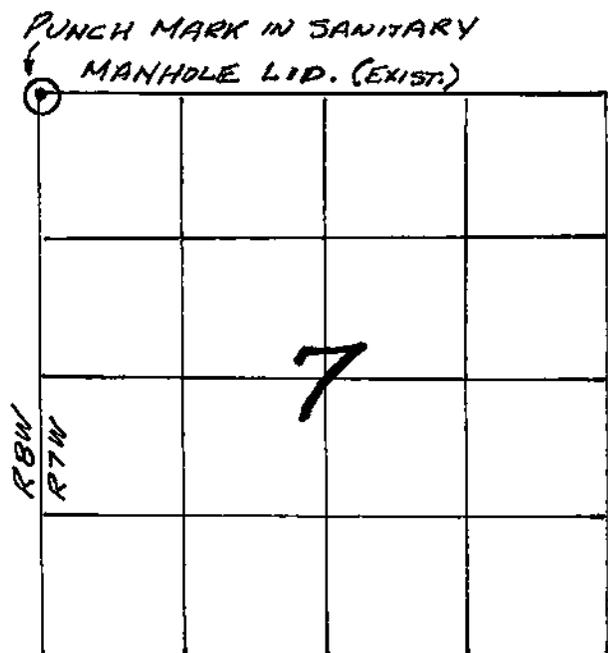

LOCATION OF LANDMARK

WISCONSIN COORDINATE SYSTEM
North
East
Theta Angle
Horiz. Order
Vert. Order
TYPE OF LANDMARK
<u>PUNCH MARK IN SAN. M. H. LID.</u>
BEARINGS ARE REFERENCED TO
<u>SEE → ENCLOSED SURVEY OF SECTION 7.</u>

Describe any record evidence, monument evidence, testimonial evidence or any other material evidence you considered and whether the monument was found or restored through acceptance of an obliterated evidence location.


DAVY ENGR. CO., LA CROSSE, WIS., TIED OUT U.S.C.E. MONUMENT AT THIS LOCATION BEFORE SANITARY SEWER WAS CONSTRUCTED. D.O.T. (WIS.) (?) SET BERNTSEN REFERENCE MONUMENTS AS SHOWN AFTER SAN. SEWER AND STREET CONSTRUCTION, 1976±.

Describe or show any material discrepancy between the location of the restored corner and that of the corner previously restored or reestablished.

N/A.

RECORD OF DURABLE WITNESS MONUMENTS

NO	DESCRIPTION	BEARING	DISTANCE
1	"BERNTSEN" MON'T. "OFF 41'" "REF. PT." "1976"	S-E'LY.	40.94'
2	"BERNTSEN" MON'T. "OFF 40'" "REF. PT." "1976"	N-W'LY.	40.00'
3	NAIL & TAB.	W'LY.	42.26'
4	NAIL & TAB.	W'LY.	78.25'

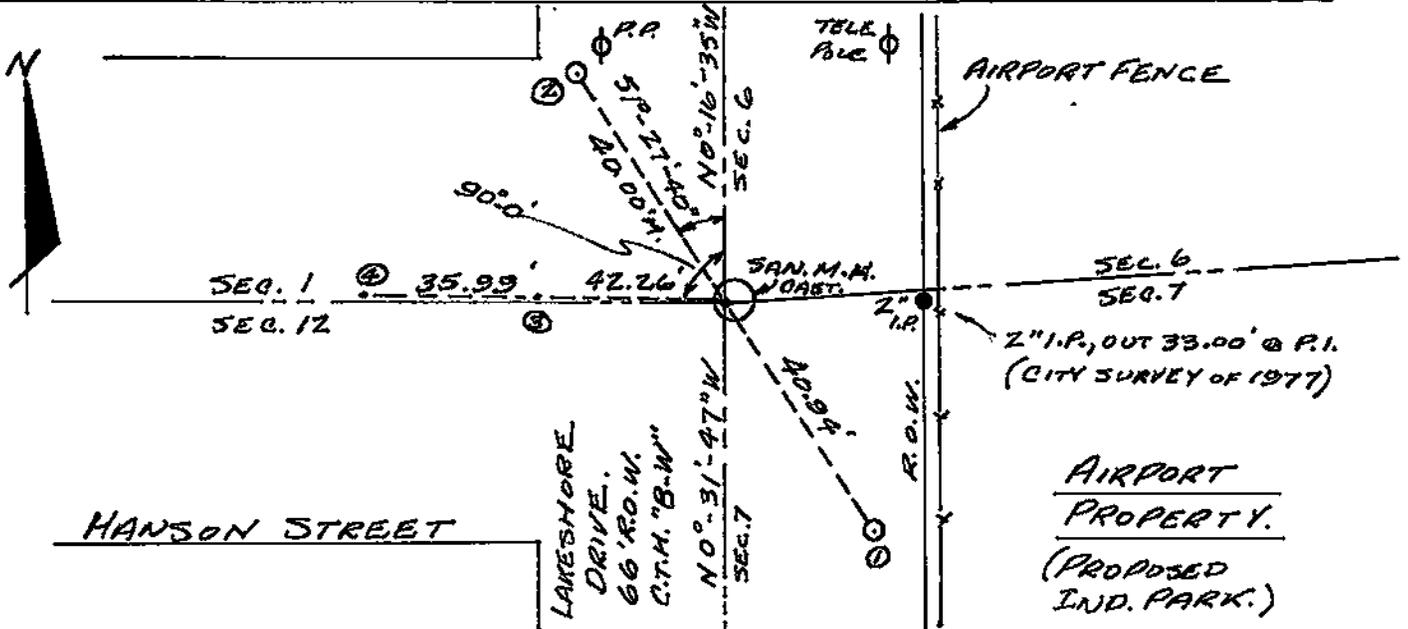

PLAN VIEW DRAWING OF REFERENCE TIES



MAP SHOWING DISTANCE AND DIRECTION TO OTHER PUBLIC LAND SURVEY CORNERS USED FOR REESTABLISHING THE CORNER

SEE → ENCLOSED SURVEY OF SECTION 7, T16N, R7W, 4TH P.M., CITY OF LA CROSSE, LA CROSSE COUNTY, WISCONSIN.

I, WILBUR L. CLARK, ENGR. DEPT., CITY OF LA CROSSE, HEREBY CERTIFY THAT THE CORNER LOCATION SHOWN ON THIS RECORD WAS DETERMINED BY ME* OR UNDER MY DIRECTION AND CONTROL AND THAT THIS U. S. PUBLIC LAND SURVEY MONUMENT RECORD IS CORRECT AND COMPLETE TO THE BEST OF MY KNOWLEDGE AND BELIEF.

Wilbur L. Clark 1-22-1987.
Signature Date



Seal


* CORNER WAS EXISTING.

U. S. PUBLIC LAND SURVEY MONUMENT RECORD

INSTRUCTIONS: This record shall show the location of the corner and shall include all of the following nine elements (a through i).

- (a) Identify the corner by reference to the U.S. public land survey system.
- = Corner monument restored.

SE CORNER, SEC. 1,
T. 16 N., R. 8 W., 4TH P.M.,
LA CROSSE CO., WISC.

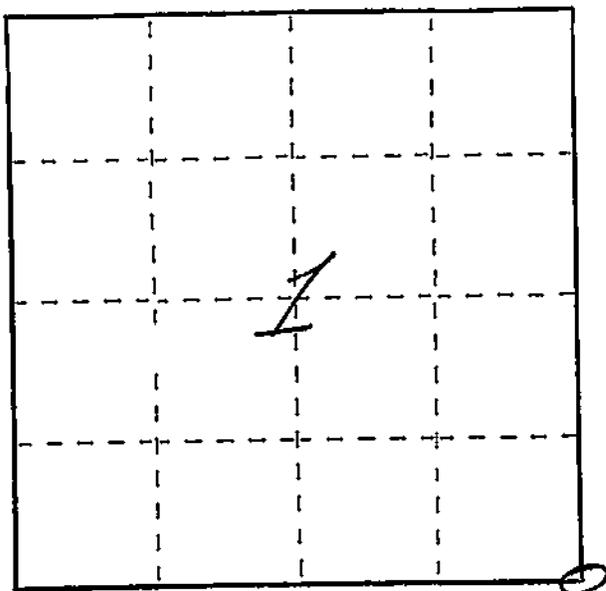


- (b) Describe any record evidence, monument evidence, occupational evidence, testimonial evidence or any other material evidence you considered, and whether the monument was found or placed.

FOUND CHISELED 'X' IN M.H. COVER PER PREVIOUS SURVEYS.

- (c) In the plan view drawing below, provide reference ties to at least 4 witness monuments, or, if the location is within a municipality, to at least 2 witness monuments. (Witness monuments shall be made of concrete, natural stone, iron or other equally durable material.) Describe witness monuments.

- (d) Show a plan view drawing depicting the relevant monuments and reference ties which is sufficient in detail to enable accurate relocation of the corner monument if the corner monument is disturbed. Indicate north.

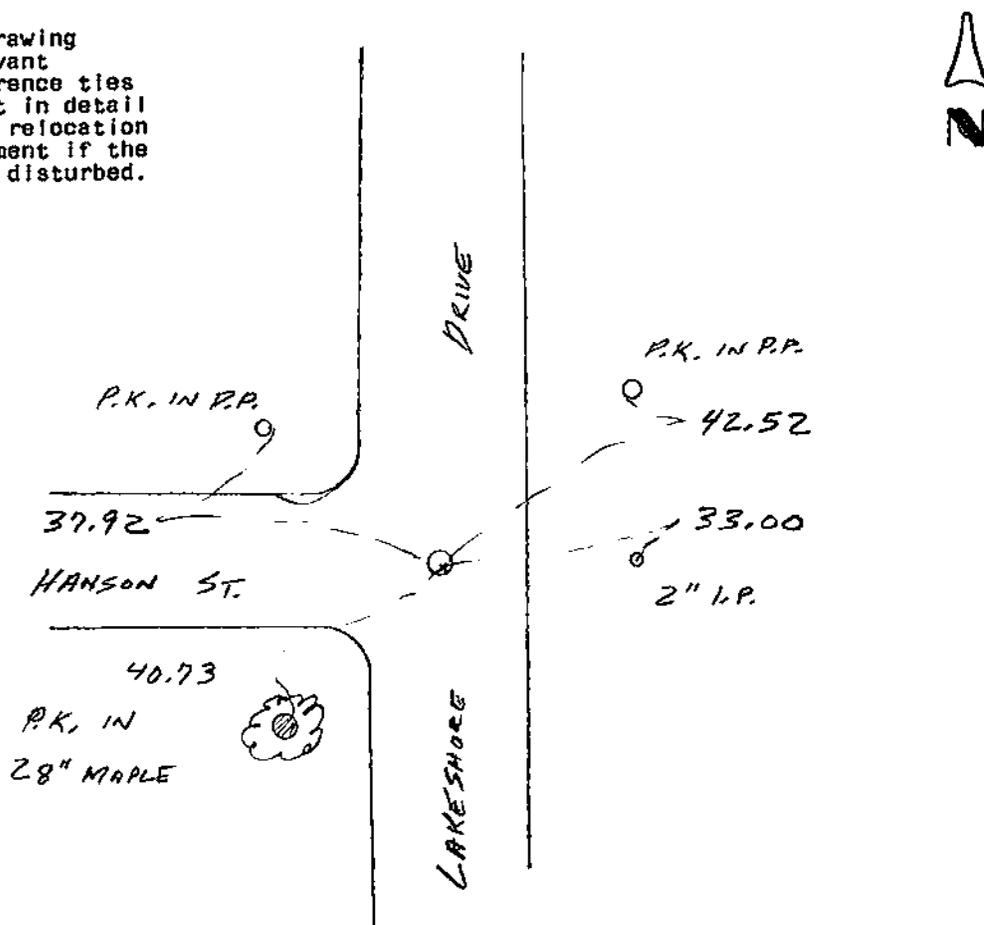

(e) Describe any material discrepancy between the location of the corner as restored or reestablished and the location of that corner as previously restored or reestablished by distance and direction. Show the discrepancy on the plan view drawing under (d), above. Show the distances between the corner as previously restored or reestablished and (1) the corner as restored or reestablished, and (2) to at least 2 of the witness monuments shown on the drawing in (d), above.

NONE

(f) Was the corner restored through acceptance of (1) an obliterated evidence location, or, (2) a found perpetuated location?

(g&h) Was the corner reestablished through lost corner proportionate methods? If so, show the method, including the directions and distances to other public land survey corners used as evidence or used for proportioning in determining the corner location?

No.

(i) I, KEITH M. GRAHAM
(type or print name) certify that the corner location shown on this record was determined by me or under my direction and control and that this U.S. Public Land Survey Monument Record is correct and complete to the best of my knowledge and belief.



Signature


Date

Keith M. Graham 12/30/85

FIELD SURVEY NOTES
PRESERVATION OF LANDMARKS
 (Pursuant to Section 59.635(7) Wisconsin Statutes)

State Highway Commission of Wisconsin
 Form E-D-707-65


COUNTY LA CROSSE		
TOWN CAMPBELL		
HIGHWAY C.T.H. "BW"		
SECTION 6	TOWNSHIP 16 N.	RANGE 7 W
TYPE OF LANDMARK WIS. D.O.T. CAST ALUMINUM WITNESS MONU.		

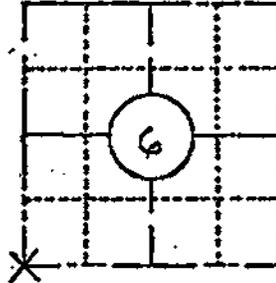

LOCATION SKETCH
 (Location of landmark indicated by "x")



This space for copy of field notes or ties to the above described landmarks

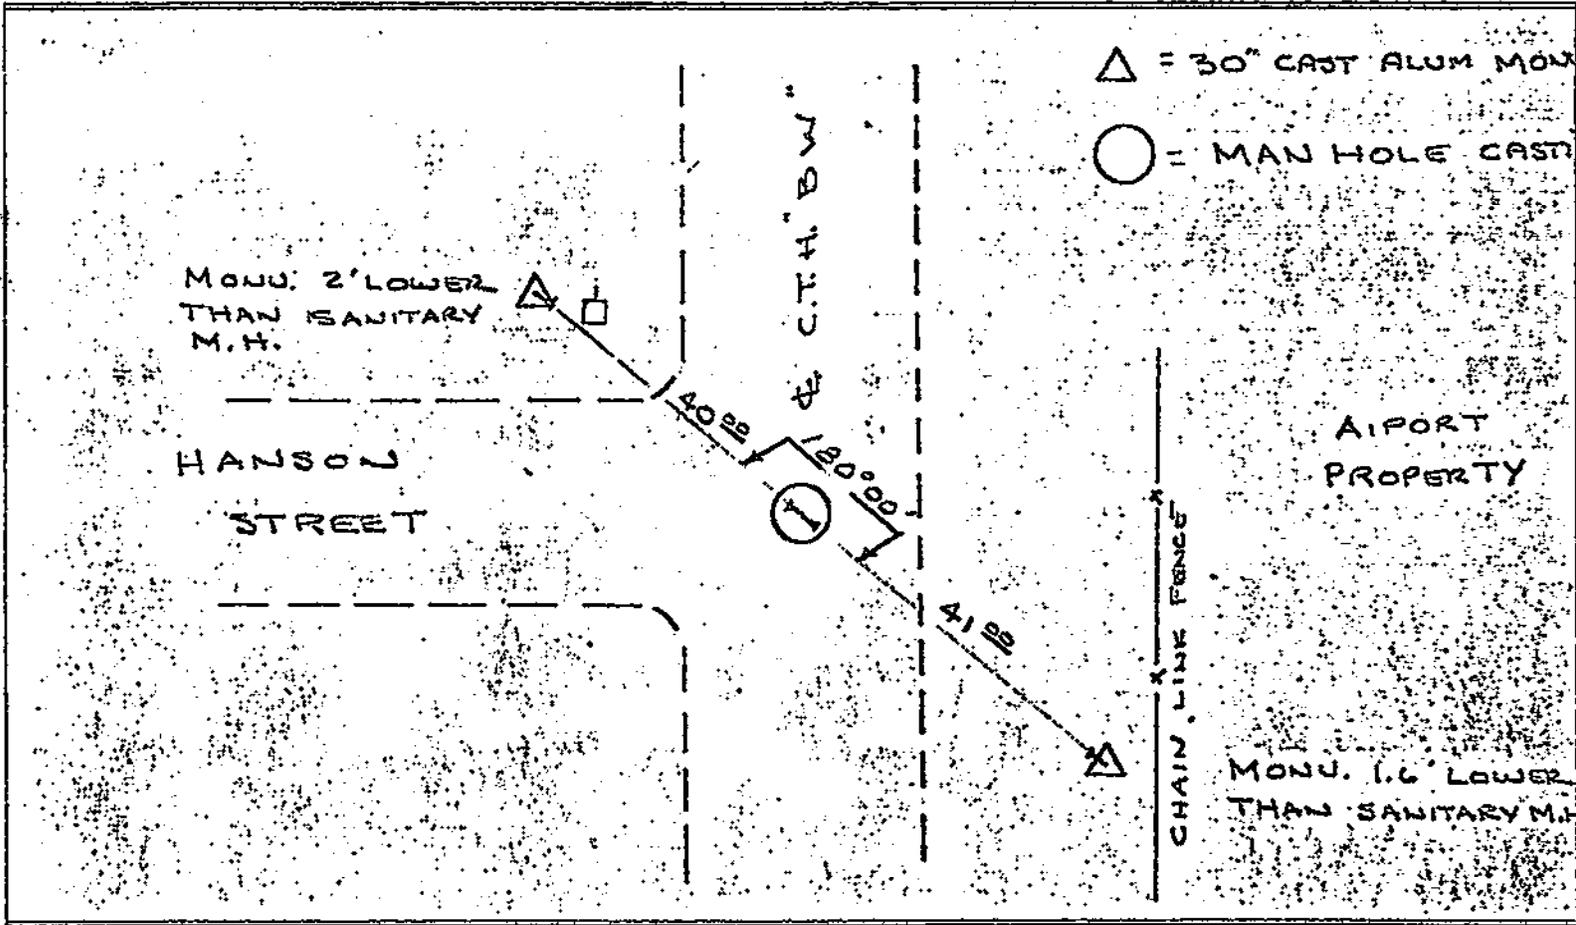

FILED UNDER PROJECT NUMBER			COUNTY CLERK'S OFFICE	
SNC DISTRICT OFFICE NUMBER 5			COUNTY OF LA CROSSE	WISCONSIN 83
CITY LACROSSE	COUNTY LACROSSE	DATE RECEIVED FOR RECORD	DATE COPY SENT TO COUNTY SURVEYOR	
LOCATED OR ESTABLISHED BY PERPETUATED NAME DERRALD E. KADING L.S. #1064			SIGNATURE OF COUNTY CLERK	
TITLE SURVEY COORDINATOR DATE 11-24-76				