


U. S. PUBLIC LAND SURVEY MONUMENT RECORD

SECTION 18 T 16 N, R 7 W, TOWN OF CAMPBELL  
 LA CROSSE COUNTY

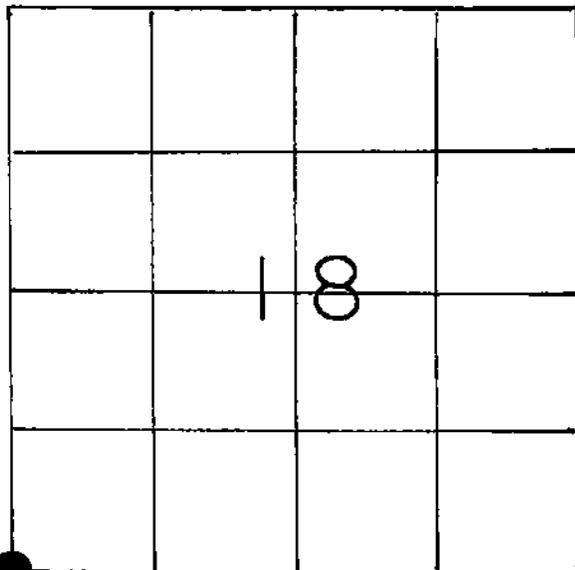

LOCATION OF LANDMARK

Crew: William C. Jung

Peter F. Follansbee

Date: 9/6/88

Describe any record evidence, monument evidence, testimonial evidence or any other material evidence you considered and whether the monument was found or restored through acceptance of an obliterated evidence location.

I set the corner so as to fit the E.C. Swarthout Addition and other plats of record.  
 (The corner falls in a slough. Offset pipes were set.)


Describe or show any material discrepancy between the location of the restored corner and that of the corner previously restored or reestablished.

None known.

WISCONSIN COORDINATE SYSTEM
North
East
Theta Angle
Horiz. Order
Vert. Order
TYPE OF LANDMARK
Computed location with offsets
BEARINGS ARE REFERENCED TO
Assumed

RECORD OF DURABLE WITNESS MONUMENTS

NO	DESCRIPTION	BEARING	DISTANCE
1	Set 1 1/4" iron pipe on line	N86°19'E	29.01
2	Set 1 1/4" iron pipe on line	N86°19"E	70.24
3	Set a Berntsen top in an existing iron pipe	N86°19"E	229.80
4	P.K. nail at the "40" corner	N86°19'E	1267.35

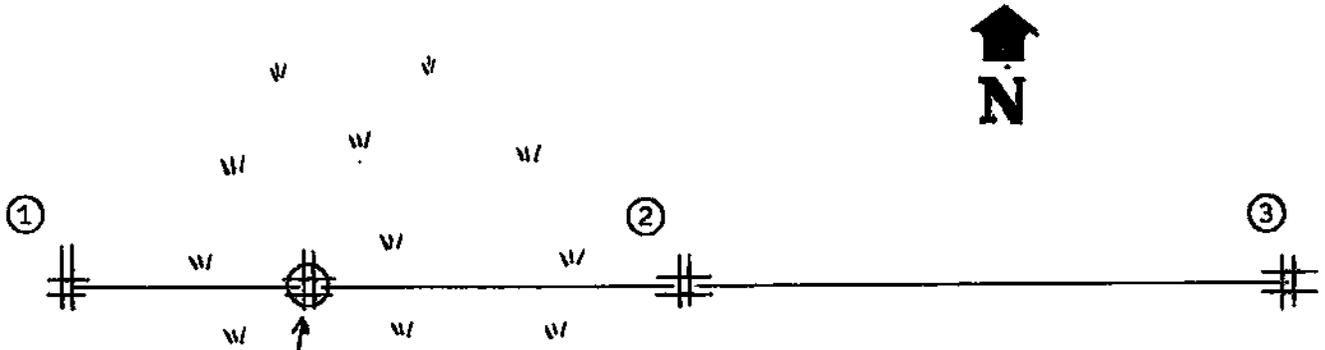


The corner falls in the slough. I searched for but could not find the old Corps marker. John Dawson told me that a Mr. Gilster told him that "some kids" took it out years ago. I did not set another marker but set offset pipes instead.

PLAN VIEW DRAWING OF REFERENCE TIES

MAP SHOWING DISTANCE AND DIRECTION TO OTHER PUBLIC LAND SURVEY CORNERS USED FOR REESTABLISHING THE CORNER

(not to scale)

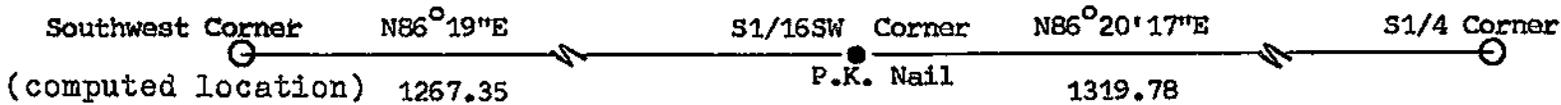

I, William C. Jung, Deputy County Surveyor  
 HEREBY CERTIFY THAT THE CORNER LOCATION SHOWN ON THIS RECORD  
 WAS DETERMINED BY ME OR UNDER MY DIRECTION AND CONTROL AND  
 THAT THIS U. S. PUBLIC LAND SURVEY MONUMENT RECORD IS CORRECT  
 AND COMPLETE TO THE BEST OF MY KNOWLEDGE AND BELIEF.

William C. Jung  
 Signature

September 9, 1988  
 Date



Seal