


21707320000

U. S. PUBLIC LAND SURVEY MONUMENT RECORD

SECTION 4 T 16 N, R 7 W, CITY OF ONALASKA

LA CROSSE COUNTY

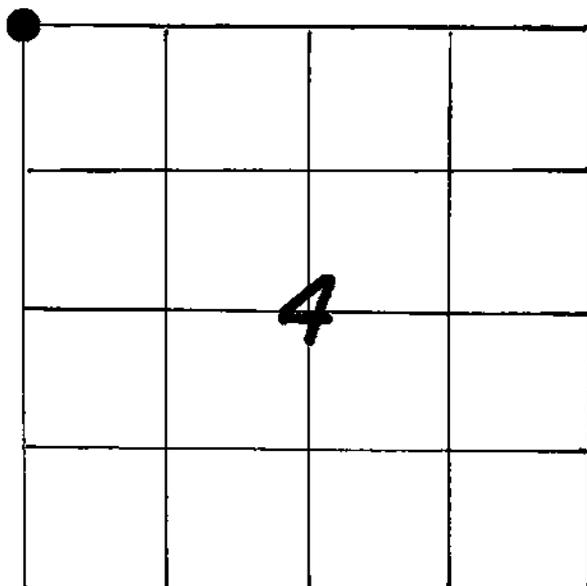

LOCATION OF LANDMARK

DATE: 11-26-85
 CREW: BILL JUNG
 PERRY DAHL

Revised:
 Date: 7-1-86
 Bill Woodman
 Bill Jung and Perry Dahl

WISCONSIN COORDINATE SYSTEM

North

East

Theta Angle

Horiz. Order

Vert. Order

TYPE OF LANDMARK

P.K. NAIL (replaced by Berntsen top)

BEARINGS ARE REFERENCED TO

Assumed

Describe any record evidence, monument evidence, testimonial evidence or any other material evidence you considered and whether the monument was found or restored through acceptance of an obliterated evidence location.


I found a P.K. nail at the corner. This point has been used in several previous surveys, so I accepted this position as the best available evidence of the original government corner.

Describe or show any material discrepancy between the location of the restored corner and that of the corner previously restored or reestablished.

None known.

RECORD OF DURABLE WITNESS MONUMENTS

| NO | DESCRIPTION | BEARING | DISTANCE |
|----|-------------------------|---------|----------|
| 1 | CENTER OF MANHOLE COVER | ----- | 9.47' |
| 2 | IRON PIPE, DOWN 3' | ----- | 33.08' |
| 3 | TOP OF FIRE HYDRANT | ----- | 26.18' |
| 4 | CENTER OF MANHOLE COVER | ----- | 152' |

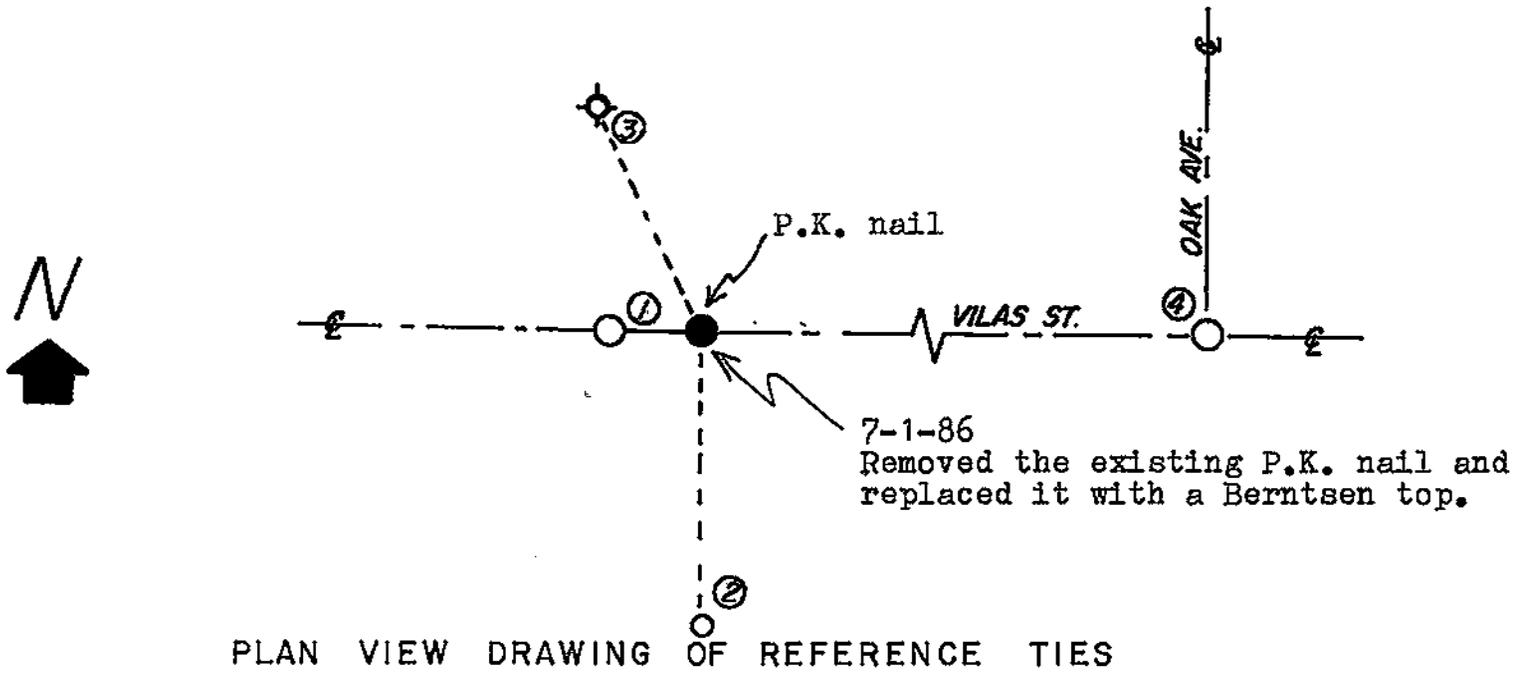


PLAN VIEW DRAWING OF REFERENCE TIES




MAP SHOWING DISTANCE AND DIRECTION TO OTHER PUBLIC LAND SURVEY CORNERS USED FOR REESTABLISHING THE CORNER

(not to scale)

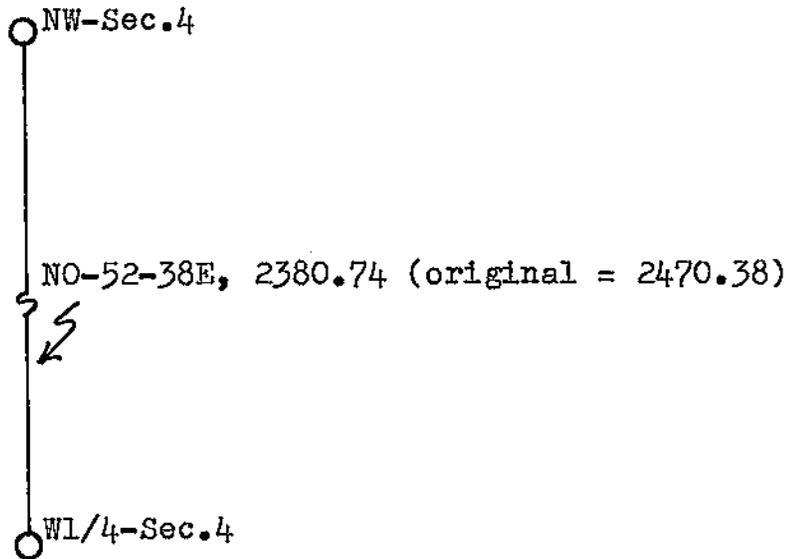

I, William C. Jung, Deputy County Surveyor,
 HEREBY CERTIFY THAT THE CORNER LOCATION SHOWN ON THIS RECORD
 WAS DETERMINED BY ME OR UNDER MY DIRECTION AND CONTROL AND
 THAT THIS U. S. PUBLIC LAND SURVEY MONUMENT RECORD IS CORRECT
 AND COMPLETE TO THE BEST OF MY KNOWLEDGE AND BELIEF.

William C. Jung 1/12/87
 Signature Date
 3/5/86

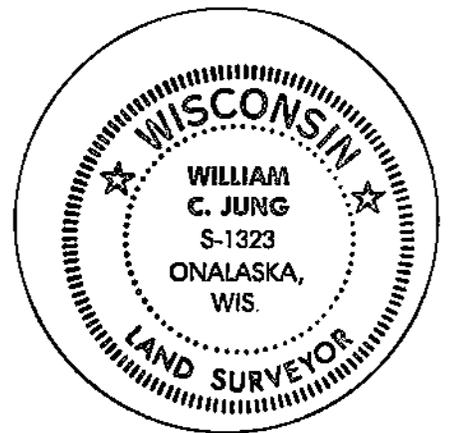

Seal