


## U. S. PUBLIC LAND SURVEY MONUMENT RECORD

SECTION 5 T 16 N, R 7 W, ~~TOWN~~ OF CITY OF ONALASKA

LA CROSSE COUNTY

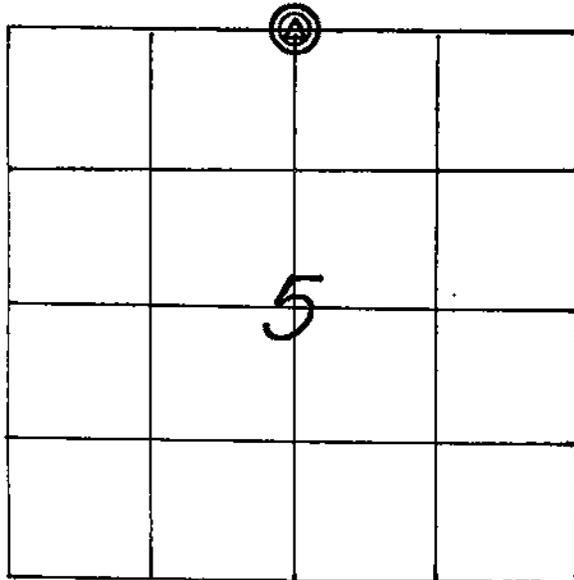

LOCATION OF LANDMARK

CREW: *WILLIAM C. JUNG*  
*PETER F. FOLLANSBEE*  
 DATE: *4/12/2004*

WISCONSIN COORDINATE SYSTEM

North

East

Theta Angle

Horiz. Order

Vert. Order

TYPE OF LANDMARK

*BRASS CAP CORP. OF ENG. MARKER. (3 1/2")*

BEARINGS ARE REFERENCED TO

Describe any record evidence, monument evidence, testimonial evidence or any other material evidence you considered and whether the monument was found or restored through acceptance of an obliterated evidence location.


On March 3, 1986, I found a U.S.E.O. (Corps) monument at the corner. This marker has been used as the corner in numerous surveys over the years. I took new ties to update my tie sheet.

Describe or show any material discrepancy between the location of the restored corner and that of the corner previously restored or reestablished.

*NONE KNOWN.*

RECORD OF DURABLE WITNESS MONUMENTS

NO	DESCRIPTION	BEARING	DISTANCE
1	N.W.-CORNER OF EXISTING 2"x1-1/2" ANGLE IRON, UP 17"	WESTERLY ±	242.29 FT.
2	N.E.-CORNER OF EDGE OF CONCRETE FOR GARAGE	S.-WESTERLY ±	SEE SKETCH
3	EXISTING 1" IRON BAR, FLUSH	WESTERLY ±	64.64 FT.
4	EXISTING 3/4" IRON BAR, FLUSH AND 0.4' NORTH OF LINE	WESTERLY ±	SEE SKETCH

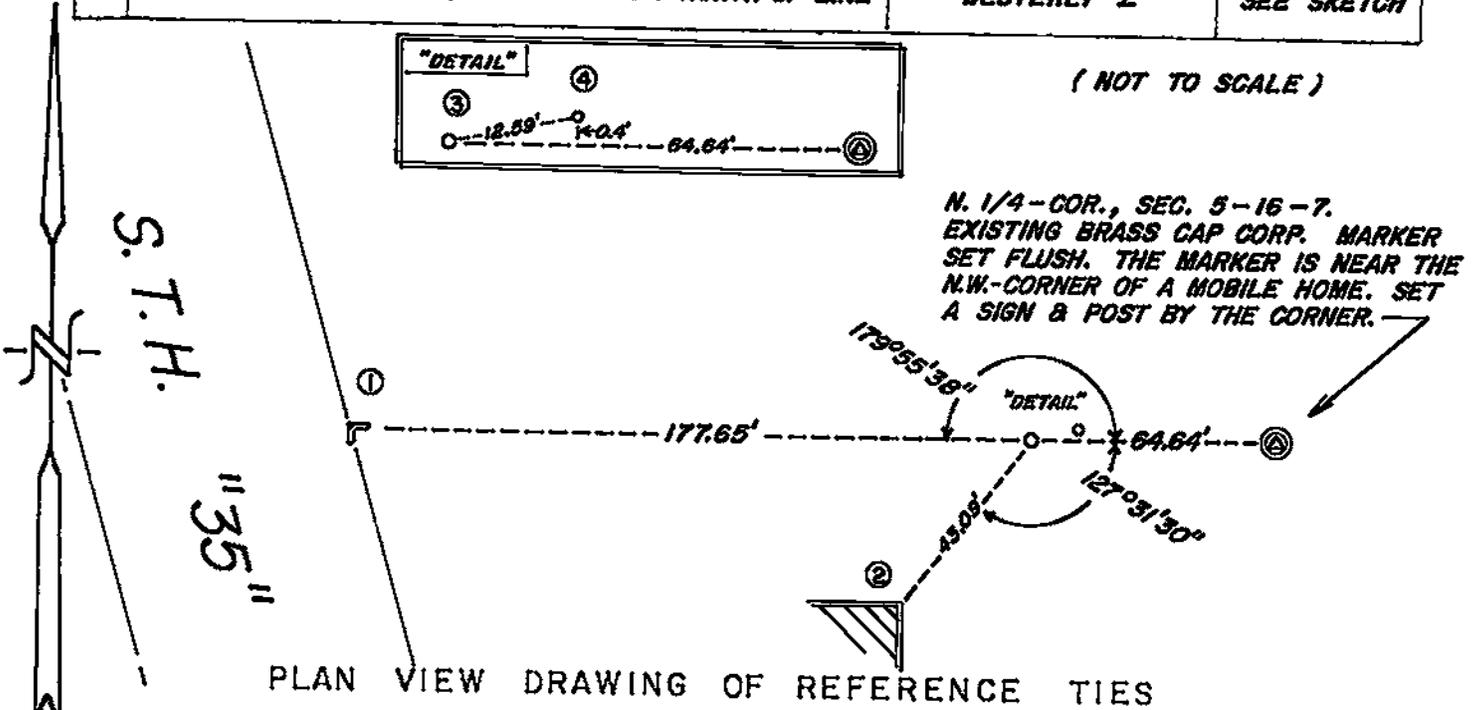

MAP SHOWING DISTANCE AND DIRECTION TO OTHER PUBLIC LAND SURVEY CORNERS USED FOR REESTABLISHING THE CORNER

I made no section measurements at this time. Numerous section measurements of record confirmed this corner location.


I, WILLIAM C. JUNG, COUNTY SURVEYOR  
HEREBY CERTIFY THAT THE CORNER LOCATION SHOWN ON THIS RECORD  
WAS DETERMINED BY ME OR UNDER MY DIRECTION AND CONTROL AND  
THAT THIS U. S. PUBLIC LAND SURVEY MONUMENT RECORD IS CORRECT  
AND COMPLETE TO THE BEST OF MY KNOWLEDGE AND BELIEF.

William C. Jung                      8/30/04  
Signature                                      Date



U. S. PUBLIC LAND SURVEY MONUMENT RECORD

SECTION 5 T 16 N, R 7 W, CITY OF ONALASKA  
 LA CROSSE COUNTY

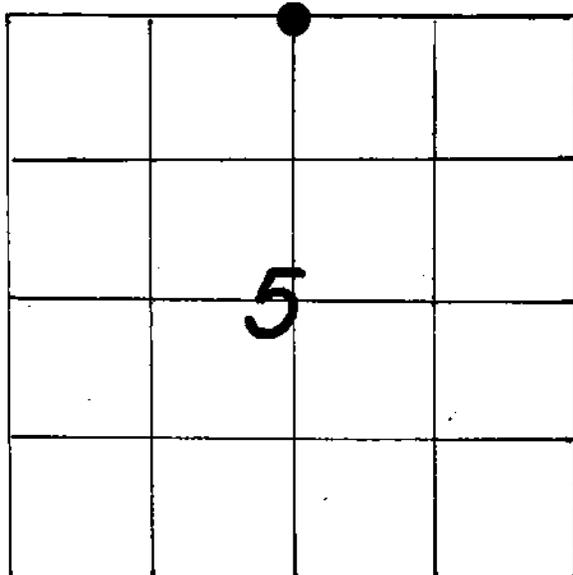

LOCATION OF LANDMARK

DATE: 3-3-86  
 CREW: BILL JUNG  
 PERRY DAHL

WISCONSIN COORDINATE SYSTEM
North
East
Theta Angle
Horiz. Order
Vert. Order
TYPE OF LANDMARK
3 1/2" Brass Capped Marker
BEARINGS ARE REFERENCED TO

Describe any record evidence, monument evidence, testimonial evidence or any other material evidence you considered and whether the monument was found or restored through acceptance of an obliterated evidence location.

I found a monument at the corner set by the U.S.E.O. This monument has been used in many surveys and as such was accepted as the corner.

Describe or show any material discrepancy between the location of the restored corner and that of the corner previously restored or reestablished.

None known.

