


21707330000

U. S. PUBLIC LAND SURVEY MONUMENT RECORD

SECTION 3 T 16 N, 7 R 7 W, TOWN OF Onalaska

LA CROSSE COUNTY

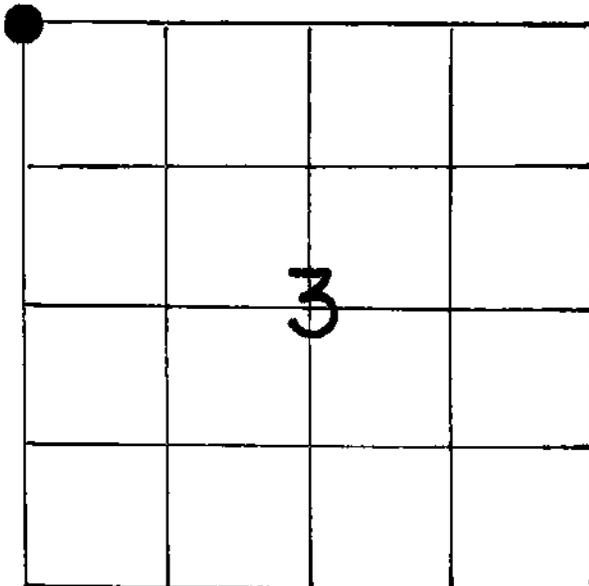

WISCONSIN COORDINATE SYSTEM
North
East
Theta Angle
Horiz. Order
Vert. Order
TYPE OF LANDMARK
Brass capped Lunde marker
BEARINGS ARE REFERENCED TO

LOCATION OF LANDMARK

Crew: William C. Jung, RLS  
James Logan, RLS

Date: 11/8/88

Witness: Michael Weibel  
Date: 11/11/88

Describe any record evidence, monument evidence, testimonial evidence or any other material evidence you considered and whether the monument was found or restored through acceptance of an obliterated evidence location.

The occupied fence corner had been accepted and used as the section corner in previous survey work. I could not find the old hub at the fence corner. I set the Lunde marker on the Southwest side of the corner post. Ray Pelishek said that this was where he and Murphy had the corner. Mike Weibel and I measured West and found that the original call of 11 chains to the top of the bluff fit perfectly. I accepted the fence corner as the best available evidence of the original government corner position. I buried a whiskey bottle with an empty M-16 cartridge as a memorial to the Northwest of the Lunde. I also placed a field stone

Describe or show any material discrepancy between the location of the restored corner and that of the corner previously restored or reestablished. to the SW  
of the  
Lunde.

None known.


4/5/00

Fd the Lunde in good condition. All (4) B.T.'s are in. Set a sign and post. The field to the SW is now wooded.

*mclg*

RECORD OF DURABLE WITNESS MONUMENTS  
Magnetic

NO	DESCRIPTION	BEARING	DISTANCE
1	P.K. nail in single blazed 28" white oak	N58°W	9.55
2	P.K. nail in double blazed 18" white oak	N34°W	70.30
3	" " " " " 14" hickory	N10°E	32.52
4	" " " " " 10" hickory	N48°E	59.60

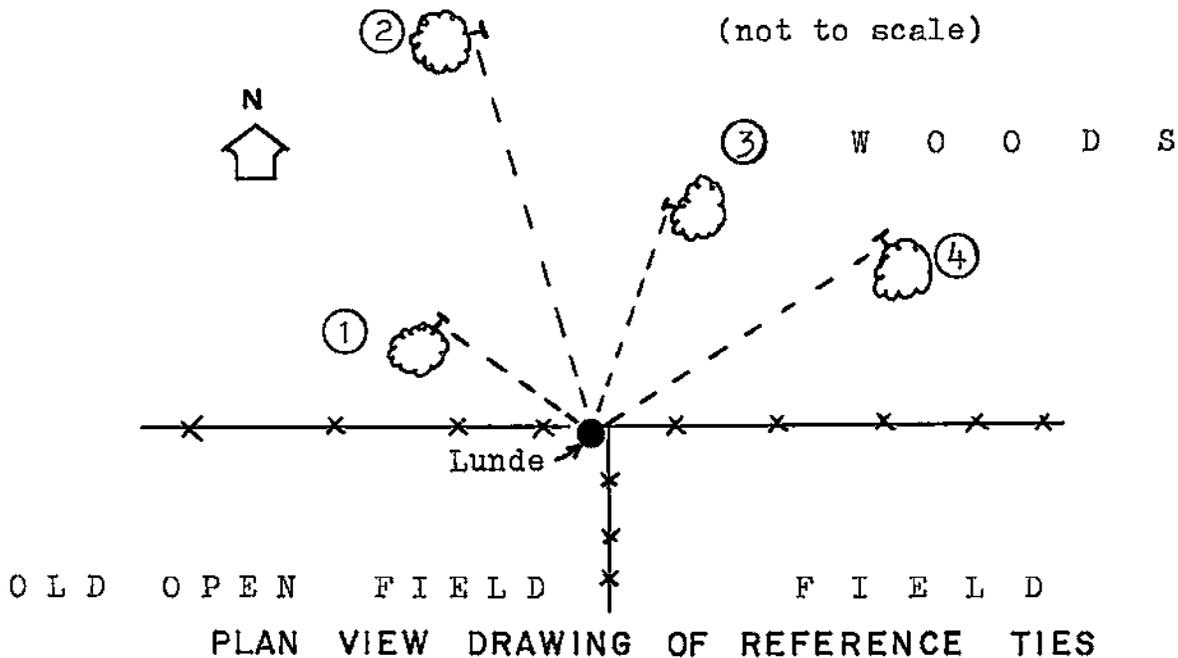


MAP SHOWING DISTANCE AND DIRECTION TO OTHER PUBLIC LAND SURVEY CORNERS USED FOR REESTABLISHING THE CORNER

(no measurements made by me at this time)

I, William C. Jung, Deputy County Surveyor,  
HEREBY CERTIFY THAT THE CORNER LOCATION SHOWN ON THIS RECORD  
WAS DETERMINED BY ME OR UNDER MY DIRECTION AND CONTROL AND  
THAT THIS U. S. PUBLIC LAND SURVEY MONUMENT RECORD IS CORRECT  
AND COMPLETE TO THE BEST OF MY KNOWLEDGE AND BELIEF.

William C. Jung  
Signature

1/13/89  
Date

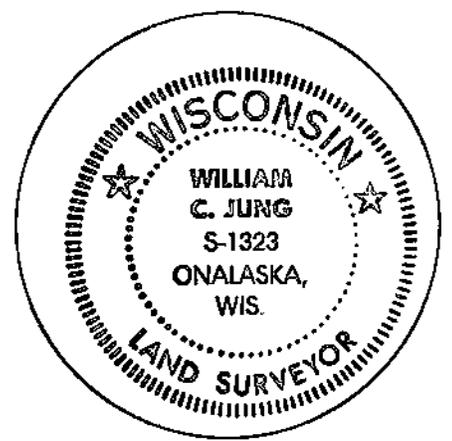

Seal