


U. S. PUBLIC LAND SURVEY MONUMENT RECORD

SECTION 3 T 16 N, R 7 W, TOWN OF ONALASKA

LA CROSSE COUNTY

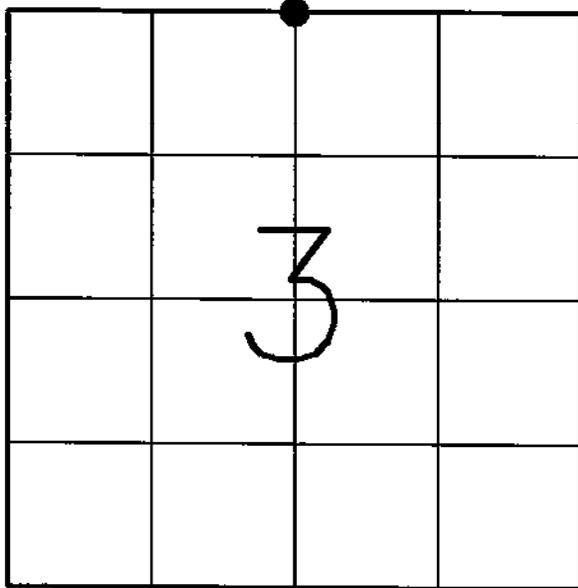

LOCATION OF LANDMARK

WISCONSIN COORDINATE SYSTEM	
NORTH	163103.62
EAST	458704.57
THETA ANGLE	
HORIZ. ORDER	
VERT. ORDER	
TYPE OF LANDMARK	

BEARINGS ARE REFERENCE TO
LA CROSSE COUNTY COORDINATE SYSTEM
(UNLESS OTHERWISE NOTED)

DESCRIBE ANY RECORDED EVIDENCE, MONUMENT EVIDENCE, TESTIMONIAL EVIDENCE, OR ANY OTHER MATERIAL EVIDENCE YOU CONSIDERED AND WHETHER THE MONUMENT WAS FOUND OR RESTORED THROUGH ACCEPTANCE OF AN OBLITERATED EVIDENCE LOCATION.



PREVIOUSLY SURVEYED LUNDE MARKER AT QUARTER CORNER WAS DESTROYED DURING RE-CONSTRUCTION OF GREEN COULEE ROAD. WE RE-SET CORNER AT PREVIOUS LOCATION.

DESCRIBE OR SHOW ANY MATERIAL DISCREPANCY BETWEEN THE LOCATION OF THE RESTORED CORNER AND THAT OF THE CORNER PREVIOUSLY RESTORED OR REESTABLISHED.

NONE

RECORD OF DURABLE WITNESS MONUMENT

NO	DESCRIPTION	BEARING	DISTANCE
1	1 1/4 IRON BAR (PLAT BLOCK CORNER)	S 70°49'06"W	59.16
2	SET 3/4" IRON BAR AT TOP BACK OF CURB	S 11°13'36" W	41.10
3	3/4" IRON BAR (PLAT P.C.)	N 33°40'18" E	118.89
4	SET 3/4" IRON BAR AT TOP BACK OF CURB	N 59°24'13" E	115.88

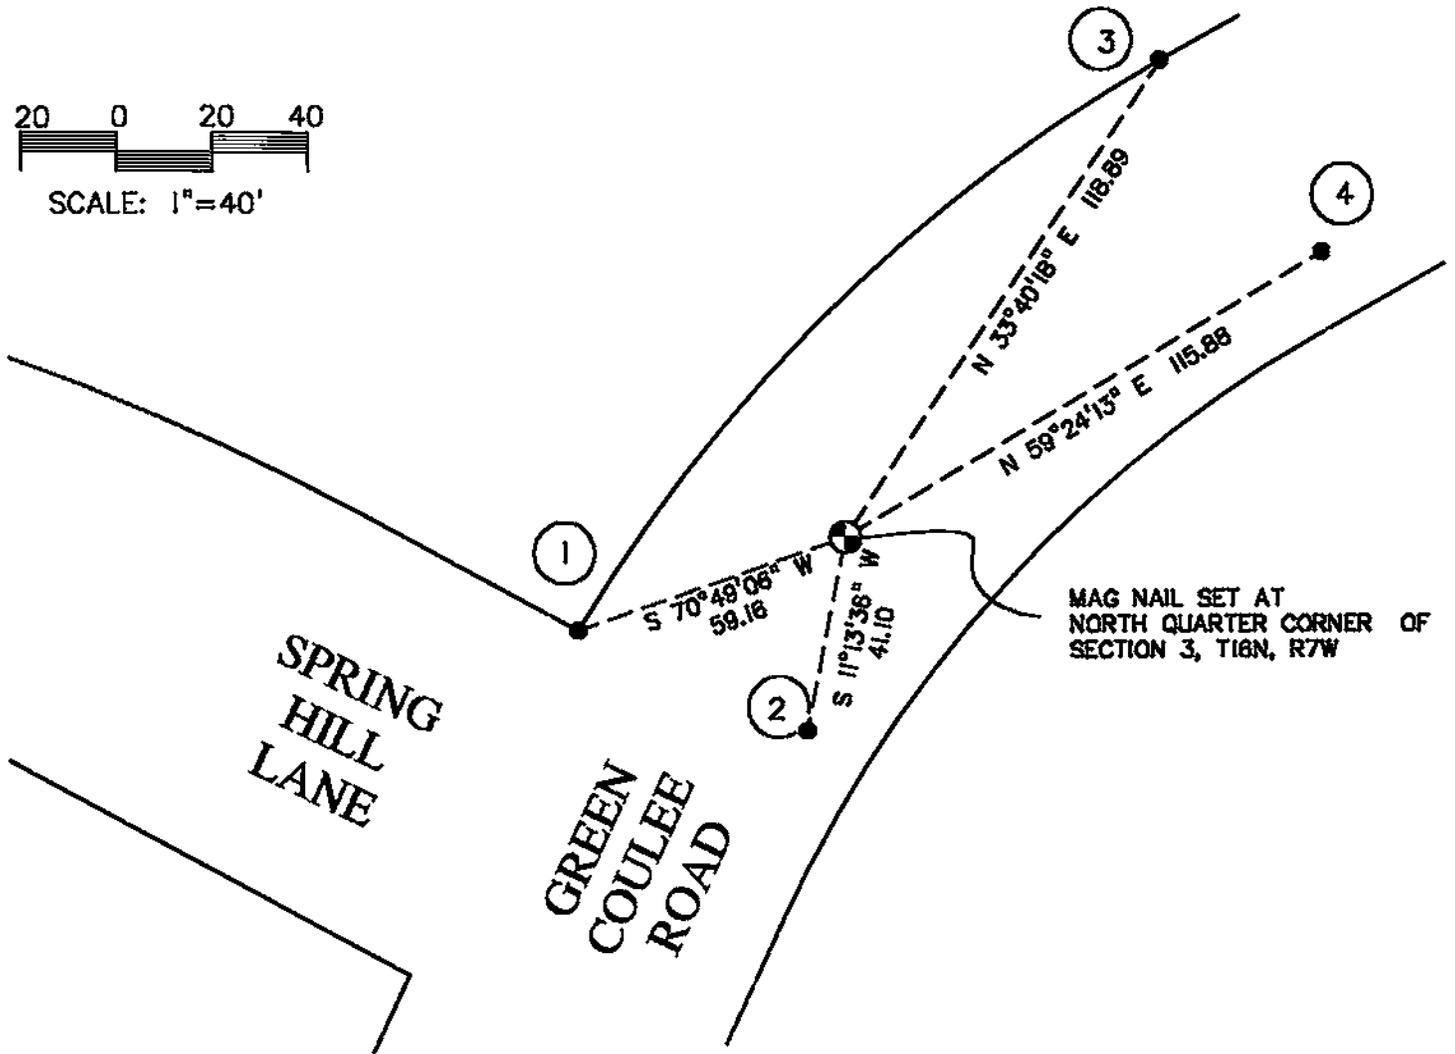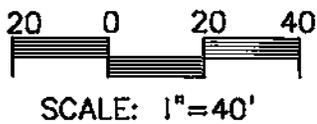


PLAN VIEW DRAWING OF REFERENCE TIES

MAP SHOWING DISTANCE AND DIRECTION TO OTHER PUBLIC LAND SURVEY CORNER USED FOR REESTABLISHING THE CORNER.

I, PAUL E. FAIRCHILD HEREBY CERTIFY THAT THE CORNER LOCATION SHOWN ON THIS RECORD WAS DETERMINED BY ME OR UNDER MY DIRECTION AND CONTROL AND THAT THIS U.S. PUBLIC LAND SURVEY MONUMENT IS CORRECT AND COMPLETE TO THE BEST OF MY KNOWLEDGE AND BELIEF.


Paul E. Fairchild
SIGNATURE

12/27/07
DATE

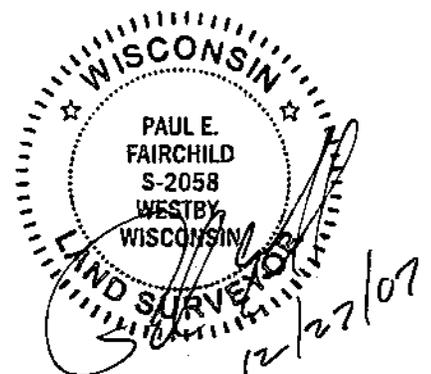

U. S. PUBLIC LAND SURVEY MONUMENT RECORD

SECTION 3 T 16 N, R 7 W, TOWN OF ONALASKA
LA CROSSE COUNTY

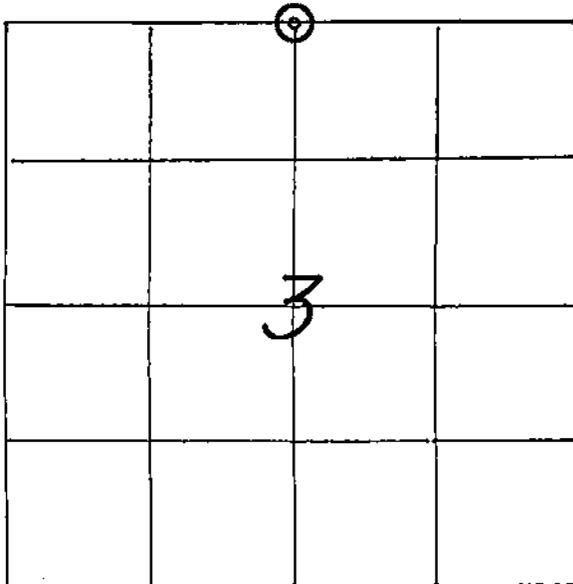

LOCATION OF LANDMARK

CREW: **WILLIAM C. JUNG**
PETER F. FOLLANSBEE
DATE: **6/29/1999**

WISCONSIN COORDINATE SYSTEM
North
East
Theta Angle
Horiz. Order
Vert. Order
TYPE OF LANDMARK
P.K. NAIL OVER ROTTED BERNTSEN.
BEARINGS ARE REFERENCED TO

Describe any record evidence, monument evidence, testimonial evidence or any other material evidence you considered and whether the monument was found or restored through acceptance of an obliterated evidence location.


We found the Berntsen marker partially rotted. We repacked the hole and set a P.K. nail over the marker.

Describe or show any material discrepancy between the location of the restored corner and that of the corner previously restored or reestablished.

NONE KNOWN.

RECORD OF DURABLE WITNESS MONUMENTS

NO	DESCRIPTION	BEARING	DISTANCE
1	EXISTING IRON PIPE ON R/W (DOWN 14"s)	WEST ±	44.04 FT.
2	N.E.-COR. OF 2-1/2' x 3-1/4' PAD FOR "ALPHA" UTILITY BOX	S. WESTERLY ±	60.79 FT.
3	NORTHERLY CORNER OF BARN AT GROUND	S 15° W (MAG.)	SLOPE = 154.85'
4	WESTERLY CORNER OF SHED (WOOD CORNER)	S 63-1/2° E (MAG.)	SLOPE = 54.98'

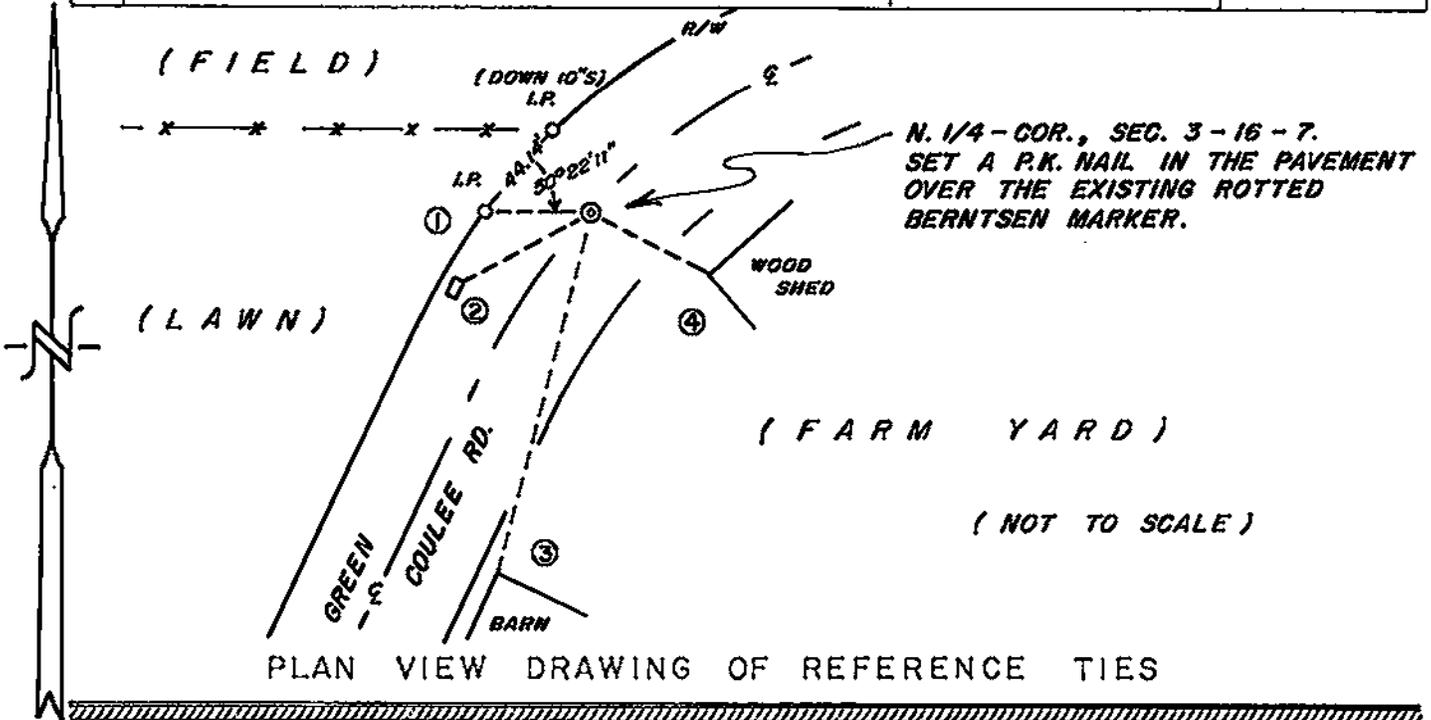

MAP SHOWING DISTANCE AND DIRECTION TO OTHER PUBLIC LAND SURVEY CORNERS USED FOR REESTABLISHING THE CORNER

No section measurements were made by me at this time. The location of this marker was confirmed previously by others.

I, WILLIAM C. JUNG, COUNTY SURVEYOR
HEREBY CERTIFY THAT THE CORNER LOCATION SHOWN ON THIS RECORD WAS DETERMINED BY ME OR UNDER MY DIRECTION AND CONTROL AND THAT THIS U. S. PUBLIC LAND SURVEY MONUMENT RECORD IS CORRECT AND COMPLETE TO THE BEST OF MY KNOWLEDGE AND BELIEF.

William C. Jung 7/20/99
Signature Date



Seal