


U. S. PUBLIC LAND SURVEY MONUMENT RECORD

SECTION 1 T 16 N, R 7 W, TOWN OF MEDARY
LA CROSSE COUNTY

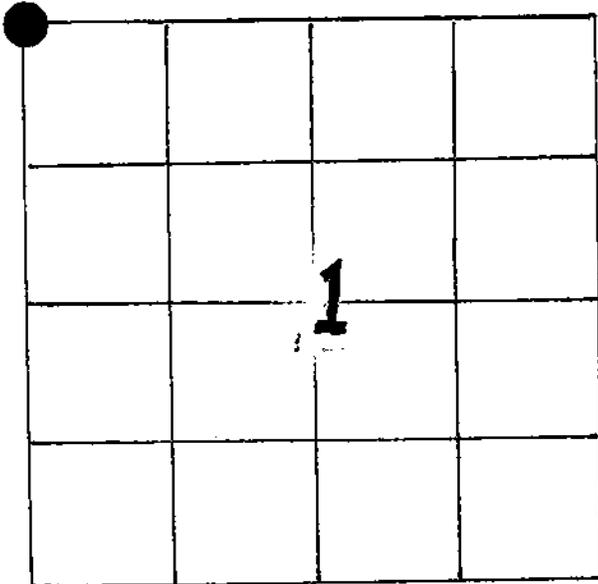

LOCATION OF LANDMARK

WISCONSIN COORDINATE SYSTEM

North

East

Theta Angle

Horiz. Order

Vert. Order

TYPE OF LANDMARK

2" IRON PIPE

BEARINGS ARE REFERENCED TO
ASSUMED

Describe any record evidence, monument evidence, testimonial evidence or any other material evidence you considered and whether the monument was found or restored through acceptance of an obliterated evidence location.


NO EVIDENCE FOUND - CORNER IS IN WOODED AREA MOSTLY POPLAR AND ELM. NEAR TOP OF WEST SLOPE OF NORTH-SOUTH RIDGE TOP AT APPROXIMATE SIGHTED ~~USDA~~ VISUAL EXTENSION OF FRENCH ROAD TO SOUTH. CORNER SET BY SINGLE PROPORTIONATE MEASURE.

Describe or show any material discrepancy between the location of the restored corner and that of the corner previously restored or reestablished.

NONE KNOWN


RECORD OF DURABLE WITNESS MONUMENTS

NO	DESCRIPTION	BEARING	DISTANCE
1	SINGLE BLAZED 8" POPLAR W/PK IN BLAZE	N29°28'04"E	5.85'
2	SINGLE BLAZED 24" OAK W/PK IN BLAZE	S64°28'51"W	58.10'
3	SINGLE BLAZED 18" OAK W/PK IN BLAZE	S10°06'41"W	56.49'
4	SINGLE BLAZED 24" OAK W/PK IN BLAZE	S48°34'38"E	53.21

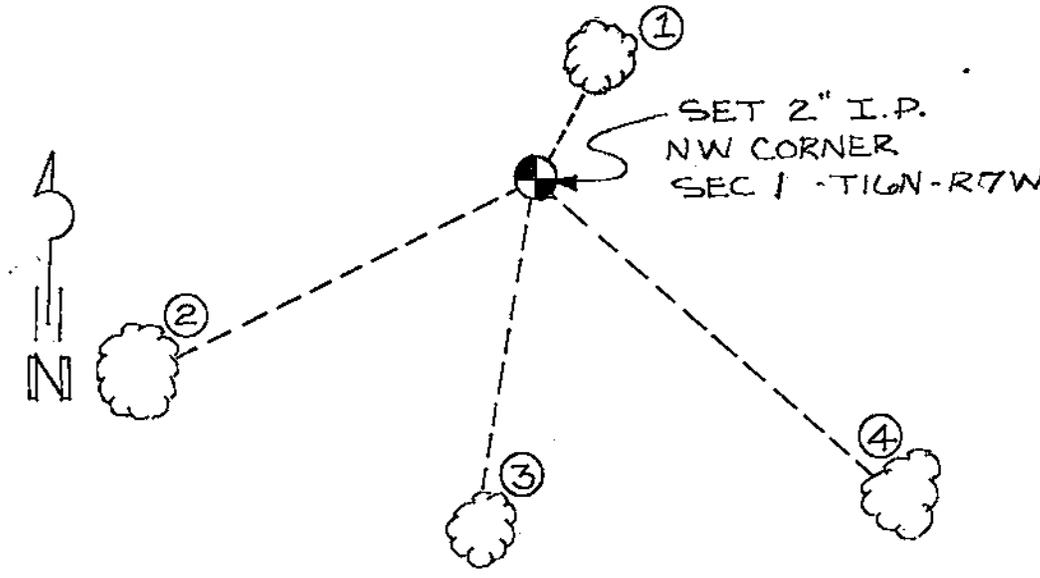


PLAN VIEW DRAWING OF REFERENCE TIES

MAP SHOWING DISTANCE AND DIRECTION TO OTHER PUBLIC LAND SURVEY CORNERS USED FOR REESTABLISHING THE CORNER

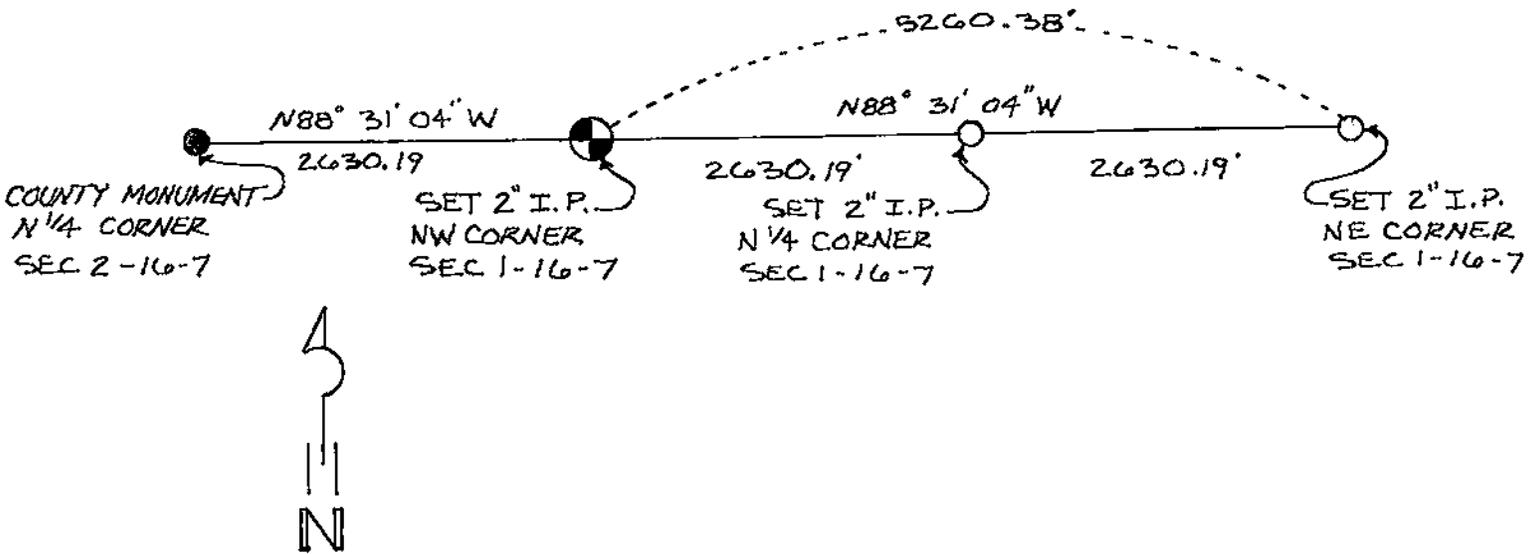

I, Robert E Chalsma
HEREBY CERTIFY THAT THE CORNER LOCATION SHOWN ON THIS RECORD
WAS DETERMINED BY ME OR UNDER MY DIRECTION AND CONTROL AND
THAT THIS U. S. PUBLIC LAND SURVEY MONUMENT RECORD IS CORRECT
AND COMPLETE TO THE BEST OF MY KNOWLEDGE AND BELIEF.

Robert E Chalsma
Signature Date 11/30/82

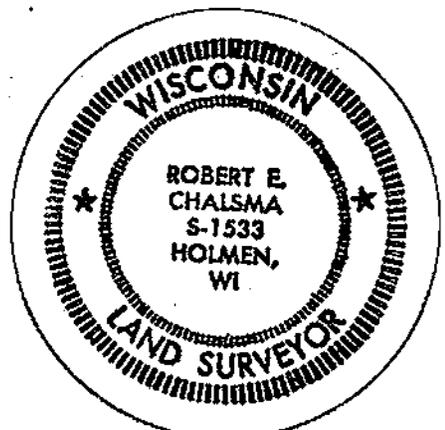

Seal