


U. S. PUBLIC LAND SURVEY MONUMENT RECORD

SECTION 1 T 16 N, R 7 W, TOWN OF MEDARY
LA CROSSE COUNTY

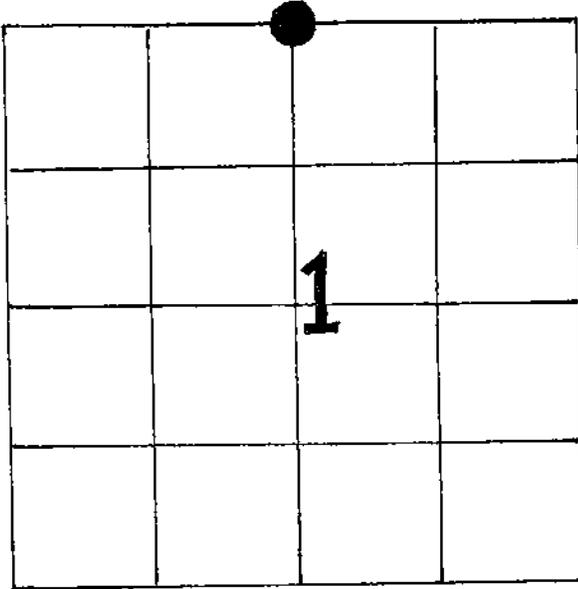

LOCATION OF LANDMARK

WISCONSIN COORDINATE SYSTEM

North

East

Theta Angle

Horiz. Order

Vert. Order

 TYPE OF LANDMARK
2" IRON PIPE

 BEARINGS ARE REFERENCED TO
ASSUMED

Describe any record evidence, monument evidence, testimonial evidence or any other material evidence you considered and whether the monument was found or restored through acceptance of an obliterated evidence location.


CORNER SET BY SINGLE PROPORTIONATE MEASURE.
CORNER IS ON A NORTH FACING SLOPE, APPROXIMATELY
225'± DOWN FROM TOP OF RIDGE.

Describe or show any material discrepancy between the location of the restored corner and that of the corner previously restored or reestablished.

FOUND 1" IRON PIPE w/ SOLBERG PLUG 3.96 FEET
(N74°W) FROM POSITION OF SET 1/4 CORNER.


RECORD OF DURABLE WITNESS MONUMENTS

NO	DESCRIPTION	BEARING	DISTANCE
1	DOUBLE BLAZED 10" MAPLE W/PK IN BLAZE	N 2° W	41.68'
2	DOUBLE BLAZED 6" ASH W/PK IN BLAZE	N 34° E	19.83'
3	DOUBLE BLAZED 10" MAPLE W/PK IN BLAZE	S 71° E	16.47'
4	DOUBLE BLAZED 10" MAPLE W/PK IN BLAZE	N 85° W	7.40'

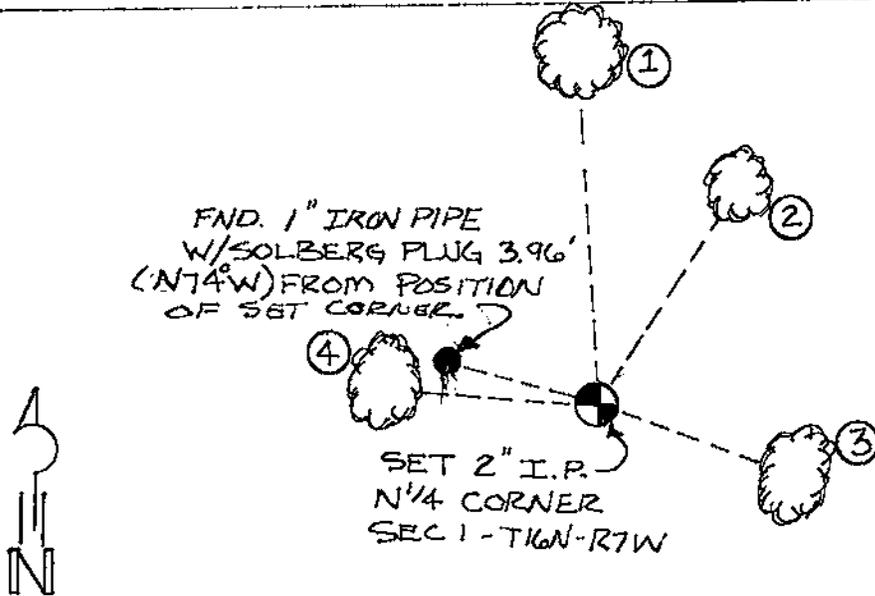


PLAN VIEW DRAWING OF REFERENCE TIES

MAP SHOWING DISTANCE AND DIRECTION TO OTHER PUBLIC LAND SURVEY CORNERS USED FOR REESTABLISHING THE CORNER

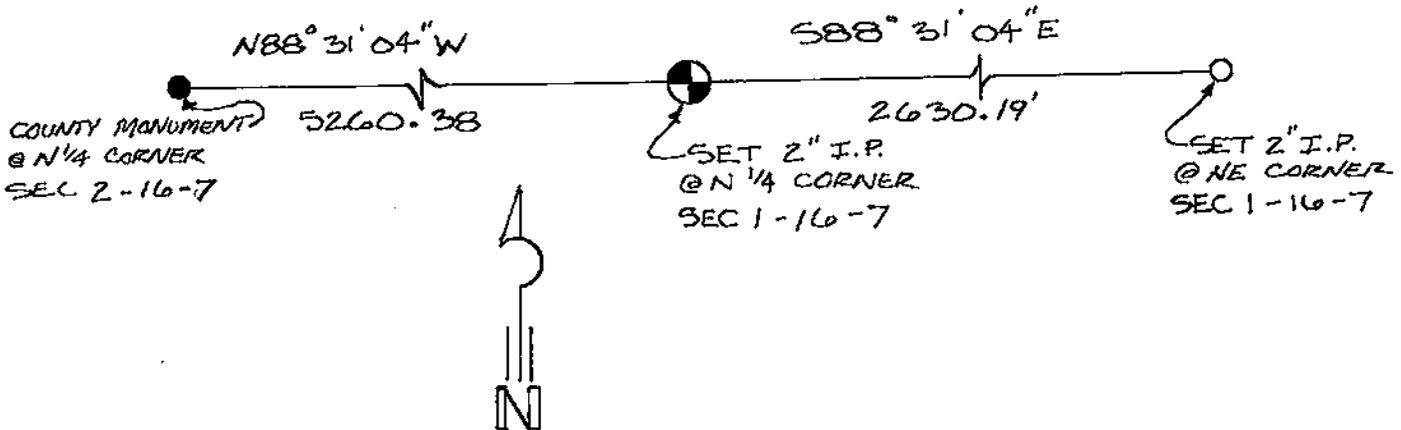

I, Robert E. Chalsma
HEREBY CERTIFY THAT THE CORNER LOCATION SHOWN ON THIS RECORD WAS DETERMINED BY ME OR UNDER MY DIRECTION AND CONTROL AND THAT THIS U. S. PUBLIC LAND SURVEY MONUMENT RECORD IS CORRECT AND COMPLETE TO THE BEST OF MY KNOWLEDGE AND BELIEF.

Robert E. Chalsma 1/30/92
Signature Date

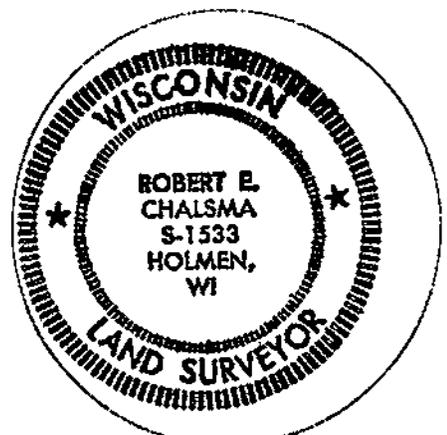

Seal