


FIELD SURVEY NOTES
 PRESERVATION OF LANDMARKS
 (Pursuant to Section 59.635(7) Wisconsin Statutes)

State Highway Commission of Wisconsin
 Form E-D-707-65


COUNTY LA CROSSE		
TOWN CAMPBELL		
HIGHWAY C.T.H. "BW"		
SECTION 6	TOWNSHIP 16 N.	RANGE 7 W
TYPE OF LANDMARK WIS. D.O.T. CAST ALUMINUM WITNESS MONU.		

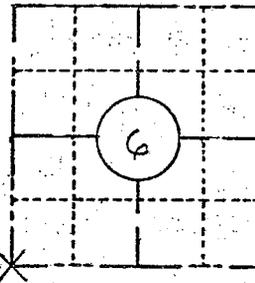

LOCATION SKETCH
 (Location of landmark indicated by "x")



This space for copy of field notes or ties to the above described landmarks

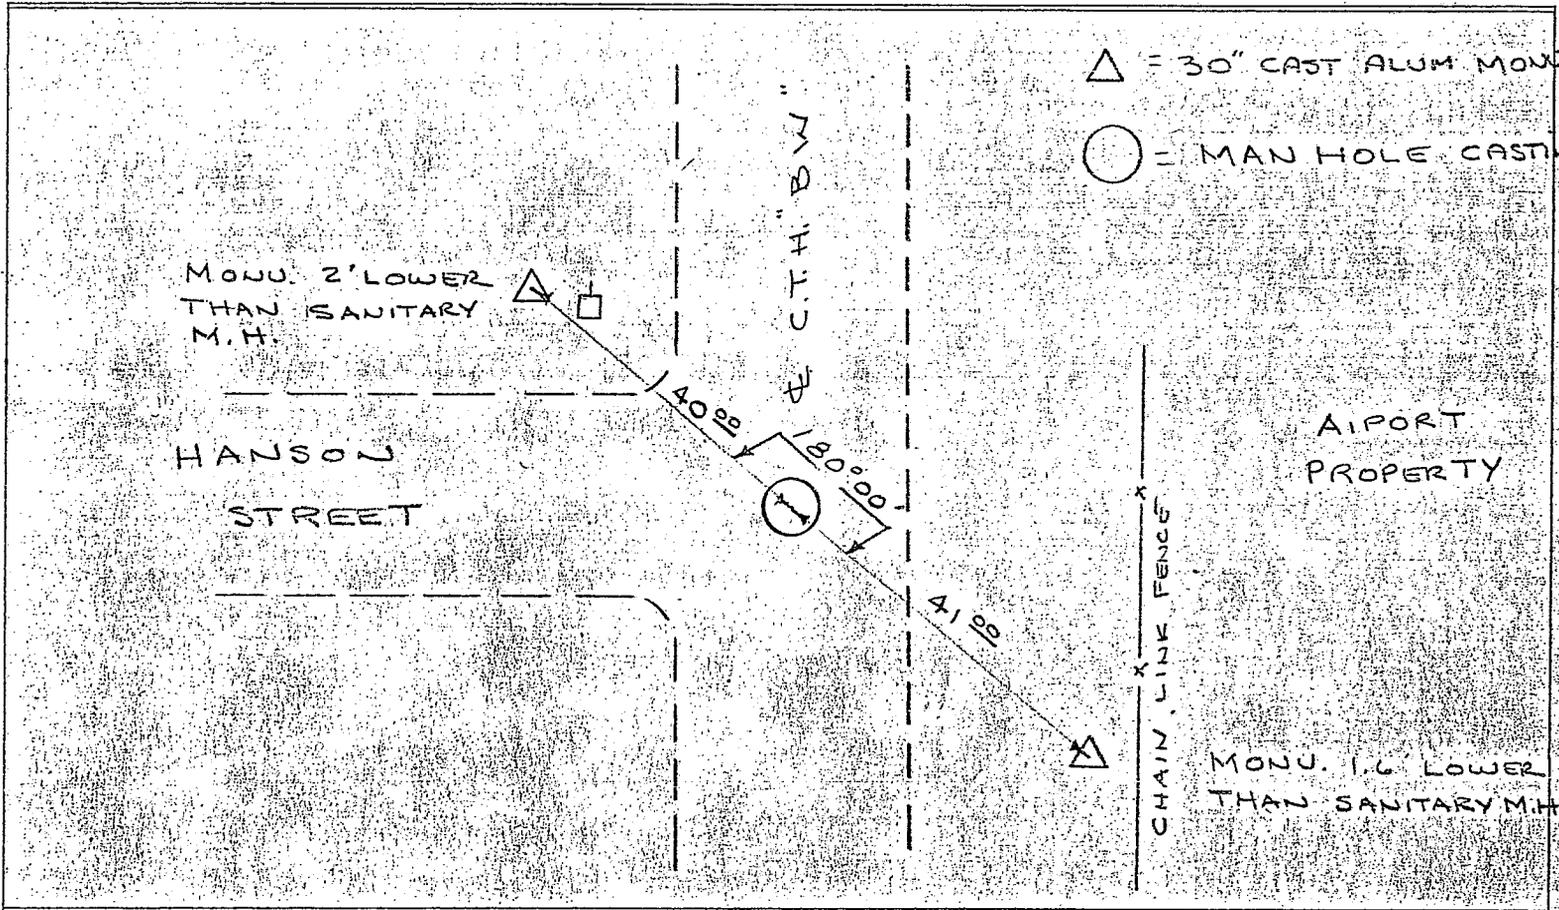

FILED UNDER PROJECT NUMBER			COUNTY CLERK'S OFFICE	
SHC DISTRICT OFFICE NUMBER 5			COUNTY OF LA CROSSE	WISCONSIN } SS
CITY LA CROSSE	COUNTY LA CROSSE	DATE RECEIVED FOR RECORD	DATE COPY SENT TO COUNTY SURVEYOR	
LOCATED OR ESTABLISHED BY PERPETUATED			SIGNATURE OF COUNTY CLERK	
NAME DERALD E. KADING L.S. #1064				
TITLE SURVEY COORDINATOR DATE 11-24-76				



State of Wisconsin \ DEPARTMENT OF TRANSPORTATION



January 6, 1977

DIVISION OF HIGHWAYS
District 5
P. O. BOX 940
250 MORMON COULEE ROAD
LA CROSSE, WISCONSIN 54601

Mr. Raymond Pelishek
Land Use Coordinator
Court House, Room 105
La Crosse, Wisconsin 54601

SUBJECT: Land Monument Perpetuation
on French Island

Dear Mr. Pelishek:

Enclosed you will find two (2) Preservation of Landmark forms for two (2) monuments on C.T.H. "BW", Town of Campbell. The other sheet is a copy of U.S. Corps of Engineers' mapping indicating in red the two (2) monuments that were perpetuated.

Would you please file these in the proper place for public record.

Thank you.

Very truly yours,

L. G. SCHNEIDER, P.E.
District Engineer

by


C. D. Anderson, P. E.
District Chief Design Engineer

DEK:on
cc: File
encl.

3" I.P. Bronze Cap
Set by U.S.E.O.

12

6

T.16 N. R.8 W. 4TH P.M.

T.16 N. R.7 W. 4TH P.M.

Telephone Line

Telephone Line

Gravel
Pit

1/2" Wooden Stake

N.C. Set 29.7 ft. East
2" G.I. Pipe
Set by th.S. B.S.

