


U. S. PUBLIC LAND SURVEY MONUMENT RECORD

SECTION 13 T 16 N, R 8 W, TOWN OF CAMPBELL
LA CROSSE COUNTY

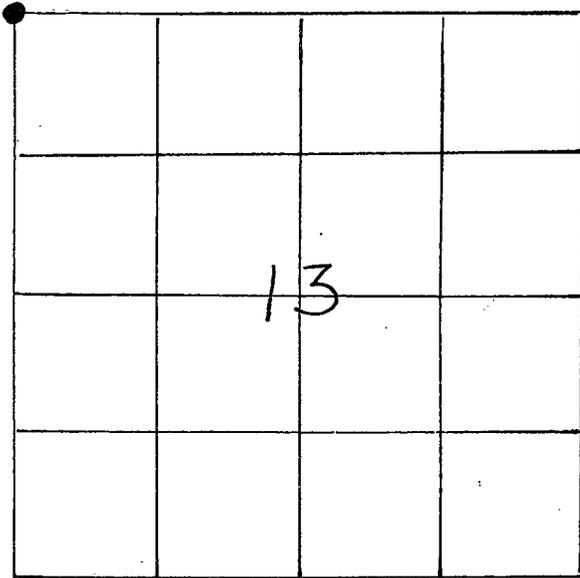

LOCATION OF LANDMARK

WISCONSIN COORDINATE SYSTEM
North
East
Theta Angle
Horiz. Order
Vert. Order
TYPE OF LANDMARK
BRASS CAP
BEARINGS ARE REFERENCED TO
INTERSTATE 90

Describe any record evidence, monument evidence, testimonial evidence or any other material evidence you considered and whether the monument was found or restored through acceptance of an obliterated evidence location.


FOUND BRASS CAP SET IN CONCRETE
ABUTMENT OF SPILLWAY

Describe or show any material discrepancy between the location of the restored corner and that of the corner previously restored or reestablished.

NONE


RECORD OF DURABLE WITNESS MONUMENTS

NO	DESCRIPTION	BEARING	DISTANCE
1	FOUND 1/2" RE BAR	N 87-49-02 W	256.13
2	FOUND 1" I.P.	S 89-39-58 E	2002.40
3	N. INSIDE CORNER CONCRETE	± NORTH	12.61
4	S. " " " "	± SOUTH	12.42

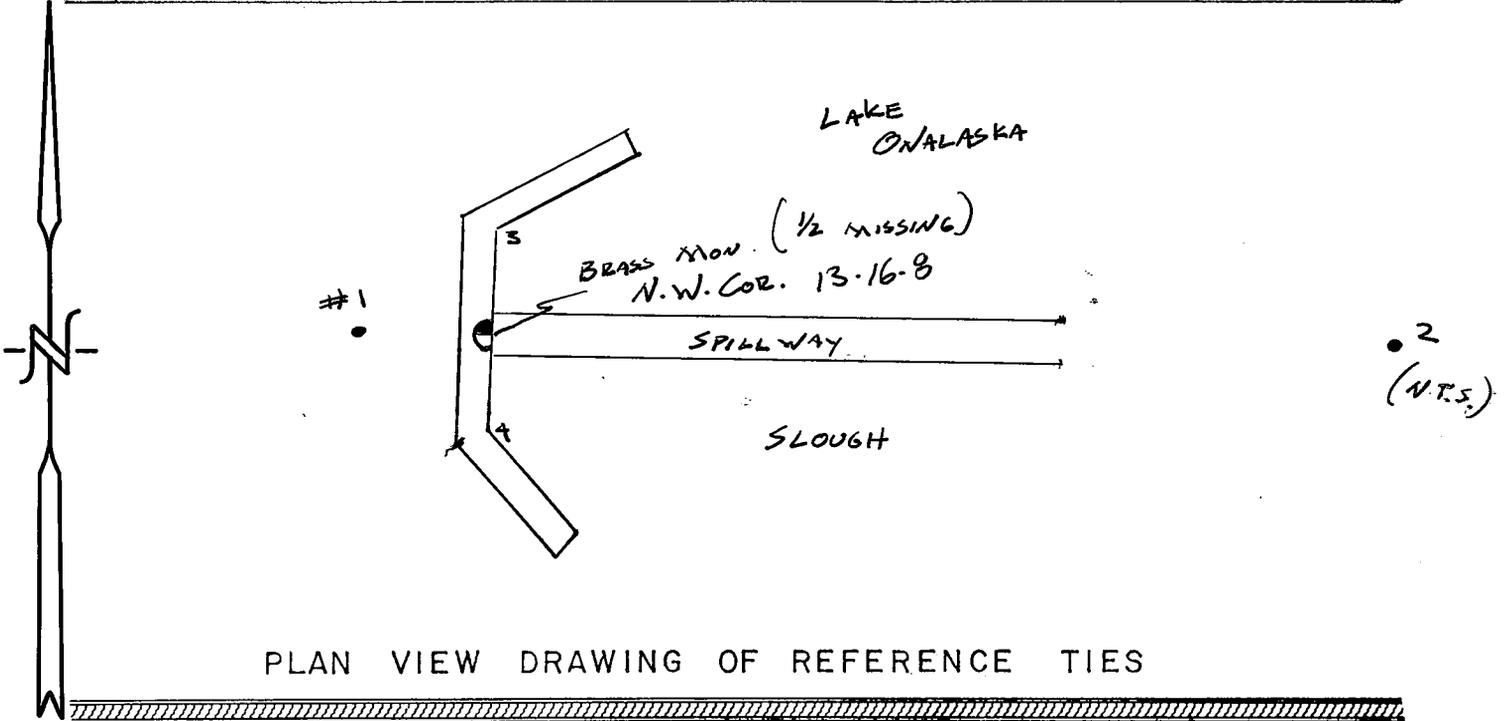

PLAN VIEW DRAWING OF REFERENCE TIES

MAP SHOWING DISTANCE AND DIRECTION TO OTHER PUBLIC LAND SURVEY CORNERS USED FOR REESTABLISHING THE CORNER.

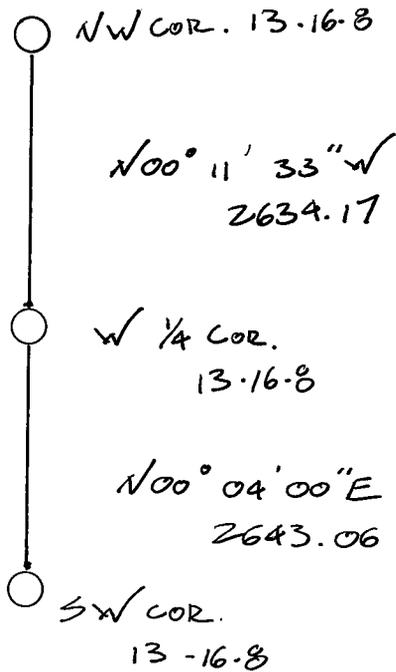

I, PAUL E. FAIRCHILD
 HEREBY CERTIFY THAT THE CORNER LOCATION SHOWN ON THIS RECORD
 WAS DETERMINED BY ME OR UNDER MY DIRECTION AND CONTROL AND
 THAT THIS U. S. PUBLIC LAND SURVEY MONUMENT RECORD IS CORRECT
 AND COMPLETE TO THE BEST OF MY KNOWLEDGE AND BELIEF.

Paul E. Fairchild
 Signature

10.2.98
 Date



Seal