


U. S. PUBLIC LAND SURVEY MONUMENT RECORD

SECTION 12 T 16 N, R 8 W, TOWN OF CAMPBELL  
LA CROSSE COUNTY

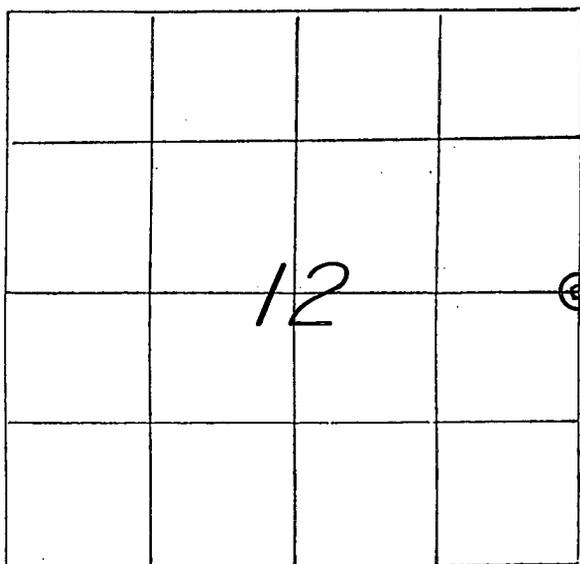

WISCONSIN COORDINATE SYSTEM
North
East
Theta Angle
Horiz. Order
Vert. Order
TYPE OF LANDMARK
<i>P.K. NAIL &amp; CAP IN PAVEMENT.</i>
BEARINGS ARE REFERENCED TO
Grid <i>NORTH.</i>

LOCATION OF LANDMARK

CREW: WILLIAM C. JUNG  
PETER F. FOLLANSBEE  
DATE: 6/29/1999

Describe any record evidence, monument evidence, testimonial evidence or any other material evidence you considered and whether the monument was found or restored through acceptance of an obliterated evidence location.

Due to repaving, the nail and tab of record was knocked out. I set a P.K. nail at Clark's old location.


Describe or show any material discrepancy between the location of the restored corner and that of the corner previously restored or reestablished.

**NONE KNOWN.**




RECORD OF DURABLE WITNESS MONUMENTS

NO	DESCRIPTION	BEARING	DISTANCE
1	SET A P.K. NAIL IN S-SIDE OF AN UNBLAZED TREE	N.' WESTERLY ±	56.86 FT.
2	EXISTING 1/2" IRON PIPE	N.' WESTERLY ±	41.42 FT.
3	CENTER OF STEEL STREET SIGN POST	N.' WESTERLY ±	44.15 FT.
4	EXISTING LARGE IRON PIPE	EAST ±	32.97 FT.

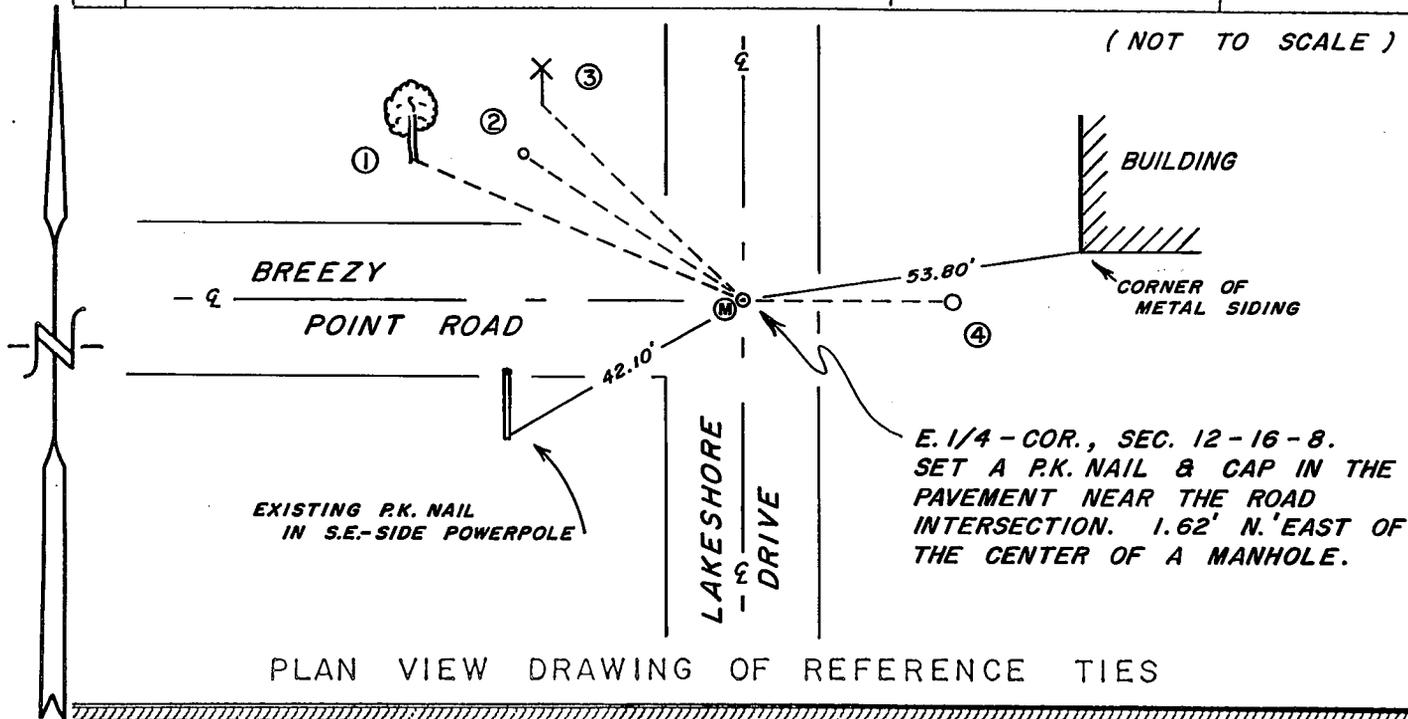

MAP SHOWING DISTANCE AND DIRECTION TO OTHER PUBLIC LAND SURVEY CORNERS USED FOR REESTABLISHING THE CORNER

(not to scale)

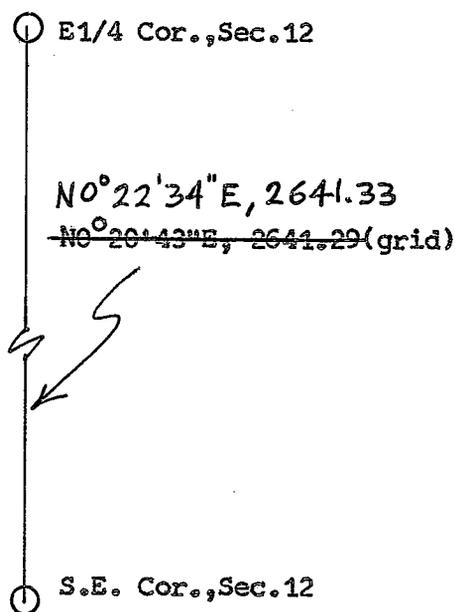


I, WILLIAM C. JUNG, COUNTY SURVEYOR  
 HEREBY CERTIFY THAT THE CORNER LOCATION SHOWN ON THIS RECORD WAS DETERMINED BY ME OR UNDER MY DIRECTION AND CONTROL AND THAT THIS U. S. PUBLIC LAND SURVEY MONUMENT RECORD IS CORRECT AND COMPLETE TO THE BEST OF MY KNOWLEDGE AND BELIEF.

William C. Jung  
 Signature

7/26/99  
 Date

Revised: 12/28/99  
 wej

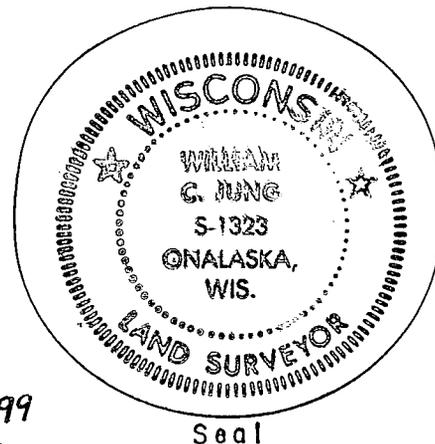



240 East Fillmore Avenue  
P.O. Box 7023  
St. Paul, MN 55107  
612 291-1127

March 20, 1987

Ray Pellishek  
LaCrosse County Surveyor  
Courthouse  
LaCrosse, Wisconsin 54601

Re: E 1/4 Corner, Sec. 12, T.16, R.8  
LaCrosse Co., WI

Dear Mr. Pellishek:

It has been brought to my attention that the above corner set by me from county and city ties is incorrect. I have revised the survey for the St. Paul District Corps of Engineers in accordance with the monument record as filed by Wilbur Clark, R.L.S., and dated 1-22-87. A copy is enclosed.

Please void, remove, or appropriately reference the P.L.S. monument record for the above corner filed by me and dated 2-1-85. Thank you very much for your assistance.

Yours truly,

A handwritten signature in cursive script that reads "Keith M. Graham".

Keith M. Graham, RLS  
for Martinez Corporation

KMG/rb

enc.

February 2, 1987

Engineering  
Geotechnical, Hydraulics and Hydrologic Engineering

Mr. Tony Martinez  
Martinez Corporation  
240 East Fillmore Ave.  
St. Paul, Minnesota 55107

(AC 612) 291-1127

Dear Mr. Martinez:

Reference the enclosed letter from the City of La Crosse Engineering Dept. La Crosse, Wisconsin.

Our office has sent a copy of the survey performed at the site in question (reference material enclosed) to the La Crosse city engineer. Our file for this site has no record on the origin of the ties used to set this corner.

It is requested that you submit a copy of the original ties used in the setting of the corner to verify the ties recorded by your field crew.

If this cannot be done we suggest a re-survey to verify this corner and if necessary a certificate of correction be made available to the St. Paul District Corps of Engineers Surveys Dept., the city engineer for the City of La Crosse Wisconsin and the La Crosse Co. surveyor.

Please direct your correspondence to:

Mr. W.L. Clark P.E.  
City Hall  
La Crosse, Wisconsin 54601  
Phone 608-784-9250

Sincerely,

Greg Dasovic  
St. Paul Dist. Corps of Engineers  
Surveys Section  
1135 U.S.P.O. & Customs House  
St. Paul, Minnesota 55101


DASOVIC \_\_\_\_\_  
WHARTMAN \_\_\_\_\_  
JOHNSON \_\_\_\_\_

Enc  
as

*Enc. retained in  
Geol. & Survey*

U. S. PUBLIC LAND SURVEY MONUMENT RECORD

SECTION 7 T 16 N, R 7 W, TOWN OF CAMPBELL AND  
 LA CROSSE COUNTY CITY OF LACROSSE.

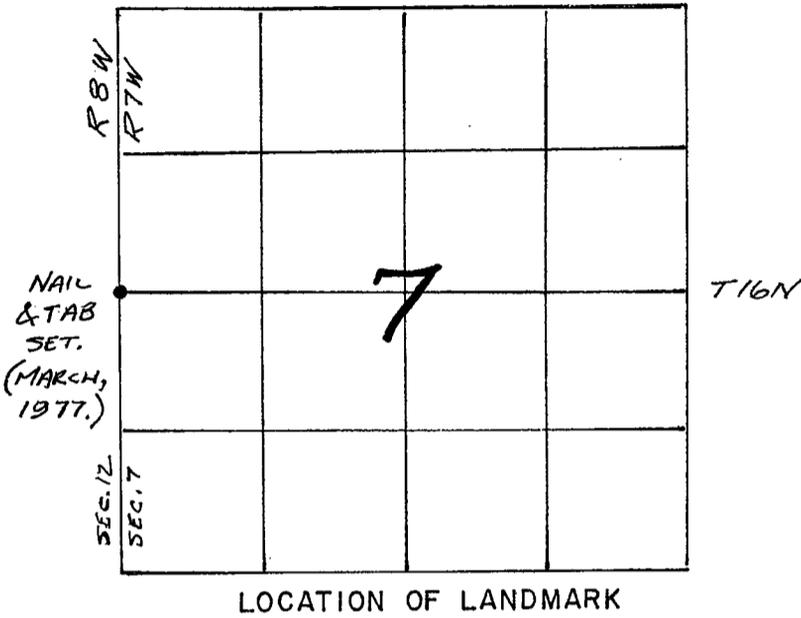


WISCONSIN COORDINATE SYSTEM
North
East
Theta Angle
Horiz. Order
Vert. Order
TYPE OF LANDMARK
NAIL & TAB. (W. 1/4 CORNER.)
BEARINGS ARE REFERENCED TO
SEE → ENCLOSED SURVEY OF SECTION 7.

Describe any record evidence, monument evidence, testimonial evidence or any other material evidence you considered and whether the monument was found or restored through acceptance of an obliterated evidence location.

SET NAIL & TAB @ 1/4 CORNER FROM "TIES" BY DAVY ENGR. CO., CITY OF LACROSSE. (TIES WERE TO U.S.C.E. MONUMENT LOCATED HERE BEFORE SAN. SEWER WAS CONSTRUCTED.) TIES DID NOT CHECK OUT EXACTLY AS "HUB" TO N.E. WAS GONE; WE PROJECTED 1/4 LINE FROM THE WEST ALSO. "TIES" ARE AS SHOWN ON CITH. "B-W", LAKESHORE DRIVE, STREET PLANS, STATE PROJECT NO. 5991-3-01, APPROVED 5-19-1976.


Describe or show any material discrepancy between the location of the restored corner and that of the corner previously restored or reestablished.

NAIL & TAB WAS SET IN MARCH, 1977, CITY SURVEY OF PART OF THE CITY OF LACROSSE AIRPORT SURVEY. WE FOUND "P.K." NAIL AT LOCATION SHOWN IN DEC. OF 1986. "P.K." WAS SET BY KEITH M. GRAHAM, S-1806, MARTINEZ CORP., ST. PAUL, MINN., DOING WORK FOR U.S.C.E. OFFICE, ST. PAUL DIST, ST. PAUL, MINN.

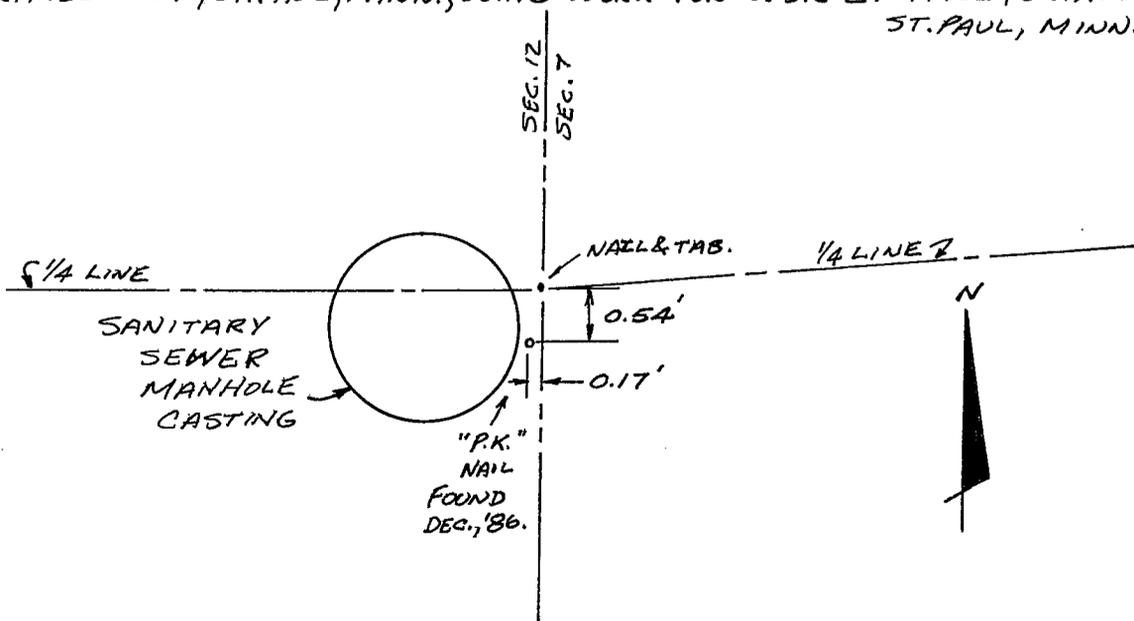

RECORD OF DURABLE WITNESS MONUMENTS

NO	DESCRIPTION	BEARING	DISTANCE
1	NAIL & TAB. (SET JAN., 1987)	N89°-50'-26"W	99.18'
2	NAIL & TAB. " " "	N89°-50'-26"W	46.33'
3	2" IRON PIPE. (SET MARCH, 1977.)	N89°-29'-02"E	33.00'
4			

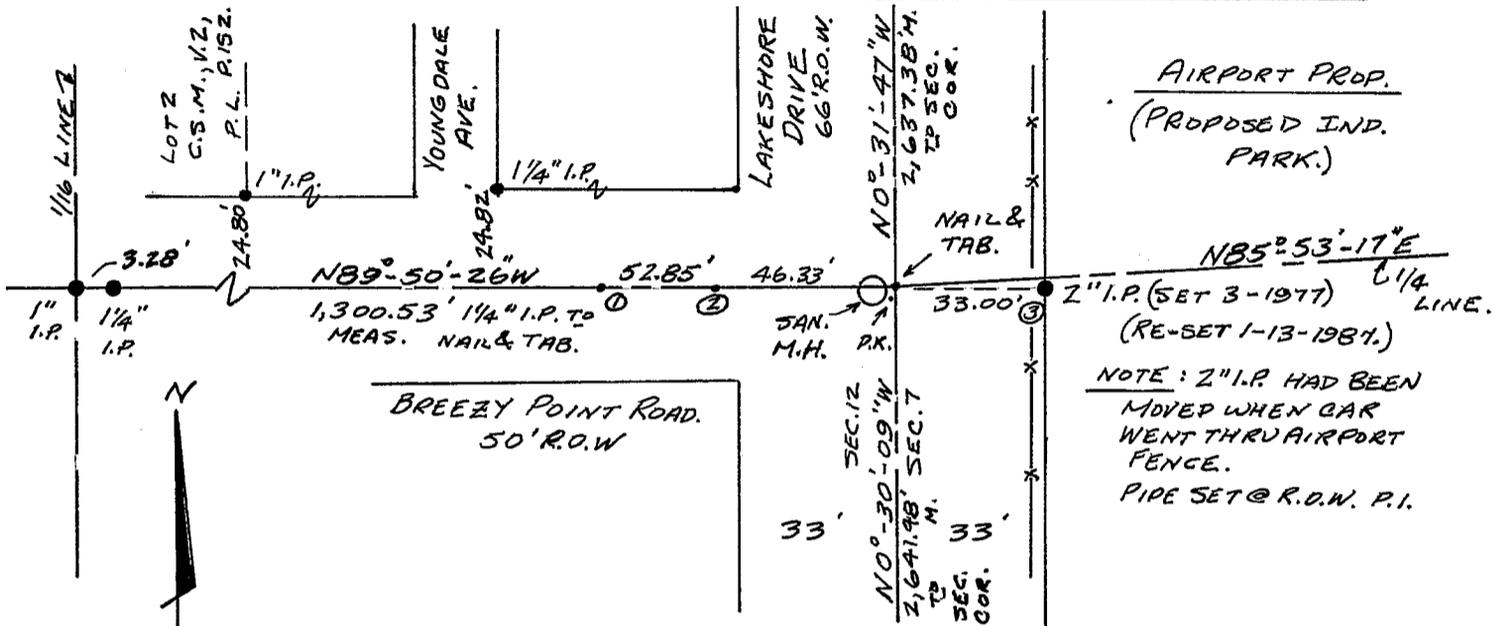

PLAN VIEW DRAWING OF REFERENCE TIES

MAP SHOWING DISTANCE AND DIRECTION TO OTHER PUBLIC LAND SURVEY CORNERS USED FOR REESTABLISHING THE CORNER

SEE → ENCLOSED SURVEY OF SECTION 7, T16N, R7W, 4TH P.M., CITY OF LACROSSE, LA CROSSE COUNTY, WISCONSIN.

I, WILBUR L. CLARK, ENGR. DEPT., CITY OF LACROSSE,  
 HEREBY CERTIFY THAT THE CORNER LOCATION SHOWN ON THIS RECORD  
 WAS DETERMINED BY ME OR UNDER MY DIRECTION AND CONTROL AND  
 THAT THIS U. S. PUBLIC LAND SURVEY MONUMENT RECORD IS CORRECT  
 AND COMPLETE TO THE BEST OF MY KNOWLEDGE AND BELIEF.


Wilbur L. Clark 1-22-1987  
 Signature Date



Seal

Q RUNWAY 18-36 = N 00°-34'-18" W.  
 NOTE: BEARINGS ARE TRUE BEARINGS AS PER AIRPORT PLANS. (Q RUNWAY 18-36)

ENGR. DEPT.,  
 CITY OF LACROSSE,  
 WIS.

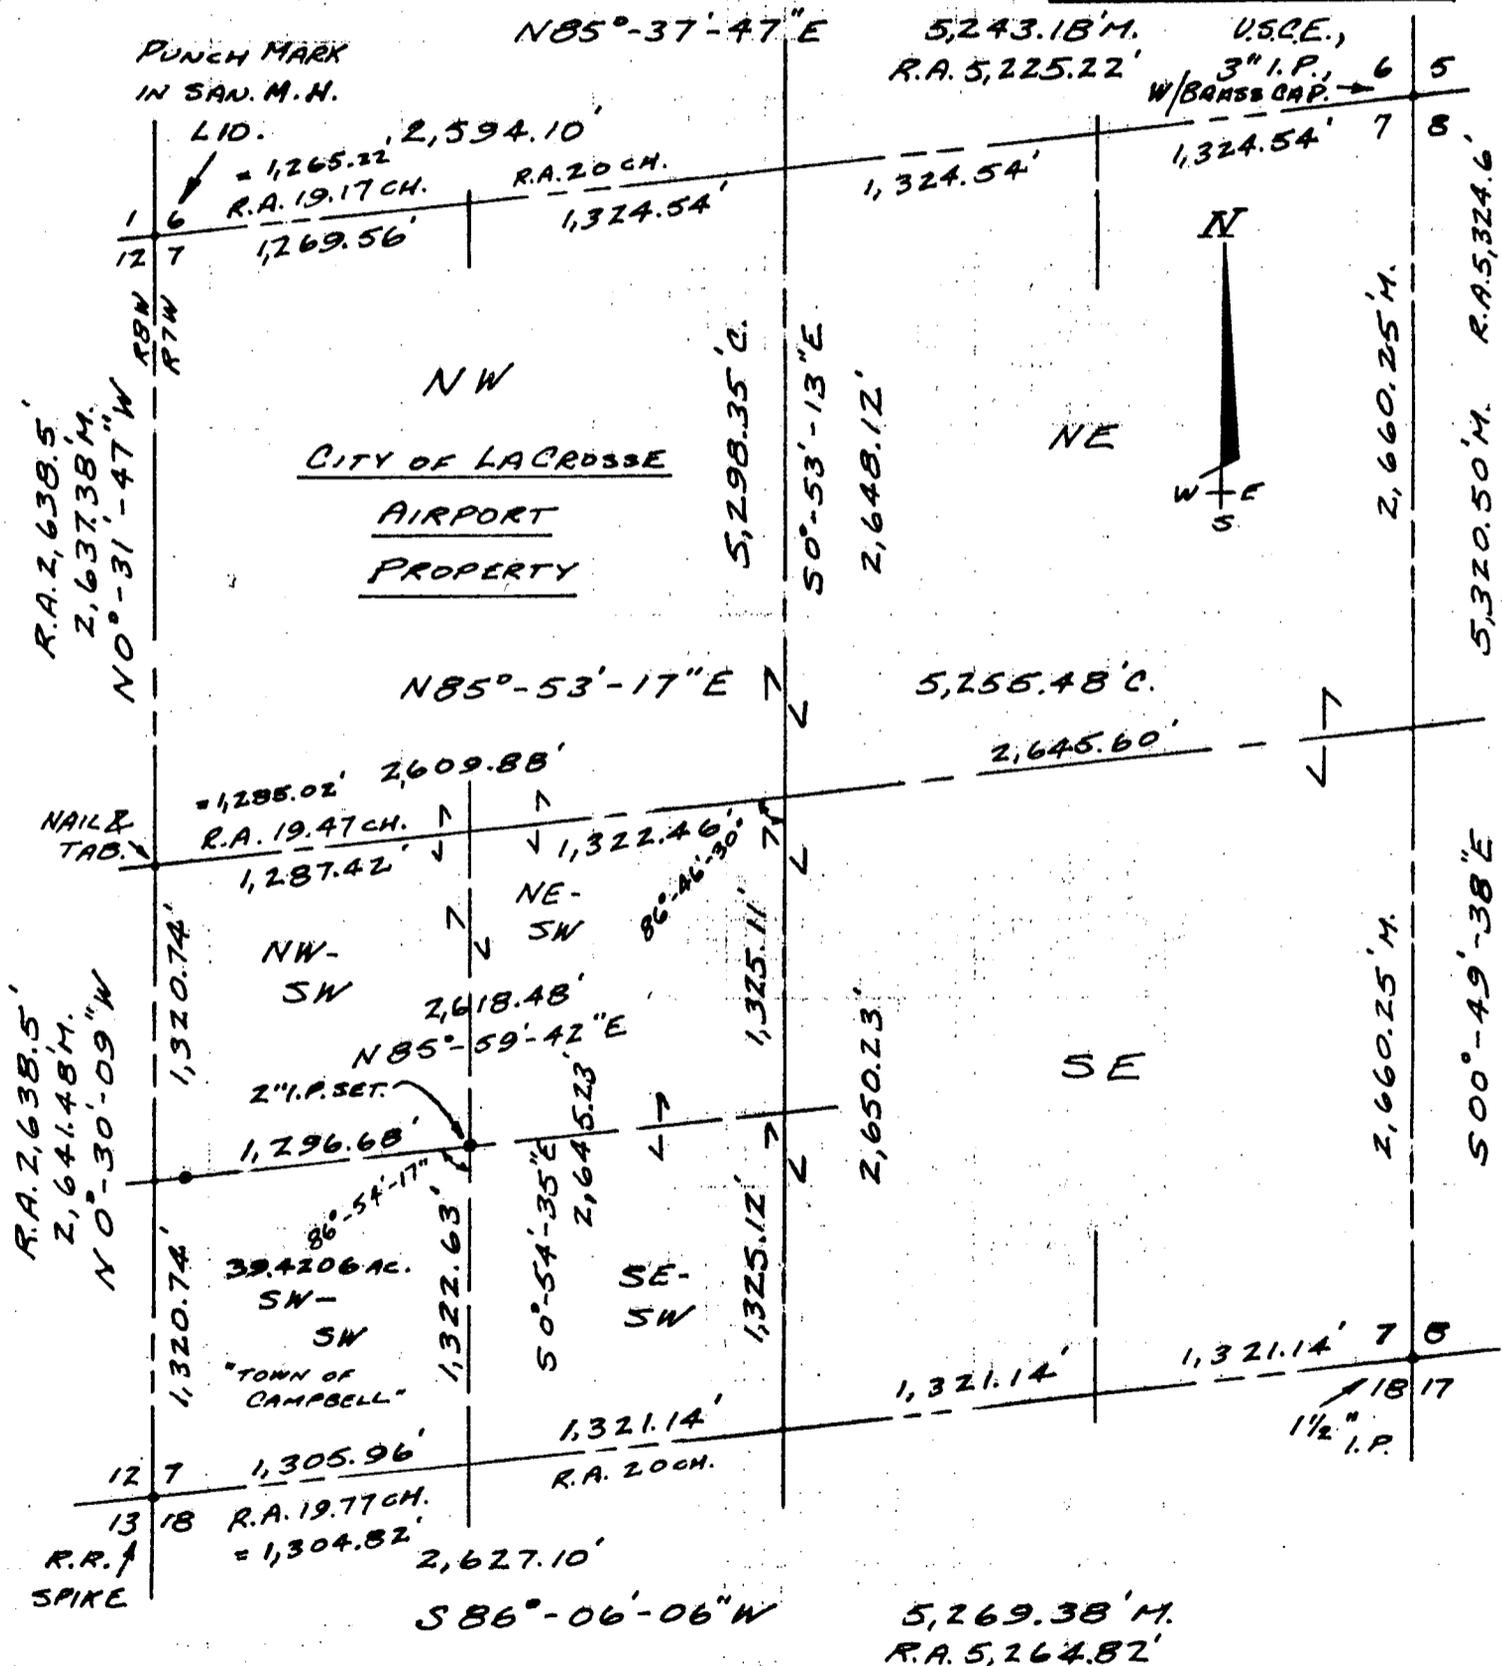

TOTAL AREA, SEC. 7 = 638.2861 ACRES. (R.A. 5,271.5' = AIRPORT BOOK #26A.)

SUBDIVISION OF THE SW 1/4 - SW 1/4, SECTION 7,  
 T16N, RTW, 4<sup>TH</sup> P.M., TOWN OF CAMPBELL,  
 LACROSSE COUNTY, WISCONSIN.

W.L.C.  
 JAN., 1987

# U. S. PUBLIC LAND SURVEY MONUMENT RECORD


**INSTRUCTIONS :**

This record shall show the location of the corner and shall include all of the following nine elements (a through i).

- (a) Identify the corner by reference to the U.S. public land survey system.

○ = Corner monument restored.

*E 1/4 CORNER, SEC. 12,  
T. 16 N., R. 8 W., 4TH P.M.  
LACROSSE Co., WISC.*

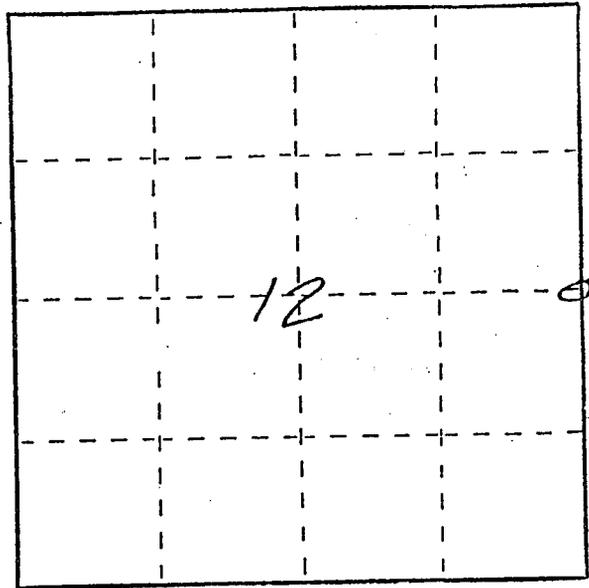

*VOID - SEE P.L.S.*

*Monument RECORD by*


*W.L. Clark, dated 1/22/87* *Ken M. Johnson* *S. 1806*

- (b) Describe any record evidence, monument evidence, occupational evidence, testimonial evidence or any other material evidence you considered, and whether the monument was found or placed.

*SET P.K. AT Edge of MH COVER FROM La CROSSE Co.  
Hwy DEPT. TIES.*

- (c) In the plan view drawing below, provide reference ties to at least 4 witness monuments, or, if the location is within a municipality, to at least 2 witness monuments. (Witness monuments shall be made of concrete, natural stone, iron or other equally durable material.) Describe witness monuments.

- (d) Show a plan view drawing depicting the relevant monuments and reference ties which is sufficient in detail to enable accurate relocation of the corner monument if the corner monument is disturbed. Indicate north.

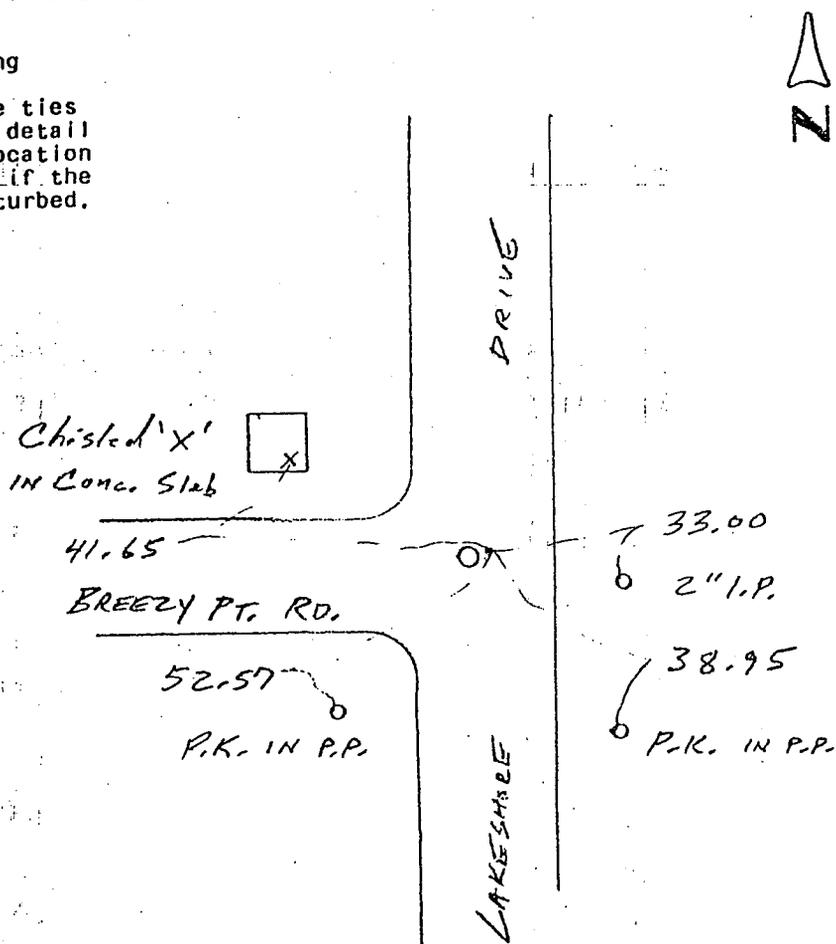


NONE

(f) Was the corner restored through acceptance of (1) an obliterated evidence location, or, (2) a found perpetuated location?

(g&h) Was the corner reestablished through lost corner proportionate methods? If so, show the method, including the directions and distances to other public land survey corners used as evidence or used for proportioning in determining the corner location?

No.

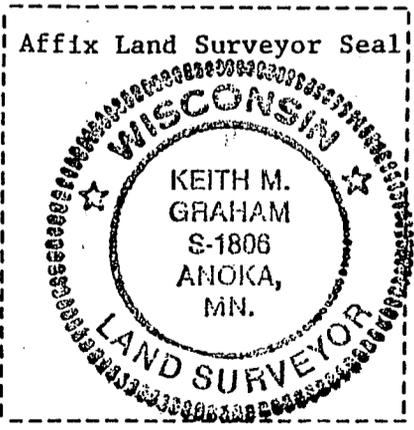

(i) I, KEITH M. GRAHAM  
(type or print name) certify that the corner location shown on this record was determined by me or under my direction and control and that this U.S. Public Land Survey Monument Record is correct and complete to the best of my knowledge and belief.

Keith M. Graham  
Signature

2/1/85  
Date


# U. S. PUBLIC LAND SURVEY MONUMENT RECORD

**INSTRUCTIONS:** This record shall show the location of the corner and shall include all of the following nine elements (a through i).

(a) Identify the corner by reference to the U.S. public land survey system.

○ = Corner monument restored.

*E 1/4 CORNER, SEC. 12,  
T. 16 N., R. 8 W., 4TH P.M.  
LACROSSE Co., WISC.*

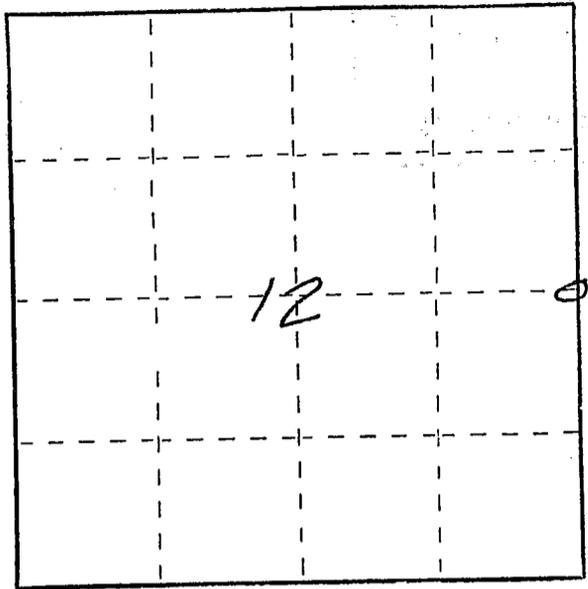


(b) Describe any record evidence, monument evidence, occupational evidence, testimonial evidence or any other material evidence you considered, and whether the monument was found or placed.

*SET P.K. AT Edge of MH COVER FROM L & CROSSE Co.  
Hwy DEPT. TIES.*

(c) In the plan view drawing below, provide reference ties to at least 4 witness monuments, or, if the location is within a municipality, to at least 2 witness monuments. (Witness monuments shall be made of concrete, natural stone, iron or other equally durable material.) Describe witness monuments.

(d) Show a plan view drawing depicting the relevant monuments and reference ties which is sufficient in detail to enable accurate relocation of the corner monument if the corner monument is disturbed. Indicate north.

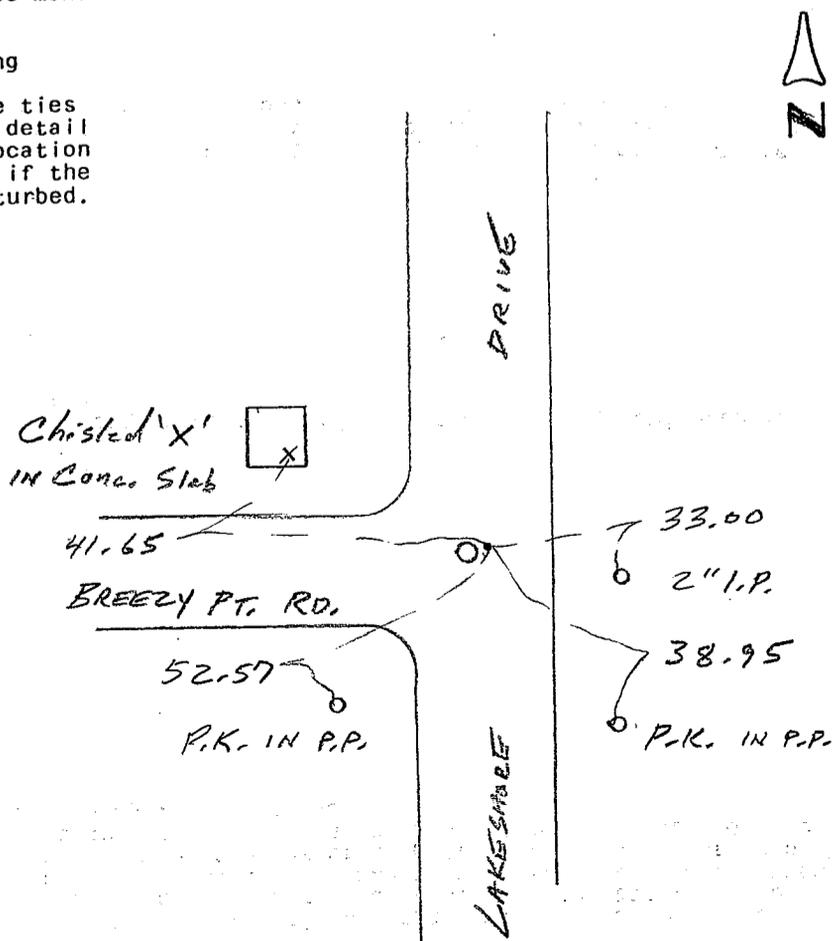

(e) Describe any material discrepancy between the location of the corner as restored or reestablished and the location of that corner as previously restored or reestablished by distance and direction. Show the discrepancy on the plan view drawing under (d), above. Show the distances between the corner as previously restored or reestablished and (1) the corner as restored or reestablished, and (2) to at least 2 of the witness monuments shown on the drawing in (d), above.

NONE.

(f) Was the corner restored through acceptance of (1) an obliterated evidence location, or, (2) a found perpetuated location?

(g&h) Was the corner reestablished through lost corner proportionate methods? If so, show the method, including the directions and distances to other public land survey corners used as evidence or used for proportioning in determining the corner location?

No.

(i) I, KEITH M. GRAHAM  
(type or print name) certify that the corner location shown on this record was determined by me or under my direction and control and that this U.S. Public Land Survey Monument Record is correct and complete to the best of my knowledge and belief.

Keith M. Graham  
Signature

12/30/84  
Date

