


U. S. PUBLIC LAND SURVEY MONUMENT RECORD

SECTION 13 T 16 N, R 8 W, TOWN OF Campbell

LA CROSSE COUNTY

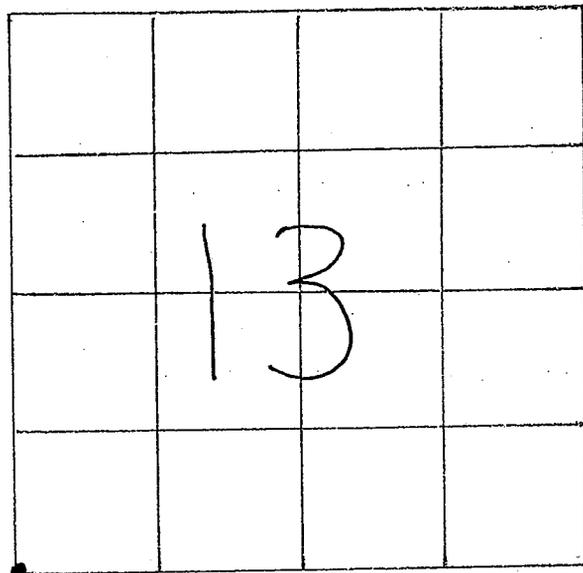

LOCATION OF LANDMARK

WISCONSIN COORDINATE SYSTEM

North

East

Theta Angle

Horiz. Order

Vert. Order

TYPE OF LANDMARK

BRASS CAPPED CONCRETE MON

BEARINGS ARE REFERENCED TO

I-90 PLANS

Describe any record evidence, monument evidence, testimonial evidence or any other material evidence you considered and whether the monument was found or restored through acceptance of an obliterated evidence location.


FOUND BRASS CAPPED CONCRETE MONUMENT
& ACCEPTED LOCATION

Describe or show any material discrepancy between the location of the restored corner and that of the corner previously restored or reestablished.


NONE

RECORD OF DURABLE WITNESS MONUMENTS

NO	DESCRIPTION	BEARING	DISTANCE
1	SINGLE BLAZED 24" SILVER MAPLE W/ P.K. AT TREE BASE	N 03° 12' 14" E	48.93
2	SINGLE BLAZED 40" OAK W/ P.K. AT TREE BASE	N 57° 13' 06" E	115.40
3	SINGLE BLAZED 18" MAPLE W/ P.K. AT TREE BASE	N 68° 29' 11" E	67.73
4	SINGLE BLAZED 24" SILVER MAPLE W/ P.K. AT TREE BASE	S 12° 11' 58" W	39.14
5	SINGLE BLAZED 16" MAPLE W/ P.K. AT TREE BASE	N 73° 49' 21" W	90.50

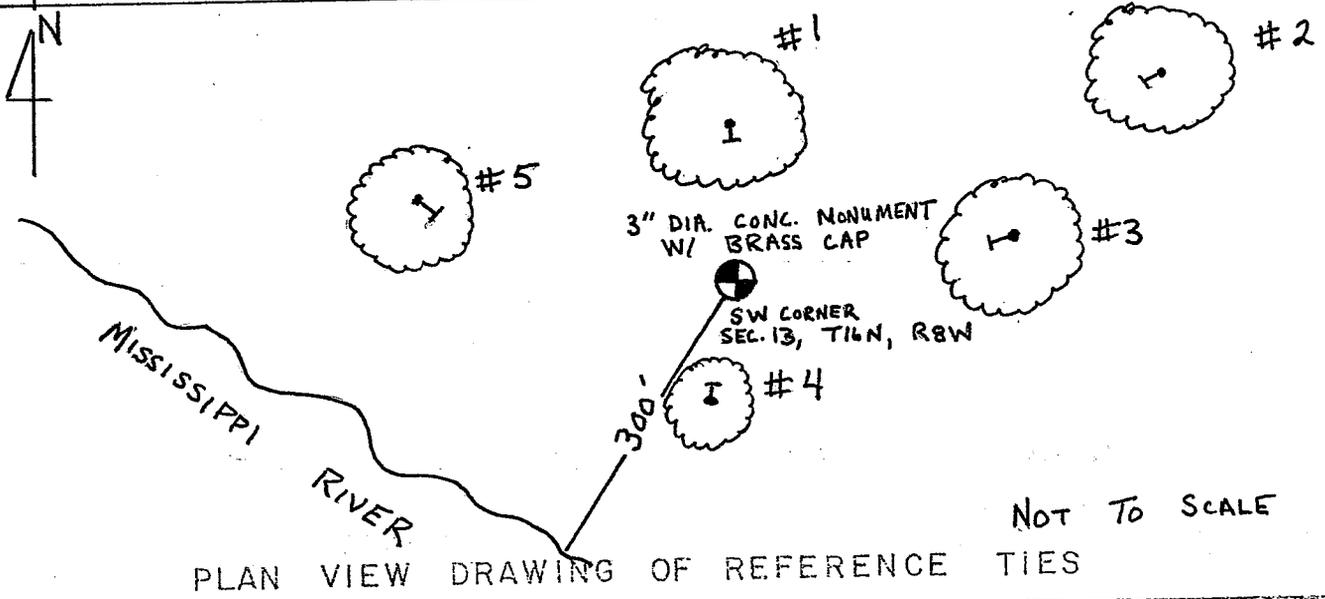

MAP SHOWING DISTANCE AND DIRECTION TO OTHER PUBLIC LAND SURVEY CORNERS USED FOR REESTABLISHING THE CORNER

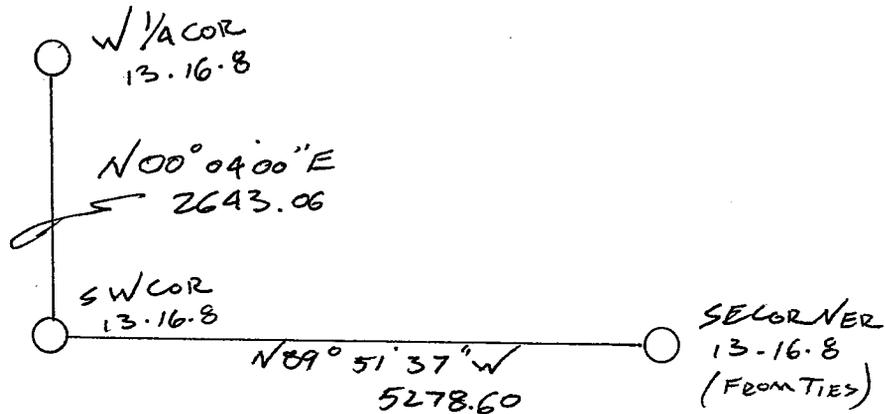

I, PAUL E. FAIRCHILD
HEREBY CERTIFY THAT THE CORNER LOCATION SHOWN ON THIS RECORD
WAS DETERMINED BY ME OR UNDER MY DIRECTION AND CONTROL AND
THAT THIS U. S. PUBLIC LAND SURVEY MONUMENT RECORD IS CORRECT
AND COMPLETE TO THE BEST OF MY KNOWLEDGE AND BELIEF.

Paul E. Fairchild
Signature

10.2.98
Date



Seal