

CERTIFICATE

CERTIFIED LAND CORNER

No. 52

I, Harley A. Sime, do hereby certify that on the 26 day of March, 1975, I found ~~(evidence)~~ (no evidence) of the S.W. corner of Section 6, T 17, N, R 4W, Fourth Principal Meridian, and I re-established said corner according to the Wisconsin Statutes as shown and described hereon.

History of original corner establishment:  
Description of corner evidence found:

Dated this 14 day of Jan., 1976.  
*[Signature]*  
County Surveyor  
True

Accepted an old and well occupied 4-way fence corner as the best available evidence. See corner sheet #32 for further information on the closing line to the East. No further evidence could be found to the West. This corner fits the West line of the Township fairly well.

The terrain North and East is very rugged.




Description of corner and witness monuments, references and accessories used to perpetuate the original or re-established location of this corner:  
Set a Harrison marker in the fence corner, up 6".

Witnesses to corner location:



W.C. Jung - Crew Chief *[Signature]*

D. Malliet

A. Ineck

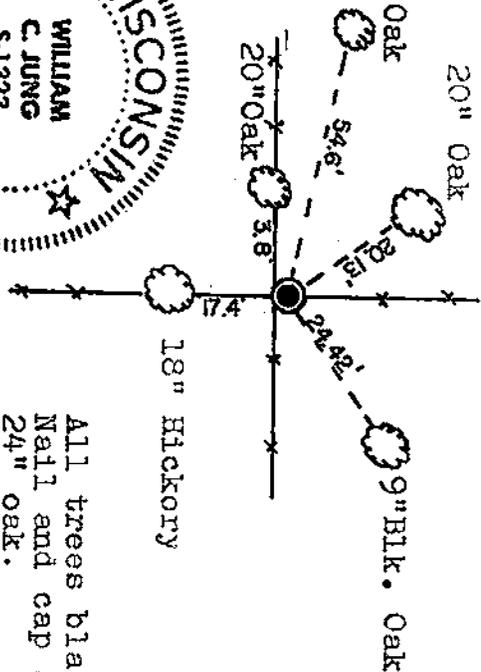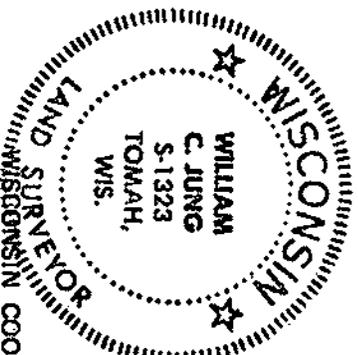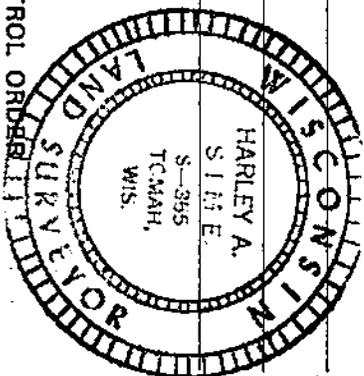

All trees blazed and Nail and cap set except 24" oak.

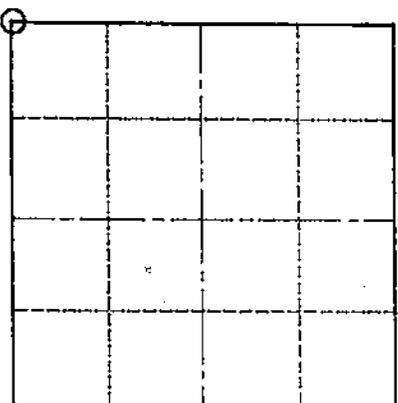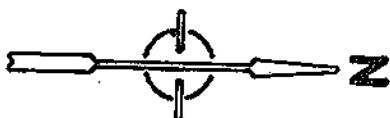

Horizontal	East (X)	North (Y)	Elevation (Z)	Zone
Vertical	Corner	Control Sta. Name		

City, Village or Town Sparta  
County of Monroe