


U. S. PUBLIC LAND SURVEY MONUMENT RECORD

SECTION 1 T 17 N, R 5 W, TOWN OF BURNS
 LA CROSSE COUNTY

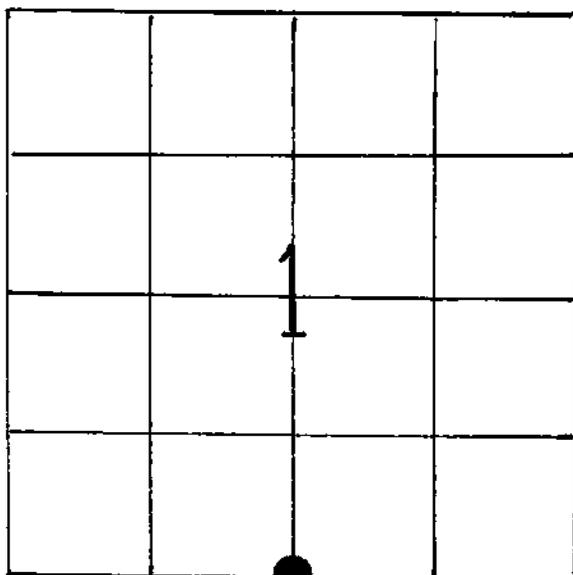

LOCATION OF LANDMARK

WISCONSIN COORDINATE SYSTEM
North
East
Theta Angle
Horiz. Order
Vert. Order
TYPE OF LANDMARK
2" iron pipe
BEARINGS ARE REFERENCED TO
True (\pm 02')

Crew: William C. Jung
 Peter F. Follansbee
 Date: 9/21/92

Describe any record evidence, monument evidence, testimonial evidence or any other material evidence you considered and whether the monument was found or restored through acceptance of an obliterated evidence location.


I found an "ancient" three way fence corner and accepted this location as the best available evidence of the old government corner position. This location was monumented with an iron pipe. A post with a sign was set to the NW of the pipe with a bottle with a shell casing buried between the pipe and sign.

Describe or show any material discrepancy between the location of the restored corner and that of the corner previously restored or reestablished.


None known.

RECORD OF DURABLE WITNESS MONUMENTS
Magnetic

NO	DESCRIPTION	BEARING	DISTANCE
1	P.K. nail in unblazed 21" oak	N25°W	22.87
2	" double oak	N86°W	14.64
3	" 22" white oak	S24°E	10.27
4	P.K. nail in double blazed 8" basswood (?)	N68°E	25.54

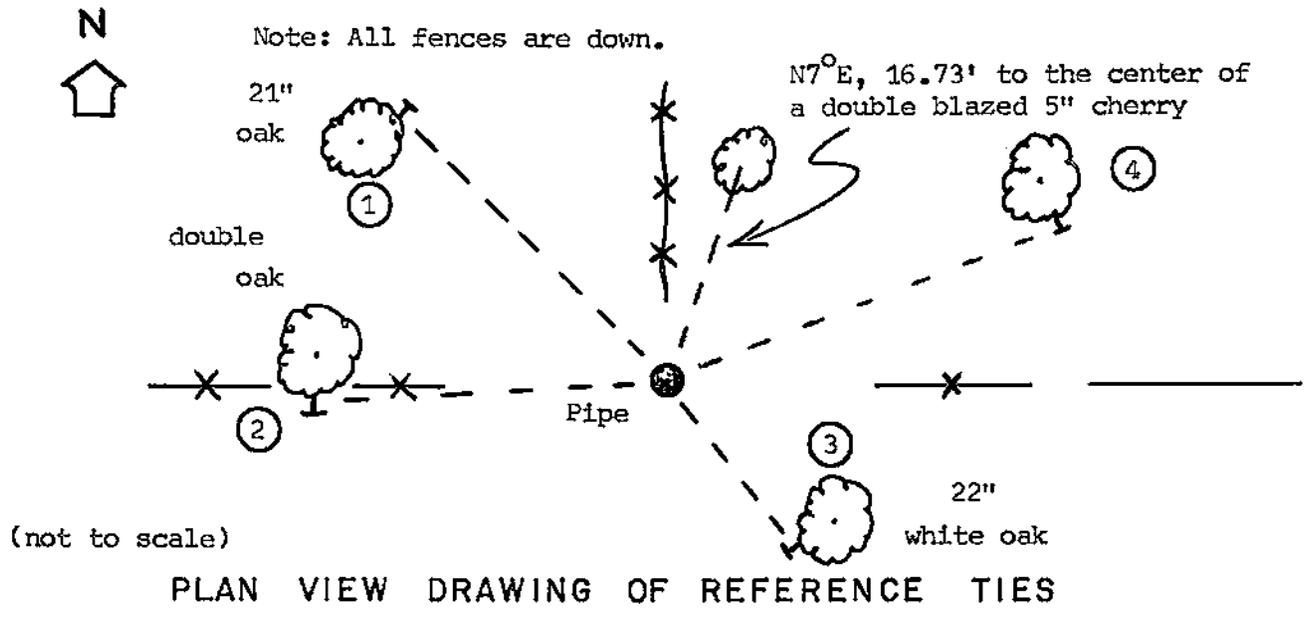


MAP SHOWING DISTANCE AND DIRECTION TO OTHER PUBLIC LAND SURVEY CORNERS USED FOR REESTABLISHING THE CORNER

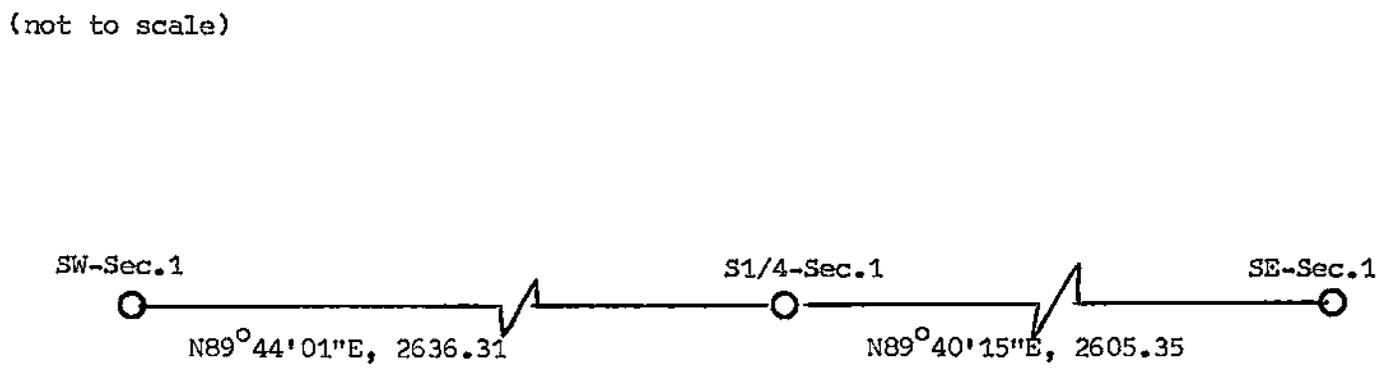

I, William C. Jung, Deputy County Surveyor,
 HEREBY CERTIFY THAT THE CORNER LOCATION SHOWN ON THIS RECORD
 WAS DETERMINED BY ME OR UNDER MY DIRECTION AND CONTROL AND
 THAT THIS U. S. PUBLIC LAND SURVEY MONUMENT RECORD IS CORRECT
 AND COMPLETE TO THE BEST OF MY KNOWLEDGE AND BELIEF.

William C. Jung December 23, 1992
 Signature Date

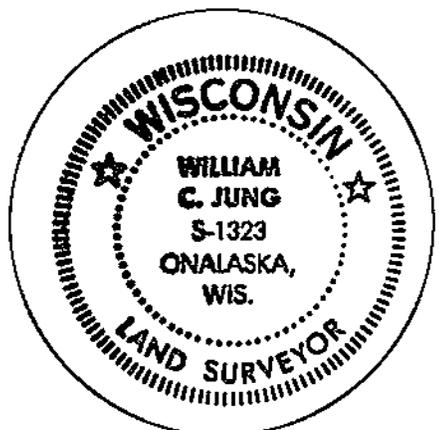

Seal