

CERTIFICATE

CERTIFIED LAND CORNER

I, Harley A. Sime, do hereby certify that on the 26 day of March, 1975, I found ~~(evidence)~~ (no evidence) of the W 1/4 corner of Section 6, T 17 N, R 4 W, Fourth Principal Meridian, and I re-established said corner according to the Wisconsin Statutes as shown and described hereon.

Dated this 14 day of Jan., 1976.


County Surveyor

History of original corner establishment:

Description of corner evidence found:

Accepted "strong" occupied 4-way fence corner as the best available evidence.


Description of corner and witness monuments, references and accessories used to perpetuate the original or re-established location of this corner:
Set Harrison marker, up 6".


Witnesses to corner location:

W.C. Jung - Crew Chief

D. Mallett

A. Lueck

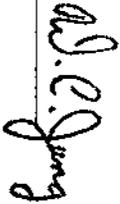

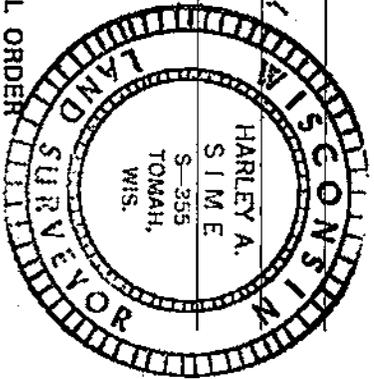


SURVEY CONTROL ORDER

Horizontal



Vertical

Corner	East (X)	North (Y)	Elevation (Z)	Zone
Control Sta. Name				

WISCONSIN COORDINATE SYSTEM

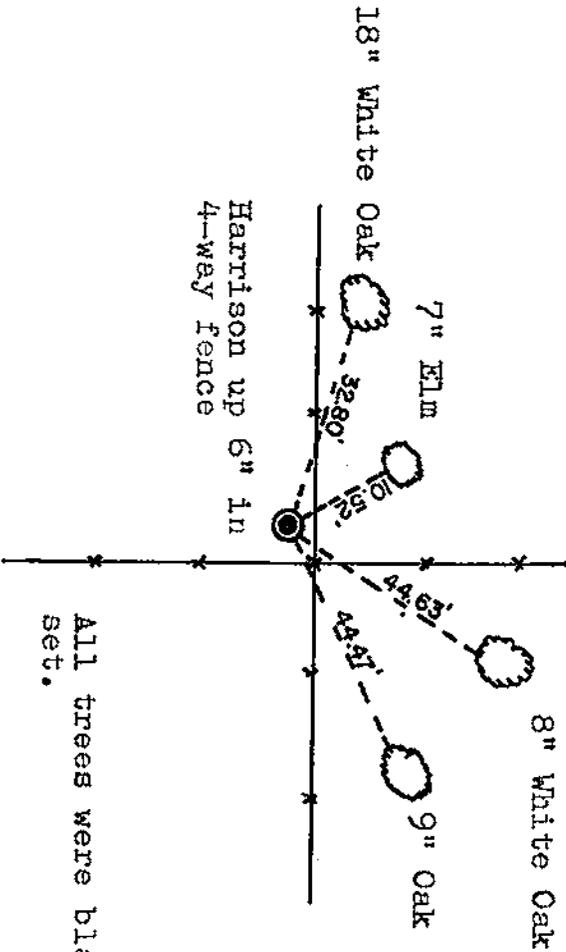

All trees were blazed and n&c set.

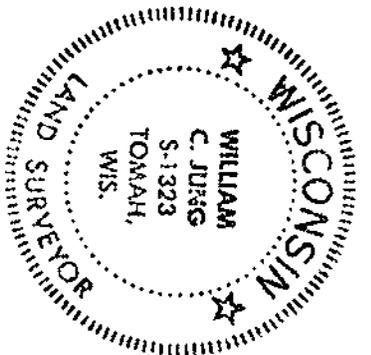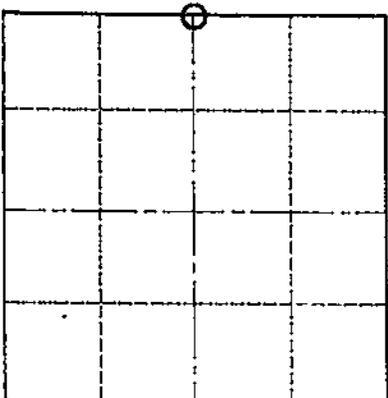

City, Village or Town Sparta
County of Monroe