


21705020000

U. S. PUBLIC LAND SURVEY MONUMENT RECORD

SECTION 1 T 17 N, R 5 W, TOWN OF BURNS

LA CROSSE COUNTY

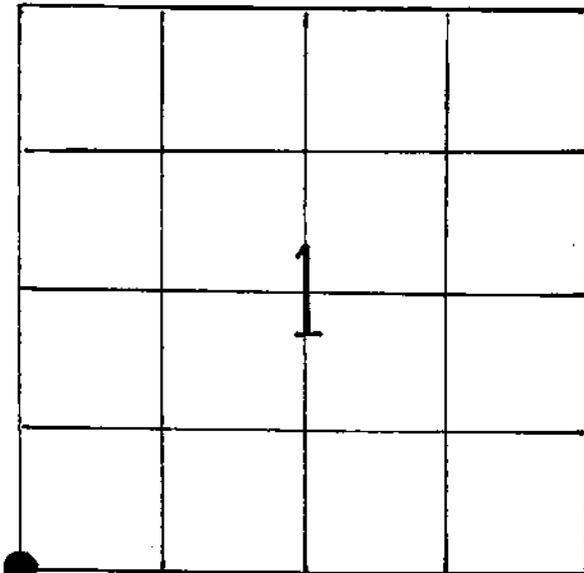

LOCATION OF LANDMARK

Crew: William C. Jung
 Peter F. Follansbee
 Date: 9/23/92

Describe any record evidence, monument evidence, testimonial evidence or any other material evidence you considered and whether the monument was found or restored through acceptance of an obliterated evidence location.

The corner was set at a computed location, on line with the old line fence to the South, and at an average of where the South lines of Sections 1 and 2 would intersect. This location best fits the evidence found in these two sections and the line to the South. I set a brass capped Lunde marker at the corner. The old wire, going to the East from a point 23' South of the Lunde, does not appear to be a good fence. I did not accept it.

Describe or show any material discrepancy between the location of the restored corner and that of the corner previously restored or reestablished.

None known.


WISCONSIN COORDINATE SYSTEM
North
East
Theta Angle
Horiz. Order
Vert. Order
TYPE OF LANDMARK
Brass capped Lunde marker
BEARINGS ARE REFERENCED TO
True ($\pm 02'$)

RECORD OF DURABLE WITNESS MONUMENTS

MAGNETIC

NO	DESCRIPTION	BEARING	DISTANCE
1	P.K. nail in double blazed 7" white oak	S4°E	52.66
2	" 14" white oak	S1°E	from pipe 10.98
3	Set a 1 1/4" iron pipe	S1°E	22.94
4	P.K. nail in double blazed 6" basswood (?)	N86°E	15.04

Set post with sign by Lunde and buried a bottle with a brass shell casing by corner. S67°E, 12.44 feet from the corner is the center of a 31" black oak stump.

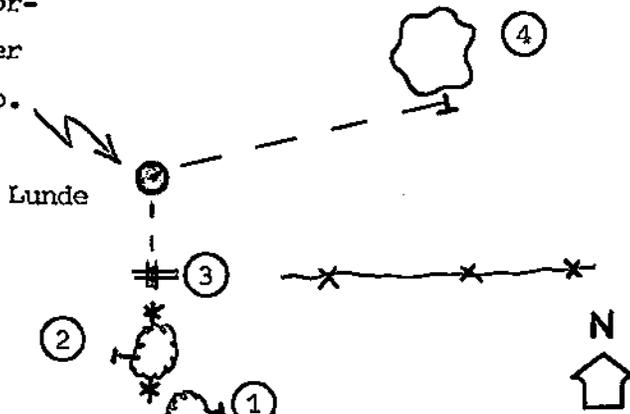


(not to scale)

PLAN VIEW DRAWING OF REFERENCE TIES


MAP SHOWING DISTANCE AND DIRECTION TO OTHER PUBLIC LAND SURVEY CORNERS USED FOR REESTABLISHING THE CORNER

(not to scale)

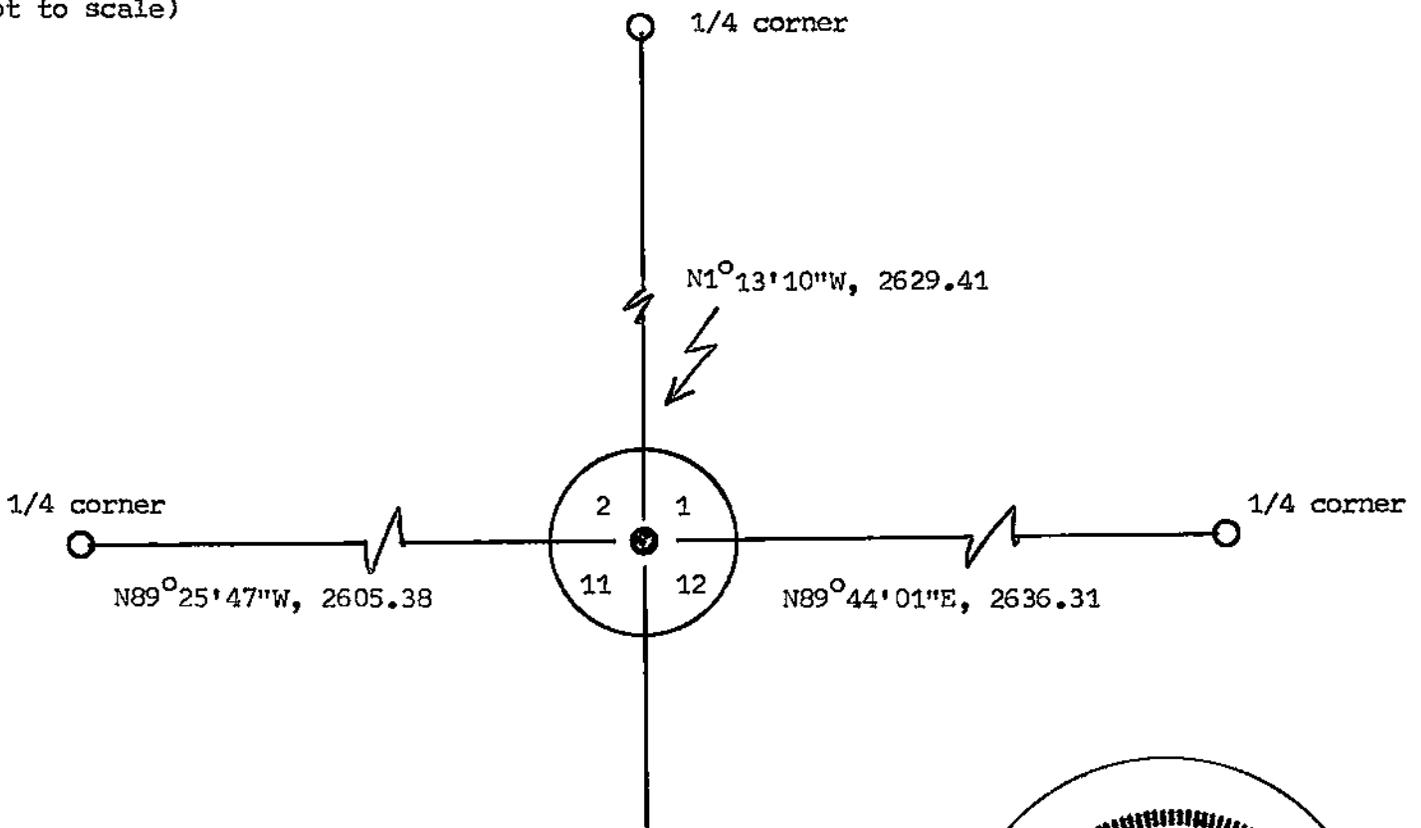

I, William C. Jung, Deputy County Surveyor,
 HEREBY CERTIFY THAT THE CORNER LOCATION SHOWN ON THIS RECORD
 WAS DETERMINED BY ME OR UNDER MY DIRECTION AND CONTROL AND
 THAT THIS U. S. PUBLIC LAND SURVEY MONUMENT RECORD IS CORRECT
 AND COMPLETE TO THE BEST OF MY KNOWLEDGE AND BELIEF.

William C. Jung October 8, 1992
 Signature Date

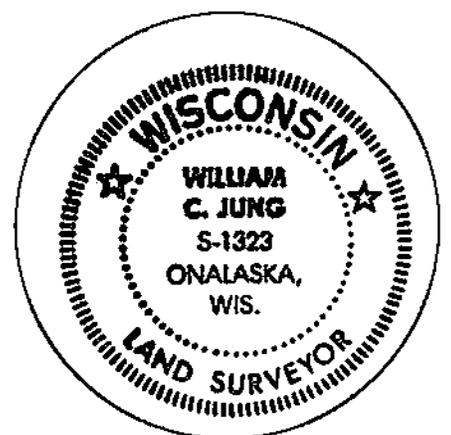

Seal