


U. S. PUBLIC LAND SURVEY MONUMENT RECORD

SECTION 1 T 17 N, R 5 W, TOWN OF BURNS

LA CROSSE COUNTY

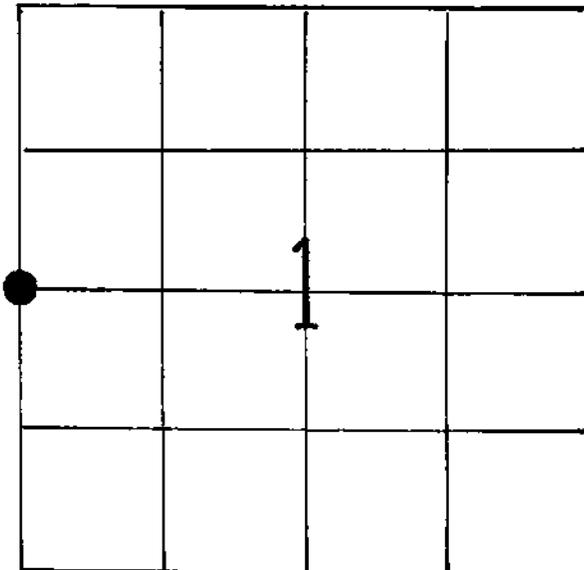

LOCATION OF LANDMARK

WISCONSIN COORDINATE SYSTEM
North
East
Theta Angle
Horiz. Order
Vert. Order
TYPE OF LANDMARK
Set brass cap Lunde marker.
BEARINGS ARE REFERENCED TO
True North (+ 02')

Crew: WILLIAM C. JUNG  
 PETER F. FOLLANSBEE

Date: 9/22/1992

Describe any record evidence, monument evidence, testimonial evidence or any other material evidence you considered and whether the monument was found or restored through acceptance of an obliterated evidence location.


I set the corner off of what I feel is the original government bearing tree to the Southwest. The old tree is "knarled" and appears to have the remnants of a scar on the Northeast side. The tree may also be hollow. The corner was monumented with a Lunde and falls 7' SW of the occupied corner and 6' West of the fence.

Describe or show any material discrepancy between the location of the restored corner and that of the corner previously restored or reestablished.

None Known.


**RECORD OF DURABLE WITNESS MONUMENTS  
MAGNETIC**

NO	DESCRIPTION	BEARING	DISTANCE
1	Set P.K. Nail on SE-side lg. White Oak	S 59.5° W	60.83 Ft.
2	Set P.K. Nail on SW-side 5" White Oak	N 38° W	9.05 Ft.
3	Set P.K. Nail on E-side 4" Oak	N 04° W	12.35 Ft.
4	Set P.K. Nail on SE-side 6" Oak	N 55° E	14.92 Ft.

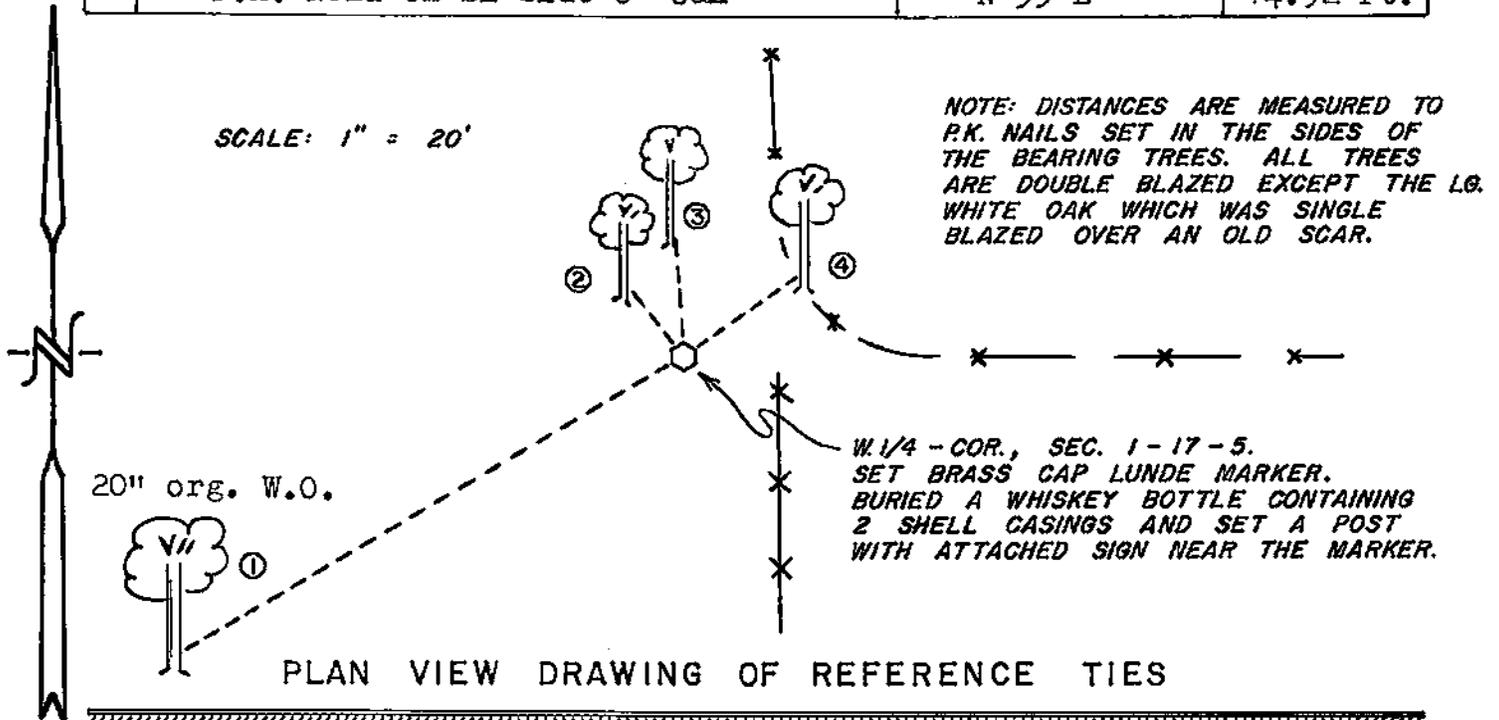

**MAP SHOWING DISTANCE AND DIRECTION TO OTHER PUBLIC LAND SURVEY CORNERS USED FOR REESTABLISHING THE CORNER**


(not to scale)

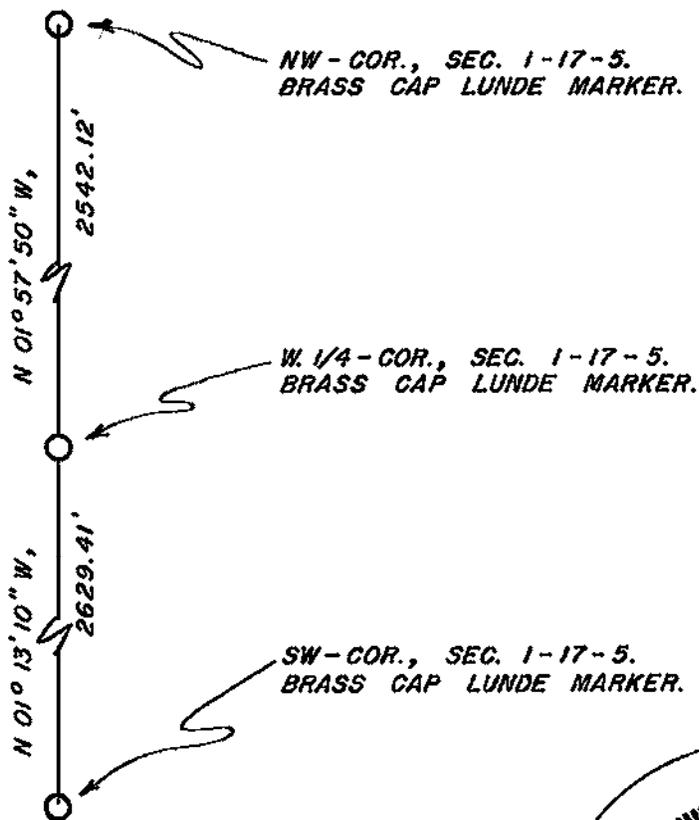

I, William C. Jung, Deputy County Surveyor  
HEREBY CERTIFY THAT THE CORNER LOCATION SHOWN ON THIS RECORD WAS DETERMINED BY ME OR UNDER MY DIRECTION AND CONTROL AND THAT THIS U. S. PUBLIC LAND SURVEY MONUMENT RECORD IS CORRECT AND COMPLETE TO THE BEST OF MY KNOWLEDGE AND BELIEF.

William C. Jung  
Signature

December 23, 1992  
Date

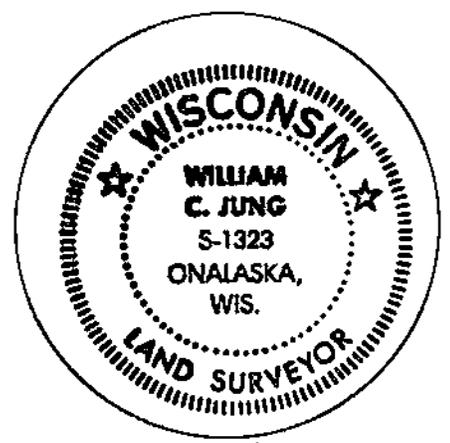

Seal