


U. S. PUBLIC LAND SURVEY MONUMENT RECORD

SECTION 2 T 17 N, R 5 W, TOWN OF BURNS

LA CROSSE COUNTY

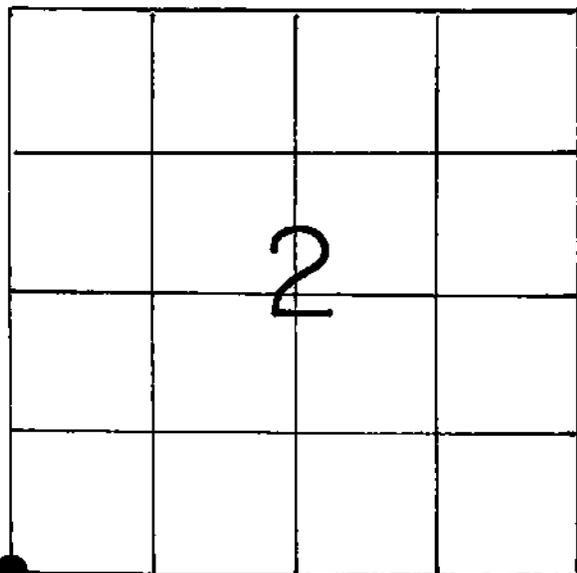

LOCATION OF LANDMARK

WISCONSIN COORDINATE SYSTEM
North
East
Theta Angle
Horiz. Order
Vert. Order

TYPE OF LANDMARK
Set 2" x 30" I.P. over exist I.P.

BEARINGS ARE REFERENCED TO

True (± 02')

Crew: WILLIAM C. JUNG
PETER F. FOLLANSBEE

Date: 9/24/1992

Describe any record evidence, monument evidence, testimonial evidence or any other material evidence you considered and whether the monument was found or restored through acceptance of an obliterated evidence location.


I found an iron pipe at the corner. This pipe had been used as the corner in previous survey work. I accepted this pipe as the best available evidence of the original government corner position. A larger pipe was set over the existing pipe. The pipe is about 180 feet West of the creek centerline and about 1339 feet West of an old "40" fence corner.

Describe or show any material discrepancy between the location of the restored corner and that of the corner previously restored or reestablished.

None Known.


RECORD OF DURABLE WITNESS MONUMENTS

NO	DESCRIPTION	BEARING	DISTANCE
1	Set Railroad Spike in centerline	West \pm	32.13 Ft.
2	Set 1 1/4" Iron Pipe flush in pasture	N 39° E (Mag)	53.10 Ft.
3	Set 7/8" Hexagon Bit under fence	East \pm	65.97 Ft.
4	Set P.K. Nail in N.-side large Maple	East \pm	134.20 Ft.

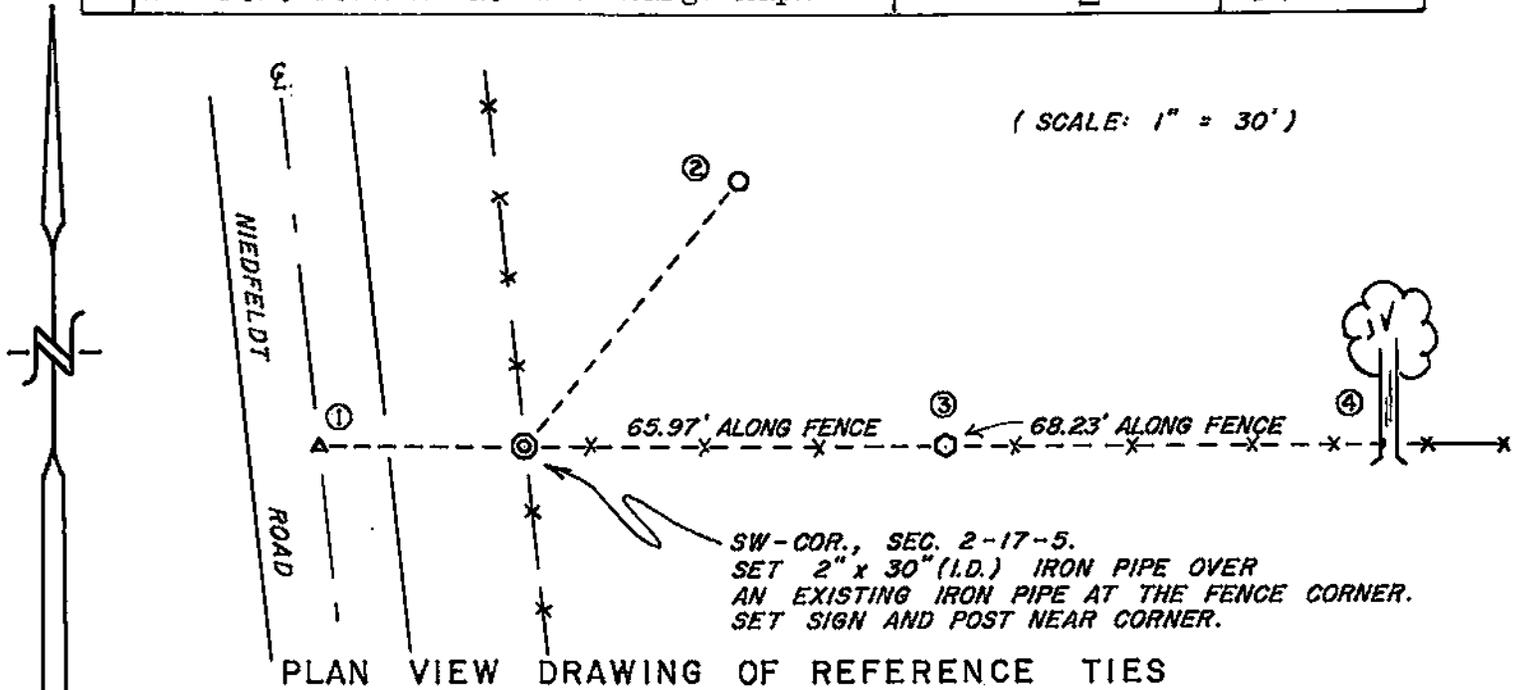

MAP SHOWING DISTANCE AND DIRECTION TO OTHER PUBLIC LAND SURVEY CORNERS USED FOR REESTABLISHING THE CORNER

(not to scale)

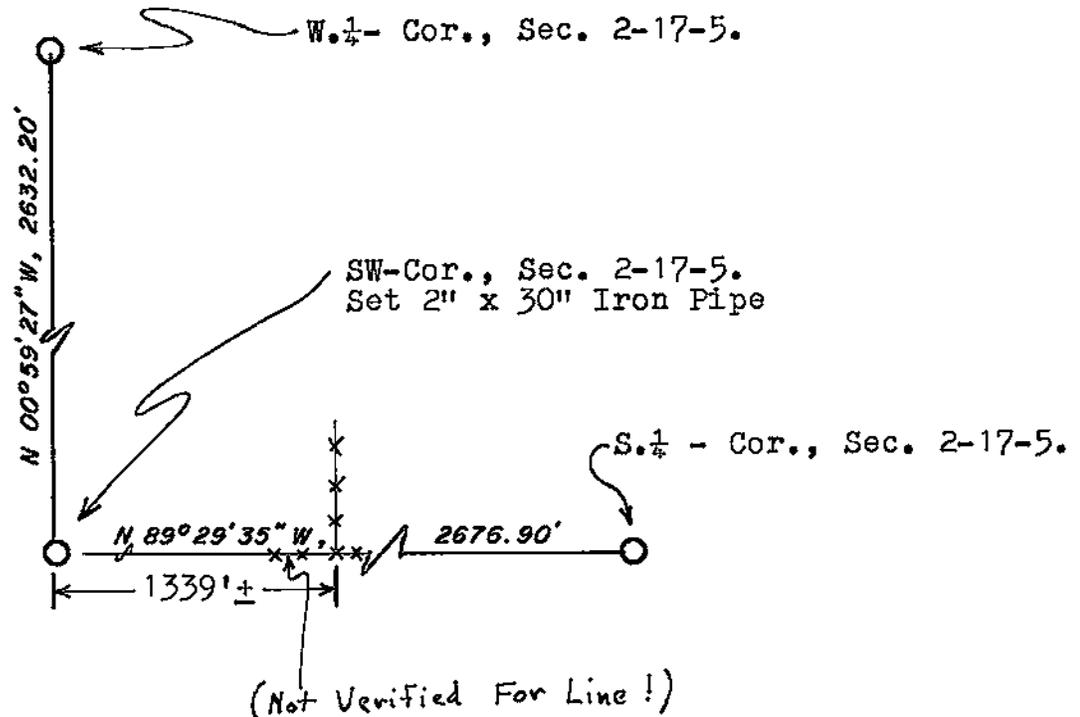

I, William C. Jung, Deputy County Surveyor
 HEREBY CERTIFY THAT THE CORNER LOCATION SHOWN ON THIS RECORD
 WAS DETERMINED BY ME OR UNDER MY DIRECTION AND CONTROL AND
 THAT THIS U. S. PUBLIC LAND SURVEY MONUMENT RECORD IS CORRECT
 AND COMPLETE TO THE BEST OF MY KNOWLEDGE AND BELIEF.

William C. Jung
 Signature

December 29, 1992
 Date



Seal