


21705030020

## U. S. PUBLIC LAND SURVEY MONUMENT RECORD

SECTION 10 T 17 N, R 5 W, TOWN OF BURNS

LA CROSSE COUNTY

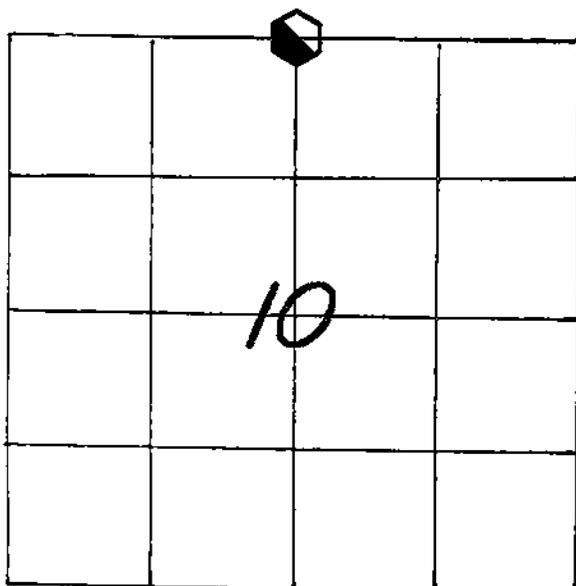

LOCATION OF LANDMARK

CREW: WILLIAM C. JUNG  
 PETER F. FOLLANSBEE  
 DATE: 4/20/2005

## WISCONSIN COORDINATE SYSTEM

North 720,059.701

East 1,715,261.609

Theta Angle

Horiz. Order

Vert. Order

DATUM: 1983('91)

## TYPE OF LANDMARK

3/4" x 30" ALUMINUM BERNTSEN MARKER.

BEARINGS ARE REFERENCED TO

GRID NORTH AS PER SECTION DATA.

Describe any record evidence, monument evidence, testimonial evidence or any other material evidence you considered and whether the monument was found or restored through acceptance of an obliterated evidence location.

I set this corner equidistant between the section corners and on line with the old line fence to the East. A Berntsen marker was set at the corner. I feel that the old fence line to the East is evidence of the line actually surveyed.


Describe or show any material discrepancy between the location of the restored corner and that of the corner previously restored or reestablished.

**NONE KNOWN.**

RECORD OF DURABLE WITNESS MONUMENTS


MAGNETIC

NO	DESCRIPTION	BEARING	DISTANCE
1	SET A NAIL IN S.W.-SIDE OF A 22" OAK	N 35° W	SLOPE = 5.77'
2	SET A NAIL IN E.-SIDE OF A 7-1/2" WHITE OAK	N 03° W	41.73 FT.
3	SET A NAIL IN S.-SIDE OF A 9" WHITE OAK	N 79° E	28.15 FT.
4	SET A NAIL IN N.-SIDE OF A 10" WHITE OAK	S 55° W	37.55 FT.

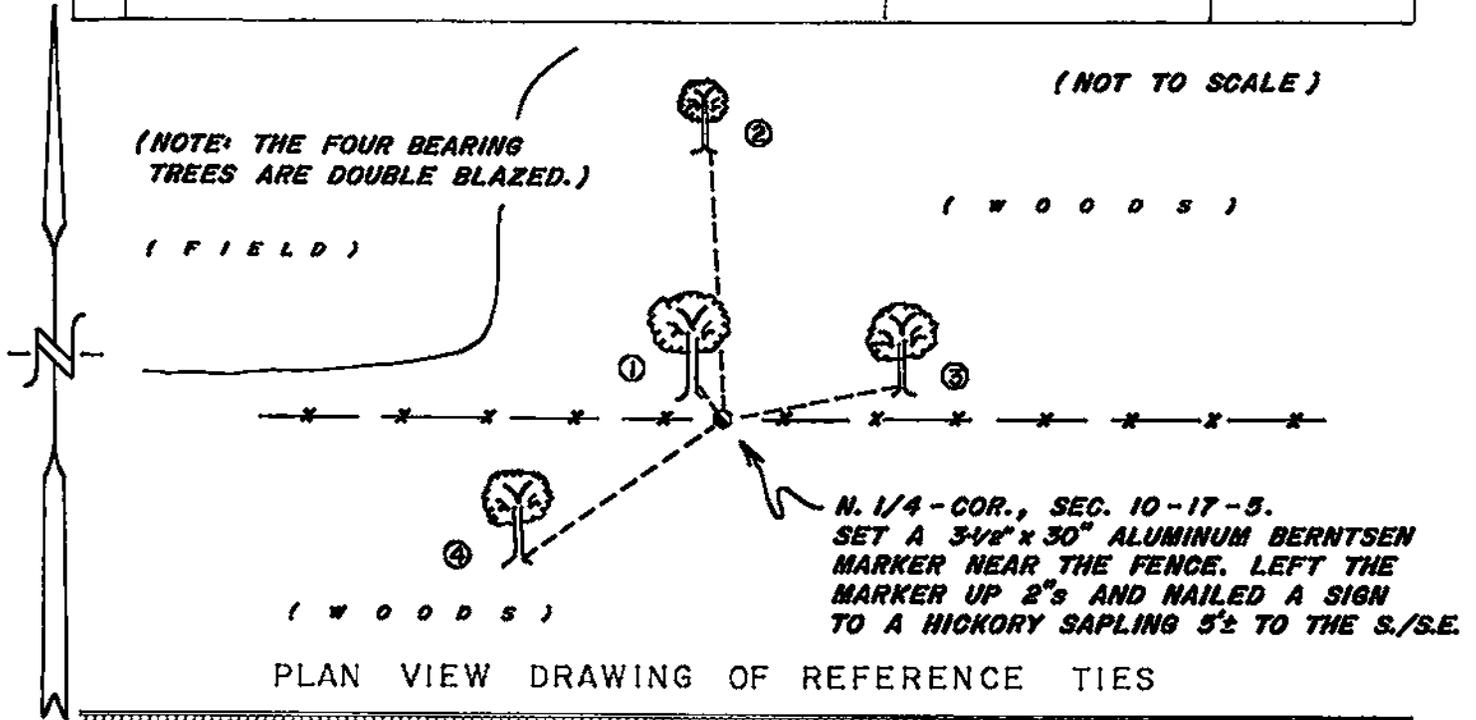


MAP SHOWING DISTANCE AND DIRECTION TO OTHER PUBLIC LAND SURVEY CORNERS USED FOR REESTABLISHING THE CORNER

(GRID BEARINGS AND DISTANCES)  
(GRID FACTOR: 0.999939)  
(NOT TO SCALE)

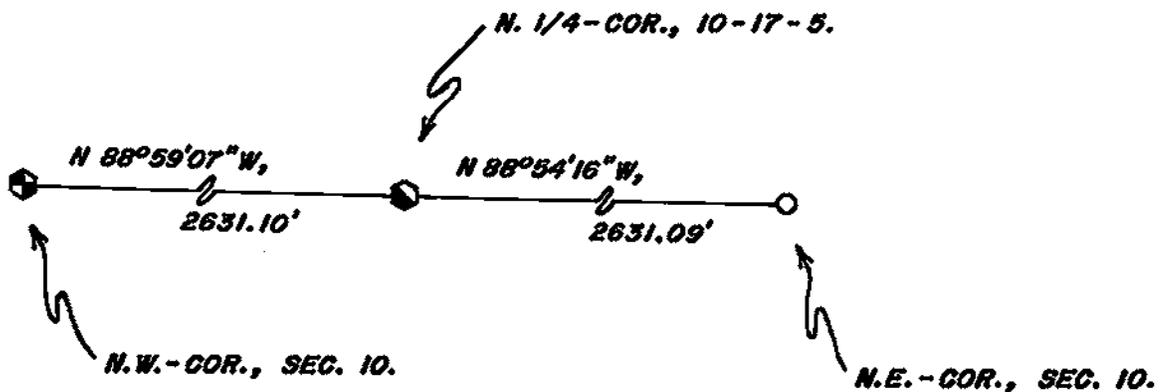

I, WILLIAM C. JUNG, COUNTY SURVEYOR  
HEREBY CERTIFY THAT THE CORNER LOCATION SHOWN ON THIS RECORD WAS DETERMINED BY ME OR UNDER MY DIRECTION AND CONTROL AND THAT THIS U. S. PUBLIC LAND SURVEY MONUMENT RECORD IS CORRECT AND COMPLETE TO THE BEST OF MY KNOWLEDGE AND BELIEF.

William C. Jung 7/1/05  
Signature Date

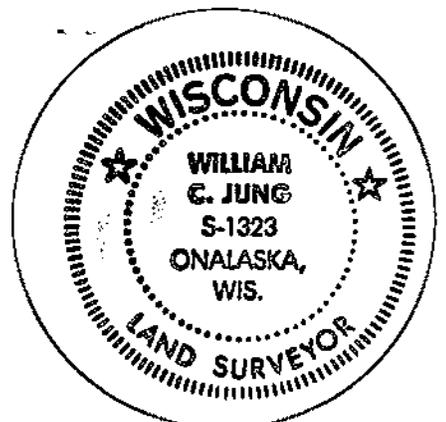

Seal