


21705032000

U. S. PUBLIC LAND SURVEY MONUMENT RECORD

SECTION 2 T 17 N, R 5 W, TOWN OF BURNS

LA CROSSE COUNTY

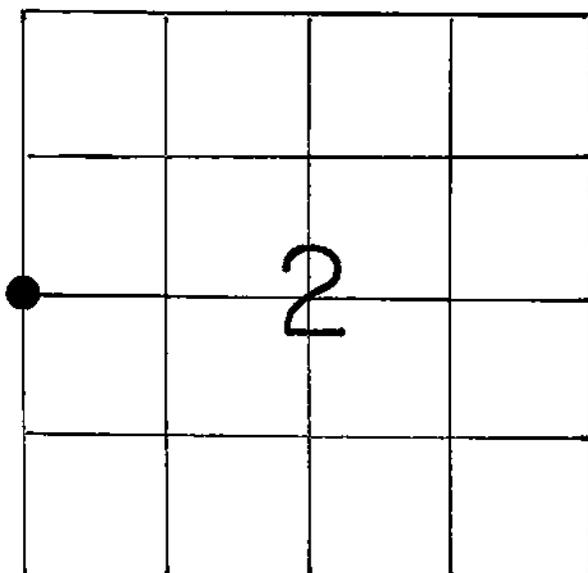

LOCATION OF LANDMARK

Crew: WILLIAM C. JUNG
PETER F. FOLLANSBEE

Date: 9/21/1992

Describe any record evidence, monument evidence, testimonial evidence or any other material evidence you considered and whether the monument was found or restored through acceptance of an obliterated evidence location.

I set the corner by an East-West fence tie post. Mr. Norman Berg, a lifelong resident of this area, told me that he put this new post where the old one used to be. It was common for farmers at a location like this to tie their wire off at the government corner. I accepted this location as the best available evidence of the original government corner position. The error that I found at this corner is typical of what I find in the retracement of the original surveys in regard to error in distance and alignment.

Describe or show any material discrepancy between the location of the restored corner and that of the corner previously restored or reestablished.

None Known

WISCONSIN COORDINATE SYSTEM

North

East

Theta Angle

Horiz. Order

Vert. Order

TYPE OF LANDMARK


Set brass cap Lunde marker.

BEARINGS ARE REFERENCED TO

True ($\pm 02'$)


RECORD OF DURABLE WITNESS MONUMENTS

NO	DESCRIPTION	BEARING	DISTANCE
1	Set P.K. Nail in N.-side 6" multi-Cherry	(In fence)	55.29 Ft.
2	Set P.K. Nail in NE-side 5" Box Elder	(3.2' N.-fence)	2.85 Ft.
3	Set P.K. Nail in NE-side 6" tr'pl Box El.	(4.3' S.-fence)	Sl.=8.2'
4	Set P.K. Nail in NE-side 6" Box Elder	(5.5' S.-fence)	Sl.=26.61'

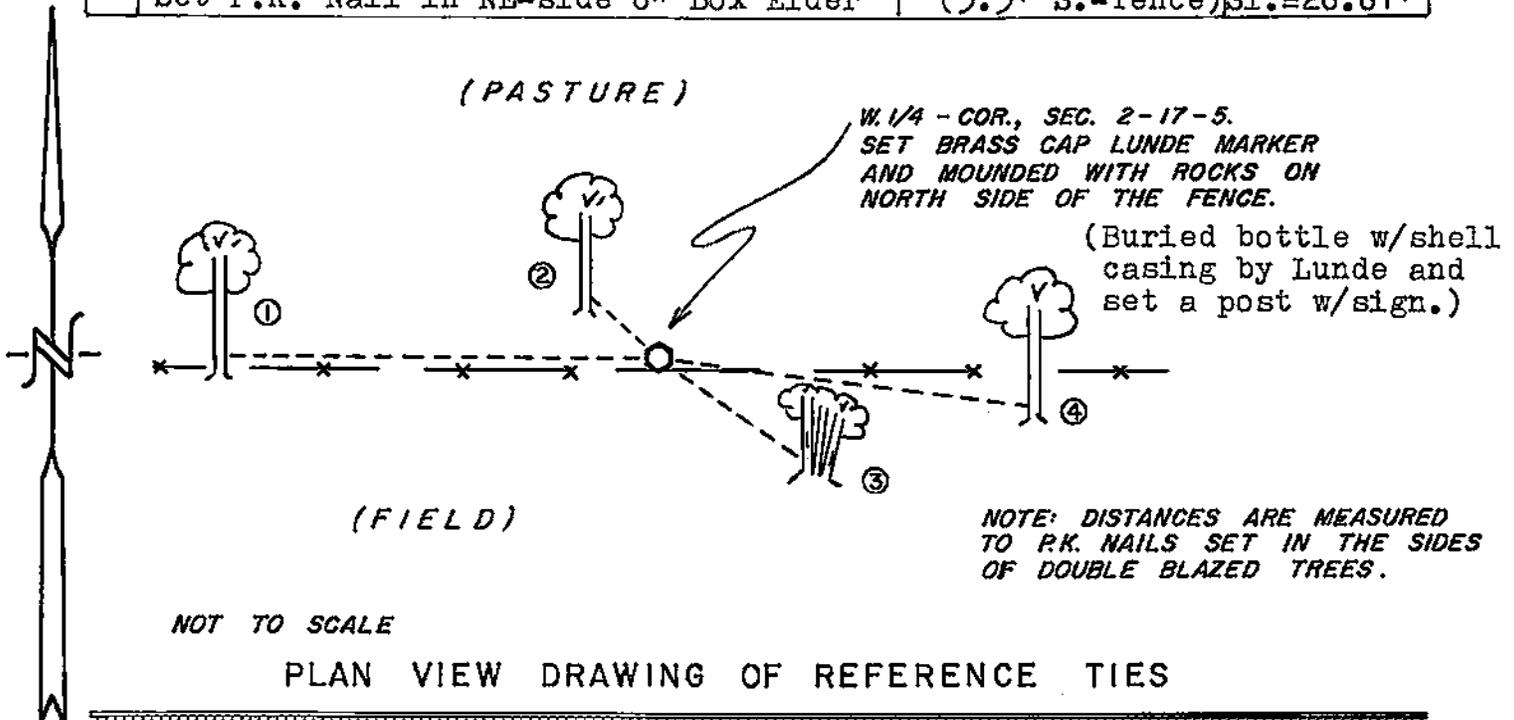

MAP SHOWING DISTANCE AND DIRECTION TO OTHER PUBLIC LAND SURVEY CORNERS USED FOR REESTABLISHING THE CORNER

(not to scale)

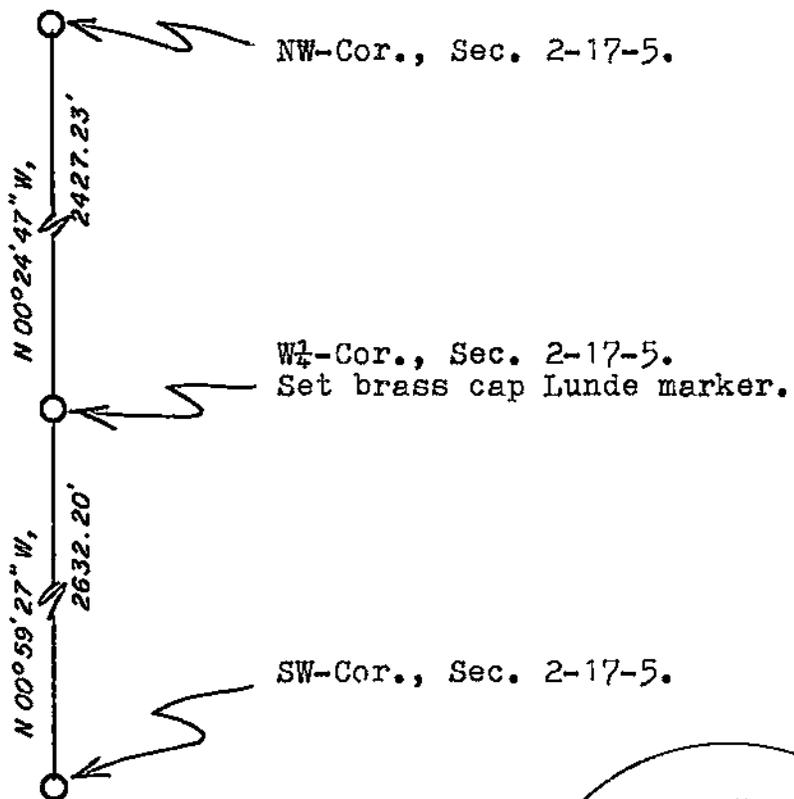

I, William C. Jung, Deputy County Surveyor
HEREBY CERTIFY THAT THE CORNER LOCATION SHOWN ON THIS RECORD
WAS DETERMINED BY ME OR UNDER MY DIRECTION AND CONTROL AND
THAT THIS U. S. PUBLIC LAND SURVEY MONUMENT RECORD IS CORRECT
AND COMPLETE TO THE BEST OF MY KNOWLEDGE AND BELIEF.

William C. Jung December 29, 1992
Signature Date

