


U. S. PUBLIC LAND SURVEY MONUMENT RECORD

SECTION 4 T 17 N, R 5 W, TOWN OF BURNS
 LA CROSSE COUNTY

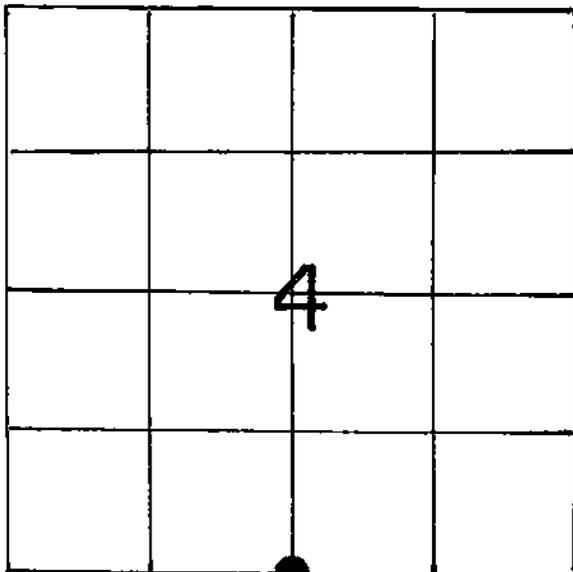

LOCATION OF LANDMARK

Crew: William C. Jung
 Peter Follansbee

Date: 3/1/90

WISCONSIN COORDINATE SYSTEM
North
East
Theta Angle
Horiz. Order
Vert. Order
TYPE OF LANDMARK
1"x30" iron pipe Lunde marker
BEARINGS ARE REFERENCED TO
Assumed

Crew: Peter Follansbee Crew: Jung
 Daniel Leis Follansbee

Date: 6/27/90 Date: 5/9/07

Describe any record evidence, monument evidence, testimonial evidence or any other material evidence you considered and whether the monument was found or restored through acceptance of an obliterated evidence location.

I projected a line from the Southeast section corner through the occupied corner at the S1/16SE and intersected this line with the old line fence going South from the South 1/4 Corner. As set, this location fits the field evidence and conditions very well. I set a 1" iron pipe at the corner.

The iron pipe was replaced by a Lunde on 6/27/90. The Lunde is up 6" and mounded with sandstones. A sign was put on a birch to the Southeast.


Describe or show any material discrepancy between the location of the restored corner and that of the corner previously restored or reestablished.

None known


5/9/07
 The Lunde was found in "good repair" with all four bearing trees standing. A sign and post were set.

RECORD OF DURABLE WITNESS MONUMENTS
MAGNETIC

NO	DESCRIPTION	BEARING	DISTANCE
1	P.K. nail in 8" double blazed black oak	N7°E	slope=39.12
2	" " " 4" " " aspen	S59°E	44.68
3	" " " single blazed triple white oak	S3°E	29.07
4	" " " 6" double blazed black oak	S29°W	26.79

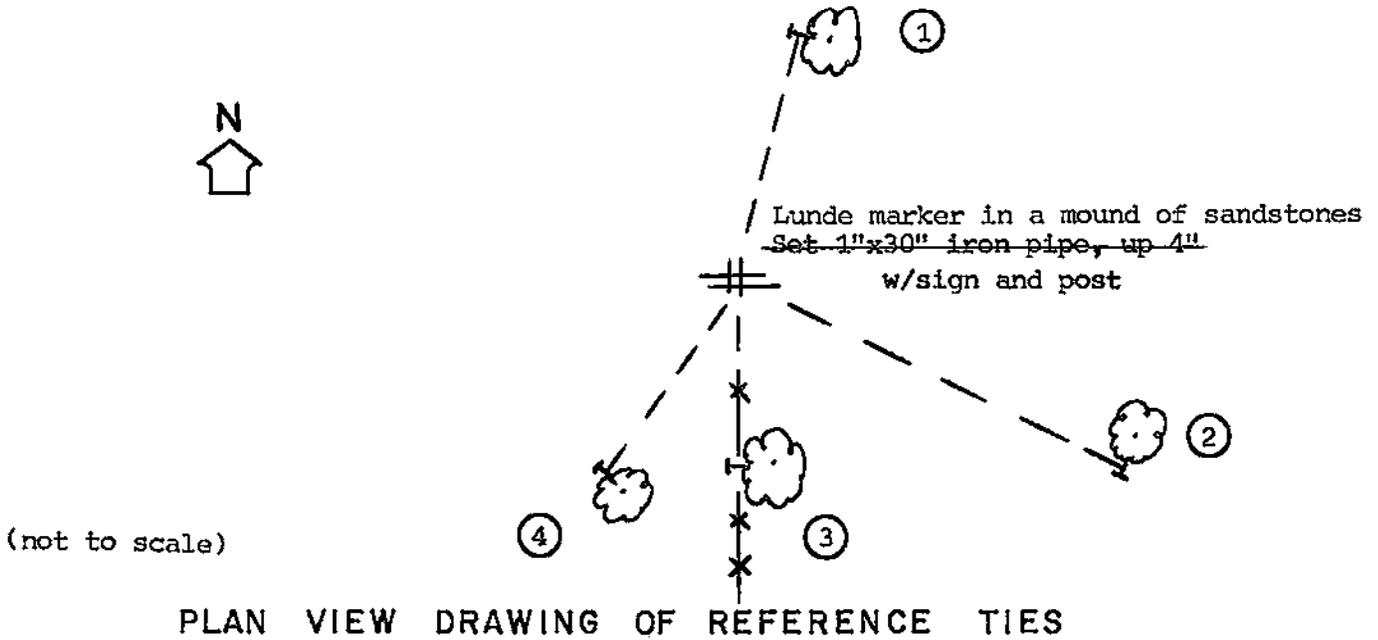

MAP SHOWING DISTANCE AND DIRECTION TO OTHER PUBLIC LAND SURVEY CORNERS USED FOR REESTABLISHING THE CORNER

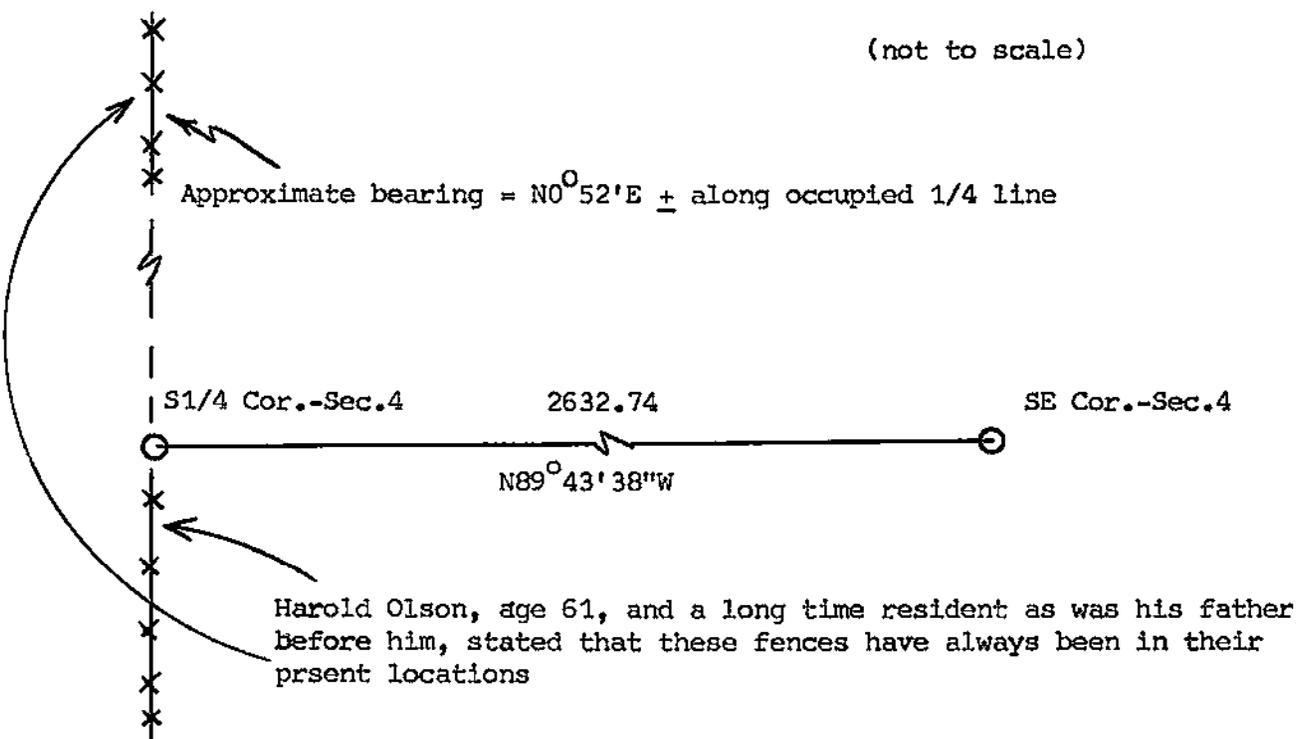

I, William C. Jung, Deputy County Surveyor,
 HEREBY CERTIFY THAT THE CORNER LOCATION SHOWN ON THIS RECORD
 WAS DETERMINED BY ME OR UNDER MY DIRECTION AND CONTROL AND
 THAT THIS U. S. PUBLIC LAND SURVEY MONUMENT RECORD IS CORRECT
 AND COMPLETE TO THE BEST OF MY KNOWLEDGE AND BELIEF.

William C. Jung 3/2/90
 Signature Date

Revised: 2/13/91
 " 5/18/07 *W.C.J.*

