


21705042000

U. S. PUBLIC LAND SURVEY MONUMENT RECORD

SECTION 3 T 17 N, R 5 W, TOWN OF BURNS

LA CROSSE COUNTY

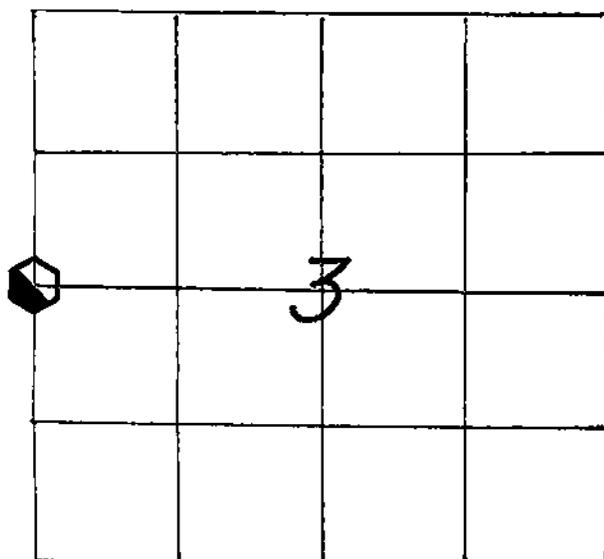

LOCATION OF LANDMARK

CREW: WILLIAM C. JUNG
 PETER F. FOLLANSBEE
 DATE: 5/08/2007

WISCONSIN COORDINATE SYSTEM

North 722,729.132

East 1,712,633.569

Theta Angle

Horiz. Order

Vert. Order

DATUM: 1983 ('91)

TYPE OF LANDMARK

30" ALUMINUM BERNTSEN MARKER.

BEARINGS ARE REFERENCED TO

GRID NORTH AS PER SECTION DATA.

Describe any record evidence, monument evidence, testimonial evidence or any other material evidence you considered and whether the monument was found or restored through acceptance of an obliterated evidence location.

At one time decades ago this corner position was also a property corner as the "40" to the Southeast was owned by others than the Hoth family. At that time there was a fence corner at the 1/4 corner. After inspecting the old line fence to the South (now a pasture fence as the Hoth family now owns said "40"), I found what I believe to be the old fence corner location at the 1/4 corner location. Gerald Hoth, age 70 and lifelong resident, said that my corner location indeed occupies the position of the old fence corner. I therefore*****

Describe or show any material discrepancy between the location of the restored corner and that of the corner previously restored or reestablished.

NONE KNOWN.


*****continued

accepted the old fence corner location as the best available evidence of the original government corner position and set a Berntsen marker. Proportionately, this corner fits within about three inches between the section corners. The corner is about nine feet off line, but after many years of retracing government surveys in this county, I find this to be about normal.

(over)


RECORD OF DURABLE WITNESS MONUMENTS

NO	DESCRIPTION	GRID BEARINGS	GROUND DIST.'s
		BEARING	DISTANCE
1	SET A 1/4"(o.d.) x 26-1/2" IRON PIPE IN FENCE-LINE	S 00°29'51" E	285.47 FT.
2	SET A 3/4" x 21" REBAR ON DOWNSLOPE OF HIGH KNOB	S 30°56'42" W	244.82 FT.
3	SET A 1"(o.d.) x 29" IRON PIPE WITH THE TOP CURLED	S 49°22'44" W	244.24 FT.
4	SET A 1/4"(o.d.) x 24" IRON PIPE ON A PASTURED SLOPE	S 72°09'44" W	274.63 FT.

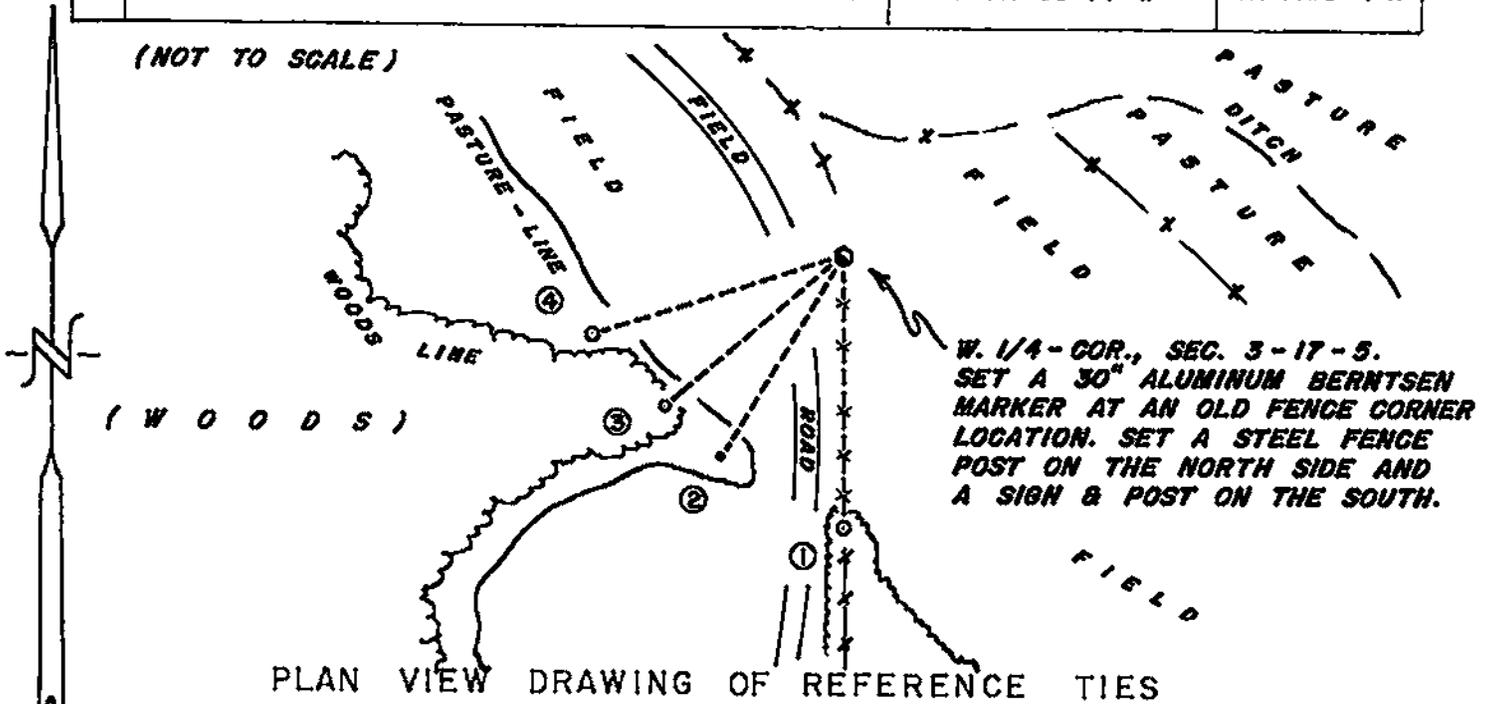

MAP SHOWING DISTANCE AND DIRECTION TO OTHER PUBLIC LAND SURVEY CORNERS USED FOR REESTABLISHING THE CORNER


(GRID BEARINGS AND DISTANCES)
 (GRID FACTOR: 0.999939)
 (NOT TO SCALE)

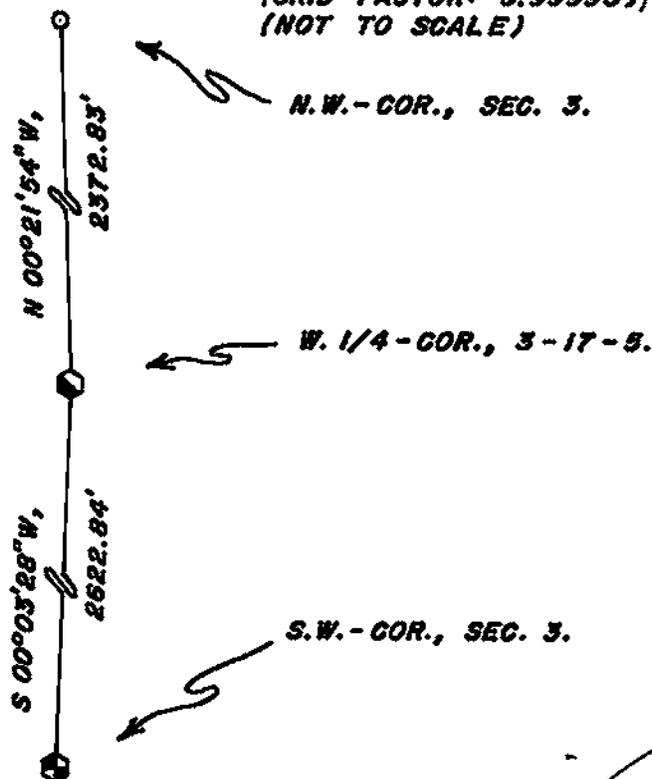

I, WILLIAM C. JUNG, COUNTY SURVEYOR
 HEREBY CERTIFY THAT THE CORNER LOCATION SHOWN ON THIS RECORD WAS DETERMINED BY ME OR UNDER MY DIRECTION AND CONTROL AND THAT THIS U. S. PUBLIC LAND SURVEY MONUMENT RECORD IS CORRECT AND COMPLETE TO THE BEST OF MY KNOWLEDGE AND BELIEF.

William C. Jung
 Signature

5/18/07
 Date

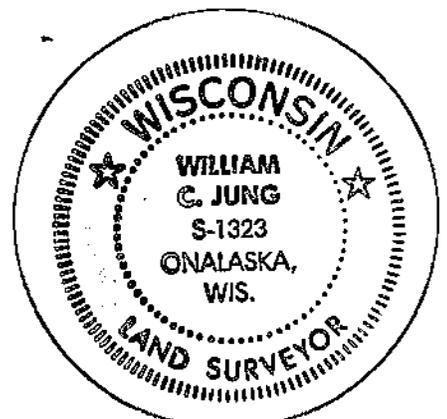

Seal