


21705050000

U. S. PUBLIC LAND SURVEY MONUMENT RECORD

SECTION 5 T 17 N, R 5 W, TOWN OF BURNS
 LA CROSSE COUNTY

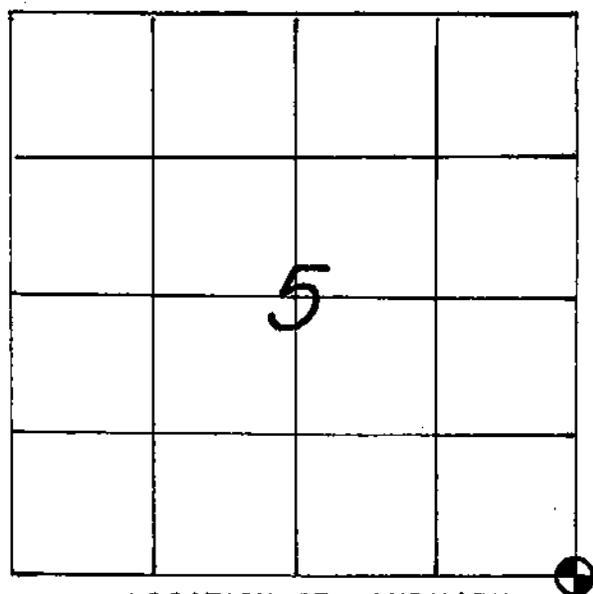

LOCATION OF LANDMARK

WISCONSIN COORDINATE SYSTEM

North

East

Theta Angle

Horiz. Order

Vert. Order

TYPE OF LANDMARK

1" x 30" Iron Pipe

BEARINGS ARE REFERENCED TO

TRUE NORTH.

Crew: William C. Jung
 Peter F. Follansbee
 Date: 10/30/1995

Describe any record evidence, monument evidence, testimonial evidence or any other material evidence you considered and whether the monument was found or restored through acceptance of an obliterated evidence location.

of the corner


The existing occupied fences in this area are "wild" and cannot be relied upon. After surveying along the South line of Section 5 and the East line of the SE1/4 of Section 5 and collecting field evidence, I set the corner at a location that best fits the occupied conditions. I set an iron pipe at the corner.

Describe or show any material discrepancy between the location of the restored corner and that of the corner previously restored or reestablished.

None Known.

RECORD OF DURABLE WITNESS MONUMENTS


NO	DESCRIPTION	BEARING	DISTANCE
1	Set P.K. Nail in NW-side 10½" White Oak	N 23° E (Mag.)	29.29 Ft.
2	Ex. 1" x 30" Iron Pipe near fence (my survey points)	N 32° E (Mag.)	51.81 Ft.
3	Ex. Drill Point at fence intersection	N 55° 40' 09" E (Tr.)	146.71 Ft.
4	Set P.K. Nail in NE-side 14½" White Oak	S 79° E (Mag.)	28.28 Ft.

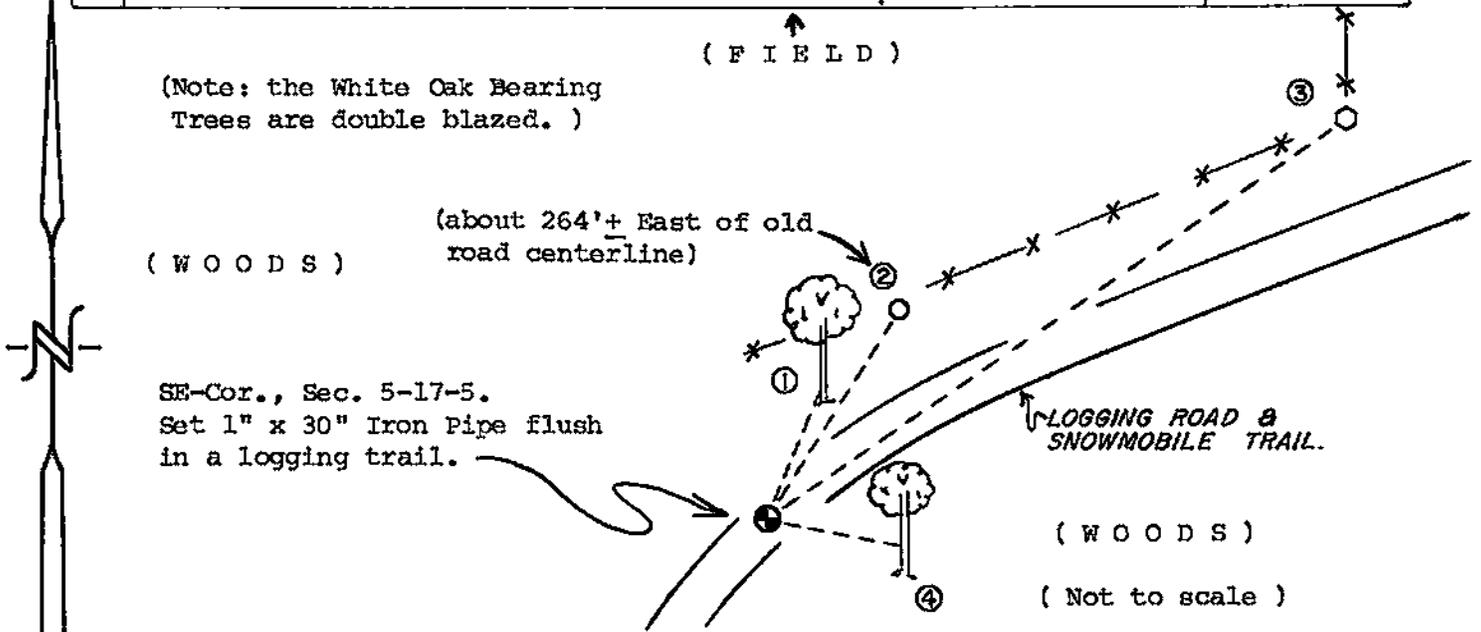

PLAN VIEW DRAWING OF REFERENCE TIES


MAP SHOWING DISTANCE AND DIRECTION TO OTHER PUBLIC LAND SURVEY CORNERS USED FOR REESTABLISHING THE CORNER

(Not to scale)

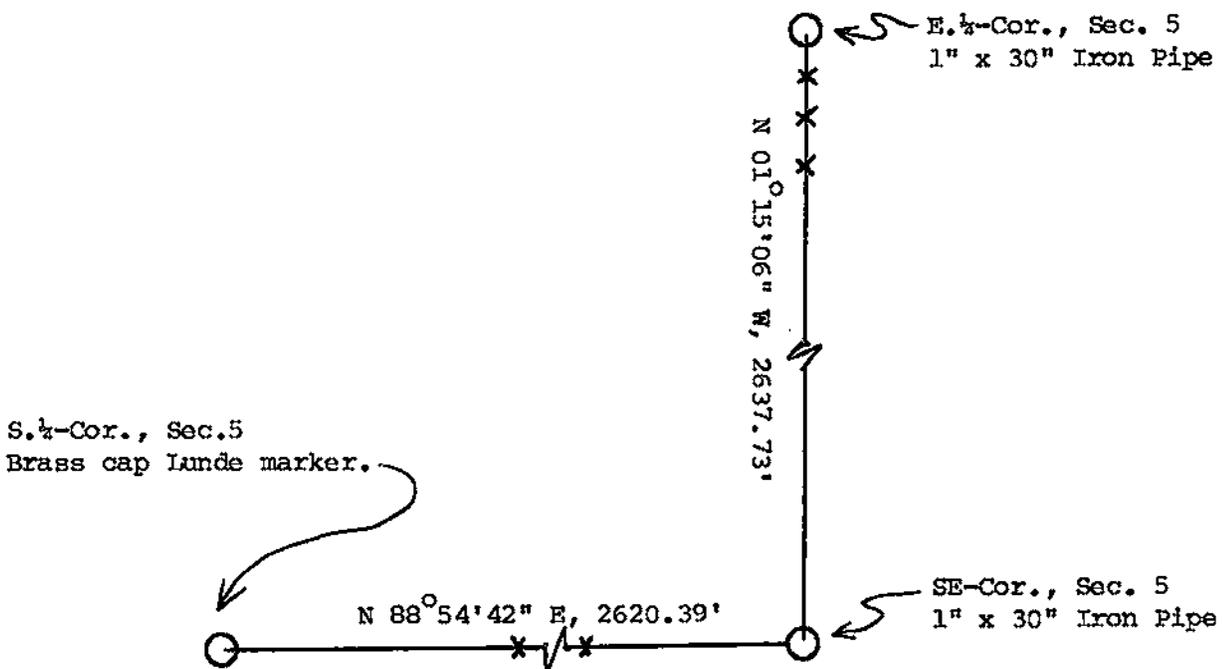

I, William C. Jung, County Surveyor
HEREBY CERTIFY THAT THE CORNER LOCATION SHOWN ON THIS RECORD WAS DETERMINED BY ME OR UNDER MY DIRECTION AND CONTROL AND THAT THIS U. S. PUBLIC LAND SURVEY MONUMENT RECORD IS CORRECT AND COMPLETE TO THE BEST OF MY KNOWLEDGE AND BELIEF.

William C. Jung 12/13/95
Signature Date

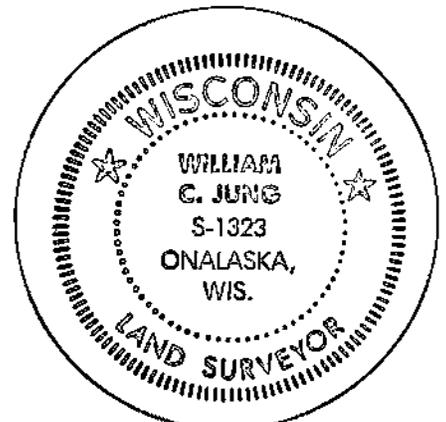

Seal