


U. S. PUBLIC LAND SURVEY MONUMENT RECORD

SECTION 5 T 17 N, R 5 W, TOWN OF BURNS
 LA CROSSE COUNTY

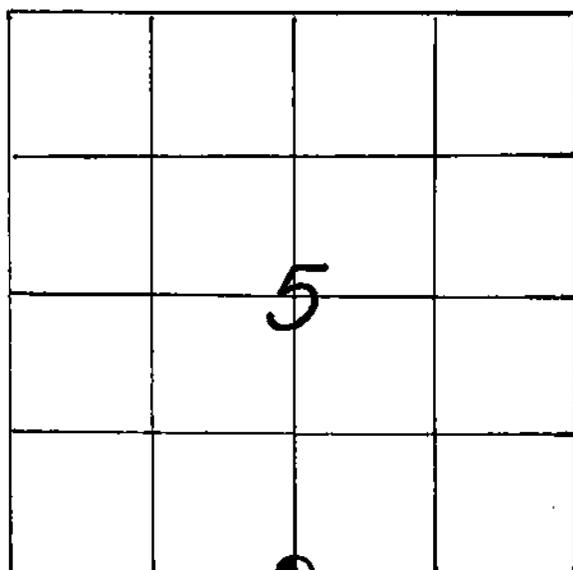

LOCATION OF LANDMARK

WISCONSIN COORDINATE SYSTEM
North
East
Theta Angle
Horiz. Order
Vert. Order
TYPE OF LANDMARK
Brass cap Lunde marker.
BEARINGS ARE REFERENCED TO

Geodetic North

Crew: WILLIAM C. JUNG
 PETER F. FOLLANSBEE
 Date: 10/30/1995

Describe any record evidence, monument evidence, testimonial evidence or any other material evidence you considered and whether the monument was found or restored through acceptance of an obliterated evidence location.

After surveying along the South line of Section 5 and collecting all the available field evidence, I set the corner at a location that best fits the occupied conditions. I monumented the corner with a Lunde marker.


Describe or show any material discrepancy between the location of the restored corner and that of the corner previously restored or reestablished.

This does not fit Solberg's 1/4 corner position of 1960. I could not find any evidence of his old corner. I also do not know how he arrived at that position.

RECORD OF DURABLE WITNESS MONUMENTS


Geodetic

NO	DESCRIPTION	BEARING	DISTANCE
1	"SCAFE" reference marker No. 1 (brass cap in conc.)	N 86° 27' 48" W	194.69 Ft.
2	OUR Ex. P.K. Nail in centerline on line w/fence to S.	N 04° 41' 24" W	146.98 Ft.
3	Set P.K. Nail in W.-side 12" Spruce (unblazed)	North +	4.84 Ft.
4	Set 1" Iron Pipe flush in lawn (Solberg's approx. 1960 location)	Southwesterly+	16.64 Ft.

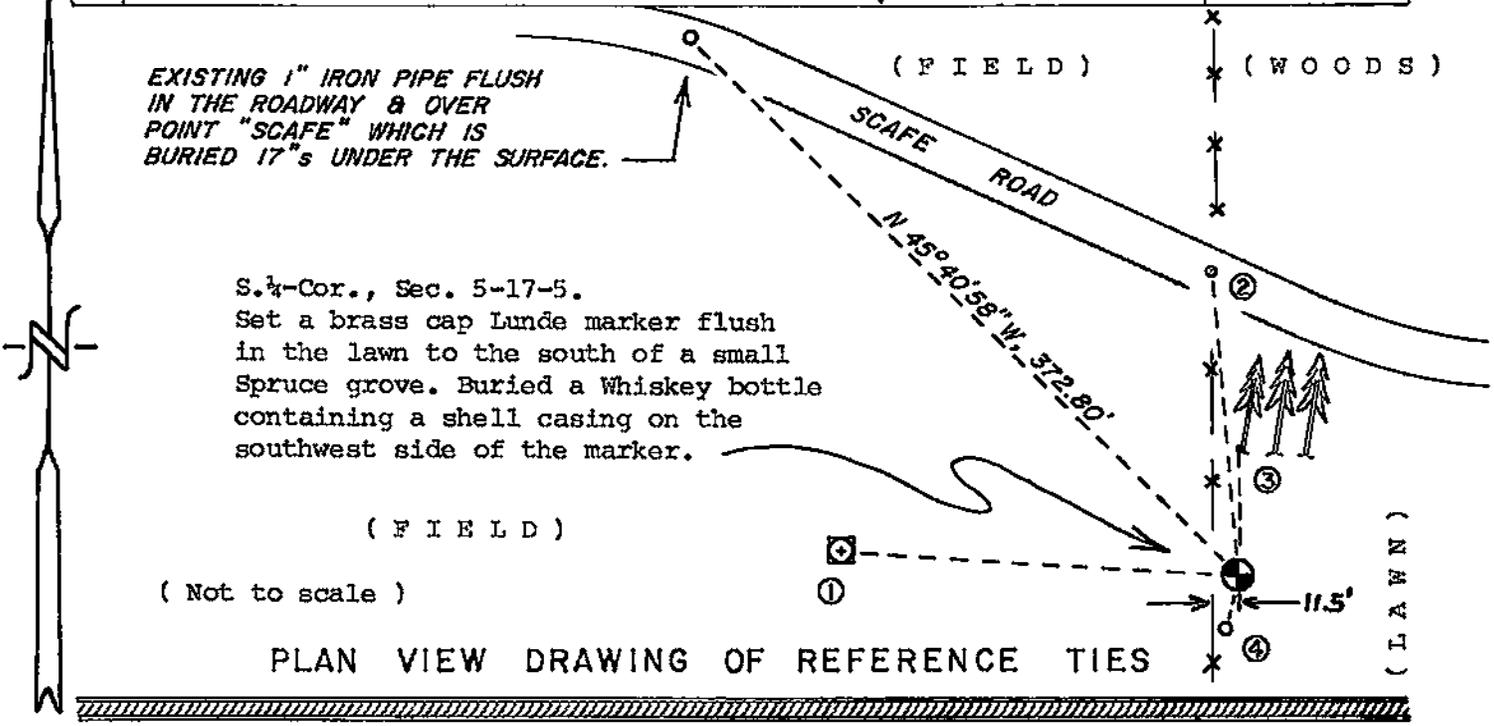


MAP SHOWING DISTANCE AND DIRECTION TO OTHER PUBLIC LAND SURVEY CORNERS USED FOR REESTABLISHING THE CORNER

(Not to scale)

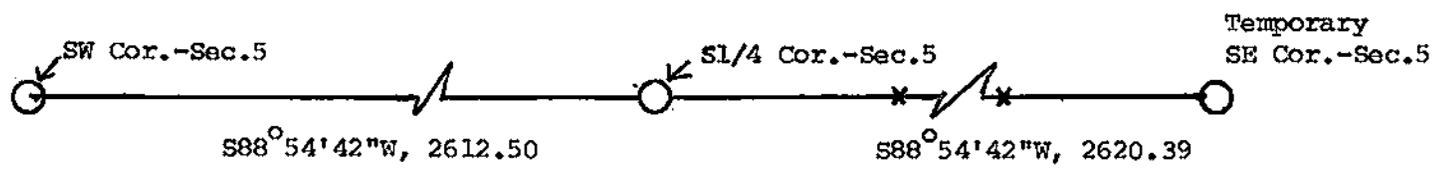

I, William C. Jung, County Surveyor
 HEREBY CERTIFY THAT THE CORNER LOCATION SHOWN ON THIS RECORD WAS DETERMINED BY ME OR UNDER MY DIRECTION AND CONTROL AND THAT THIS U. S. PUBLIC LAND SURVEY MONUMENT RECORD IS CORRECT AND COMPLETE TO THE BEST OF MY KNOWLEDGE AND BELIEF.

William C. Jung 12/12/95
 Signature Date

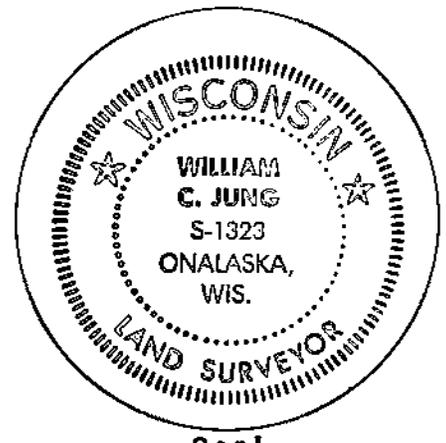

Seal