


21705060020

U. S. PUBLIC LAND SURVEY MONUMENT RECORD

SECTION 7 T 17 N, R 5 W, TOWN OF BURNS

LA CROSSE COUNTY

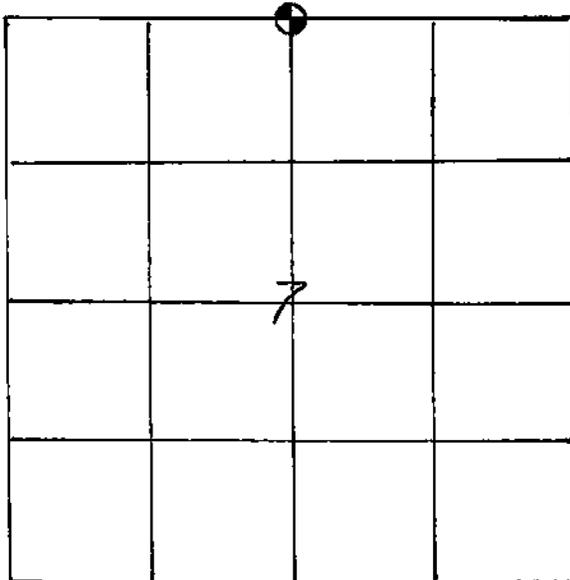

LOCATION OF LANDMARK

DATE: 12-23-86

CREW: BILL JUNG, PERRY DAHL

WISCONSIN COORDINATE SYSTEM

North

East

Theta Angle

Horiz. Order

Vert. Order

TYPE OF LANDMARK

1 1/4" IRON PIPE

BEARINGS ARE REFERENCED TO

True

Describe any record evidence, monument evidence, testimonial evidence or any other material evidence you considered and whether the monument was found or restored through acceptance of an obliterated evidence location.

Greg Hofmeister set an iron pipe at this corner in 1983. I accepted this pipe as the best available evidence of the original government corner position.


Describe or show any material discrepancy between the location of the restored corner and that of the corner previously restored or reestablished.

None known.

RECORD OF DURABLE WITNESS MONUMENTS
MAGNETIC

NO	DESCRIPTION	BEARING	DISTANCE
1	R.R. SPIKE IN DOUBLE-BLAZED 17" ASPEN	N4°W	30.55'
2	P.K. NAIL IN DOUBLE-BLAZED 17" OAK	N38°W	8.28'
3	R.R. SPIKE IN DOUBLE-BLAZED 12" ASPEN	S87°W	46.20'
4	R.R. SPIKE IN UNBLAZED 11" WALNUT	S25°E	11.38'


(the railroad spikes
were existing)

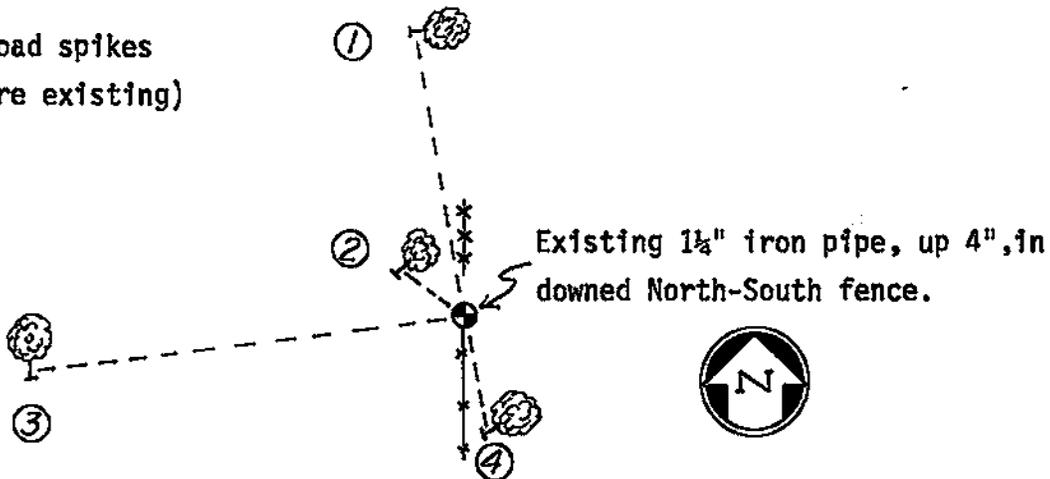

PLAN VIEW DRAWING OF REFERENCE TIES

MAP SHOWING DISTANCE AND DIRECTION TO OTHER PUBLIC LAND SURVEY CORNERS USED FOR REESTABLISHING THE CORNER

(not to scale)

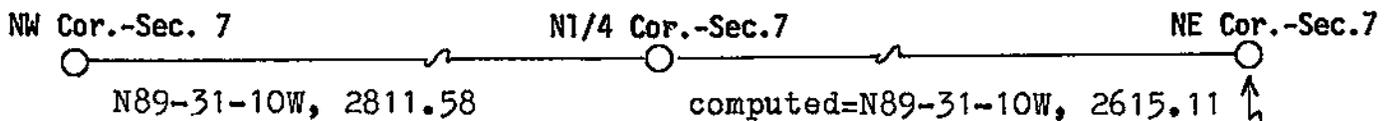

(I did not traverse to this corner at this time.)

I, William C. Jung, Deputy County Surveyor,
HEREBY CERTIFY THAT THE CORNER LOCATION SHOWN ON THIS RECORD
WAS DETERMINED BY ME OR UNDER MY DIRECTION AND CONTROL AND
THAT THIS U. S. PUBLIC LAND SURVEY MONUMENT RECORD IS CORRECT
AND COMPLETE TO THE BEST OF MY KNOWLEDGE AND BELIEF.

William C. Jung
Signature

December 31, 1986
Date



Seal