
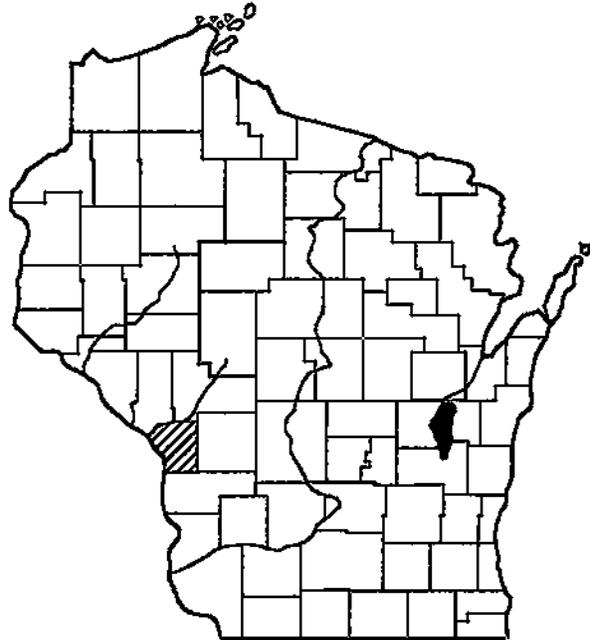


21705062000

U. S. PUBLIC LAND SURVEY MONUMENT RECORD

**SECTION 6, TOWN 17 NORTH, RANGE 5 WEST
TOWN OF BURNS, LA CROSSE COUNTY**

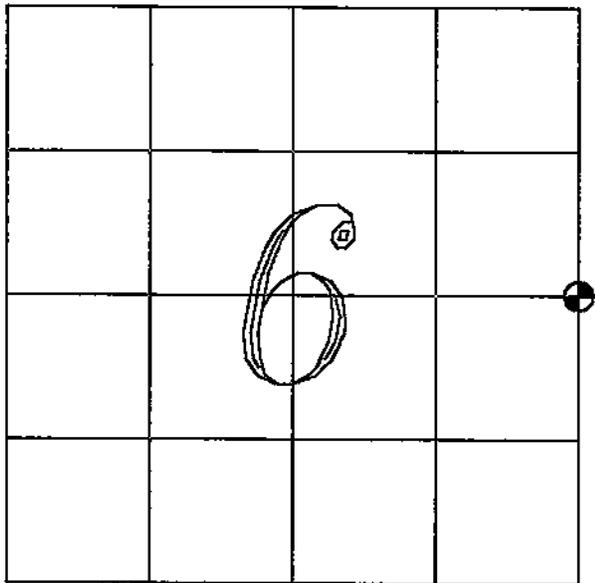

LANDMARK: SET 3/4" X 30" IRON BAR
(1.5 LB/LN FOOT)

WITNESS TO CORNER LOCATION:


- Michael Harding*
- Christopher W. Fechner*
- Kevin P. Kadrmas*
- Randy Corlis*

Describe any record evidence, monument evidence, testimonial evidence, or any other material evidence you considered and whether the monument was found or restored through acceptance of an obliterated evidence location.

Set bar at fence intersection

Describe or show any material discrepancy between the location of the restored corner and that of the corner previously restored or reestablished.

None

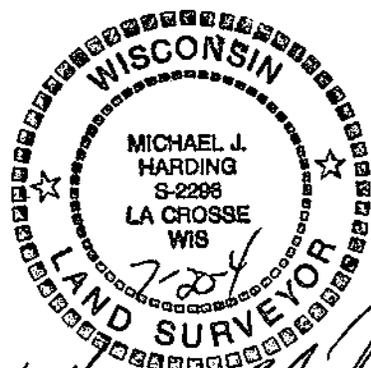


Michael J. Harding

RECORD OF DURABLE WITNESS MONUMENTS

NO	DESCRIPTION	BEARING	DISTANCE
1	SET 3/4" X 30" IRON BAR	N 62°32'57" W	87.24'
2	SET 3/4" X 30" IRON BAR	N 02°36'42" W	201.90'
3	SET 3/4" X 30" IRON BAR	S 78°03'56" E	31.50'
4	SET 3/4" X 30" IRON BAR	S 42°25'01" E	35.96'

BEARINGS ARE BASED ON SURVEY PROJECT S-4181

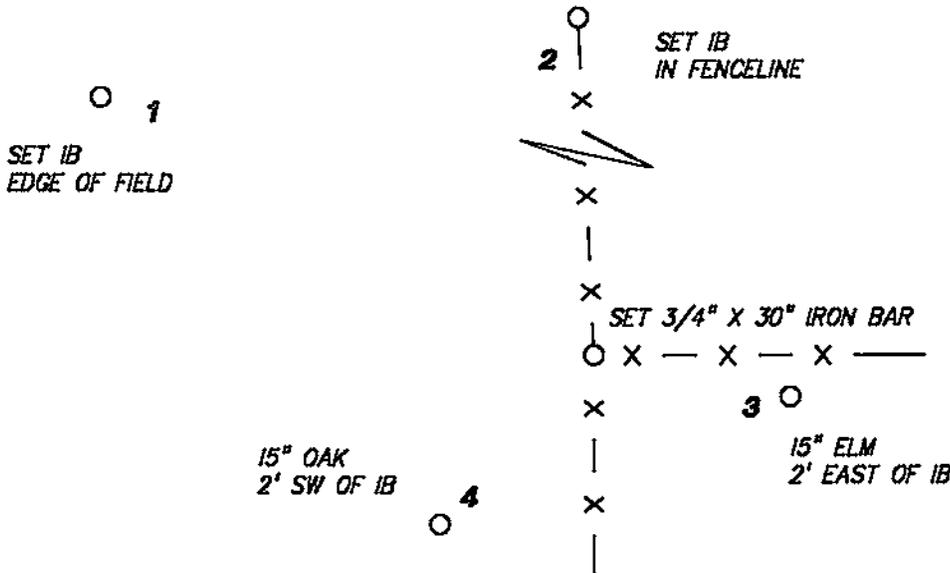

SCALE 1" = 30'

PLAN VIEW DRAWING OF REFERENCE TIES

MAP SHOWING DISTANCE AND DIRECTION TO OTHER PUBLIC LAND SURVEY CORNERS USED FOR REESTABLISHING THE CORNER



I, MICHAEL J. HARDING, RLS#2296
 HEREBY CERTIFY THAT THE CORNER LOCATION SHOWN ON THIS RECORD
 WAS DETERMINED BY ME OR UNDER MY DIRECTION AND CONTROL AND
 THAT THIS U. S. PUBLIC LAND SURVEY MONUMENT RECORD IS CORRECT
 AND COMPLETE TO THE BEST OF MY KNOWLEDGE AND BELIEF.

Michael J. Harding

 Signature

7-20-4

 Date