


21705070000

U. S. PUBLIC LAND SURVEY MONUMENT RECORD

SECTION 7 T 17 N, R 5 W, TOWN OF Burns

LA CROSSE COUNTY

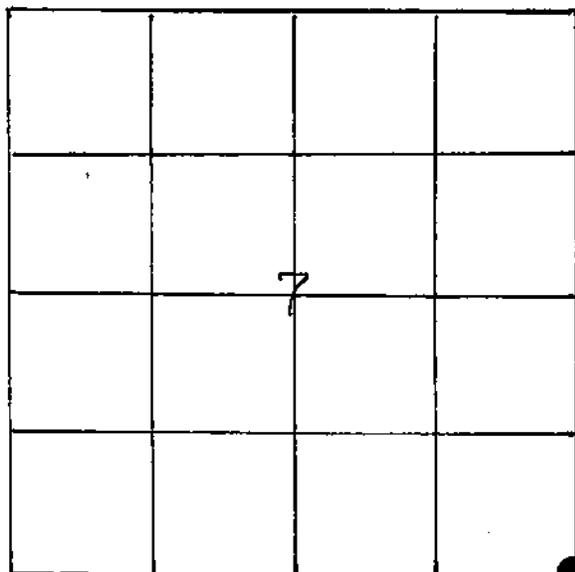

LOCATION OF LANDMARK

WISCONSIN COORDINATE SYSTEM	
North	714,826.1999
East	1,702,152.7414
Theta Angle	
Horiz. Order	
Vert. Order	
Datum:	1983(+91)

TYPE OF LANDMARK Berntsen top in an Iron pipe over an iron pipe.

Bearings are referenced to True North as per Hofmeister's survey in 1983.

Crew: William C. Jung
Perry Dahl

Crew: William C. Jung
Pete Follansbee

12-23-86 Describe any record evidence, monument evidence, testimonial evidence or any other material evidence you considered and whether the monument was found or restored through acceptance of an obliterated evidence location. 11-20-03

I accepted the old occupied fence corner as the best available evidence of the original government corner and monumented it with an iron pipe.


Note: I also chained West and searched for the old government line tree but found no sign of it. Stanley Schlitz says that his father said that around 1920 a surveyor established the corner location at the fence corner location.

Describe or show any material discrepancy between the location of the restored corner and that of the corner previously restored or reestablished.

None known.

**RECORD OF DURABLE WITNESS MONUMENTS
MAGNETIC**


NO	DESCRIPTION	BEARING	DISTANCE
1	P.K.nail in double blazed 7" aspen	N36°W	19.80'
2	P.K.nail in double blazed 19" oak	N33°E	60.73'
3	P.K.nail in double blazed 7"double cherry	S43°E	11.06'
4	P.K.nail in double blazed 20" aspen	S 8°E	27.10'

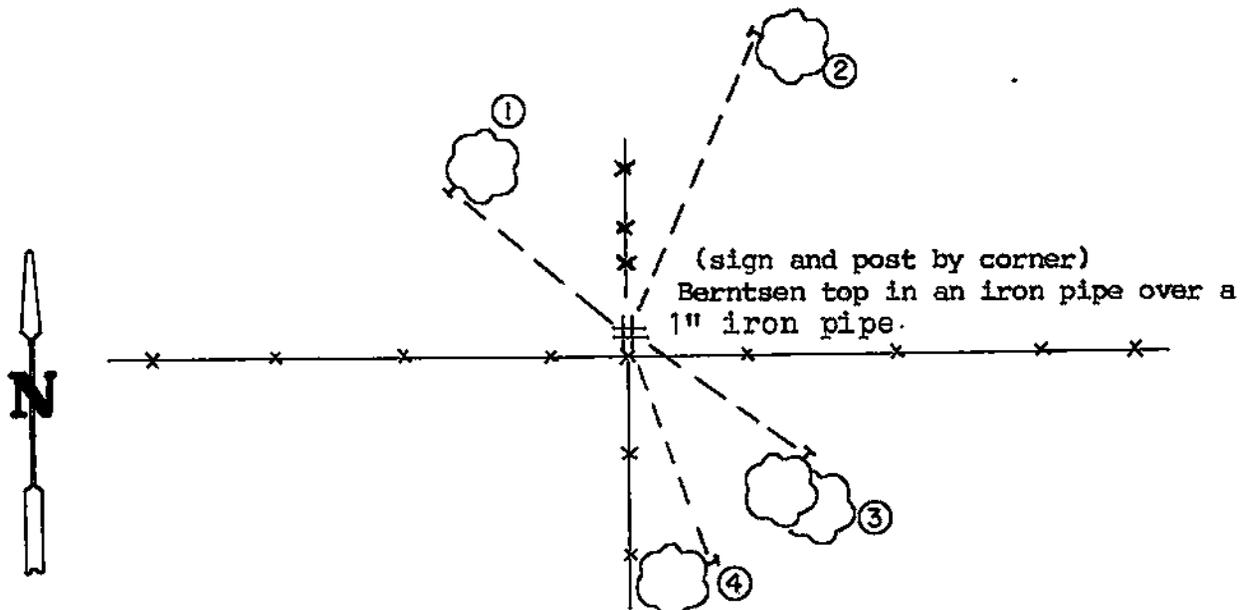

PLAN VIEW DRAWING OF REFERENCE TIES

MAP SHOWING DISTANCE AND DIRECTION TO OTHER PUBLIC LAND SURVEY CORNERS USED FOR REESTABLISHING THE CORNER

(not to scale)

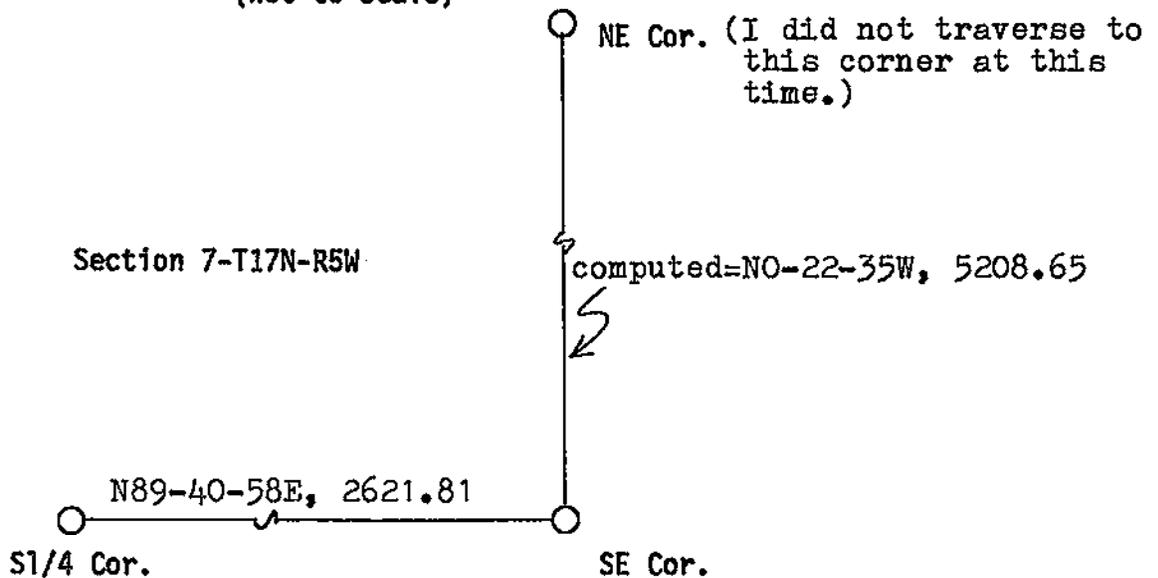

I, William C. Jung, Deputy County Surveyor,
HEREBY CERTIFY THAT THE CORNER LOCATION SHOWN ON THIS RECORD
WAS DETERMINED BY ME OR UNDER MY DIRECTION AND CONTROL AND
THAT THIS U. S. PUBLIC LAND SURVEY MONUMENT RECORD IS CORRECT
AND COMPLETE TO THE BEST OF MY KNOWLEDGE AND BELIEF.

William C. Jung
Signature

December 31, 1986
Date

Revised: December 31, 2003
wcj

