


21705070020

U. S. PUBLIC LAND SURVEY MONUMENT RECORD

SECTION 7 T 17 N, R 5 W, TOWN OF BURNS

LA CROSSE COUNTY

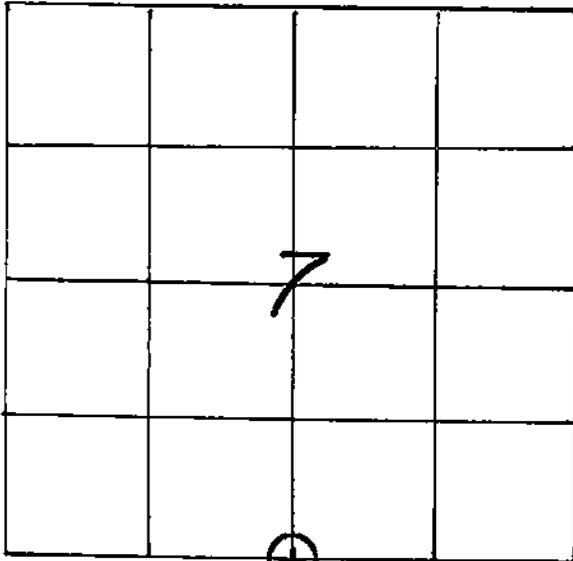

LOCATION OF LANDMARK

CREW: WILLIAM C. JUNG
 PETER F. FOLLANSBEE
 DATE: 8/16/2005

WISCONSIN COORDINATE SYSTEM

North 714,843.841

East 1,699,531.157

Theta Angle

Horiz. Order

Vert. Order

DATUM: 1983('91)

TYPE OF LANDMARK

3/4" x 30" IRON BAR WITH AN ALUMINUM CAP.

BEARINGS ARE REFERENCED TO

TRUE NORTH AS PER SECTION DATA.

Describe any record evidence, monument evidence, testimonial evidence or any other material evidence you considered and whether the monument was found or restored through acceptance of an obliterated evidence location.


I set a Lunde marker at this corner in 1987. Apparently it was destroyed recently by loggers. (In fairness I don't think that they knew that the Lunde was there.) My old ties were for all practical purposes also gone. By use of GPS and total station ground traverse, I computed out the location of my old corner and monumented it again, this time with an iron bar and cap.

Describe or show any material discrepancy between the location of the restored corner and that of the corner previously restored or reestablished.

NONE KNOWN.


RECORD OF DURABLE WITNESS MONUMENTS

NO	DESCRIPTION	MAGNETIC BEARING	DISTANCE
1	SET A 3/4" x 30" IRON BAR WITH A RED PLASTIC CAP	N 40° E	55.14 FT.
2	SET A 3/4" x 30" IRON BAR WITH A RED PLASTIC CAP	S 82° E	15.70 FT.
3	SET A 3/4" x 30" IRON BAR WITH A RED PLASTIC CAP	S 04° E	57.08 FT.
4	SET A 3/4" x 30" IRON BAR WITH A RED PLASTIC CAP	S 27° W	28.41 FT.

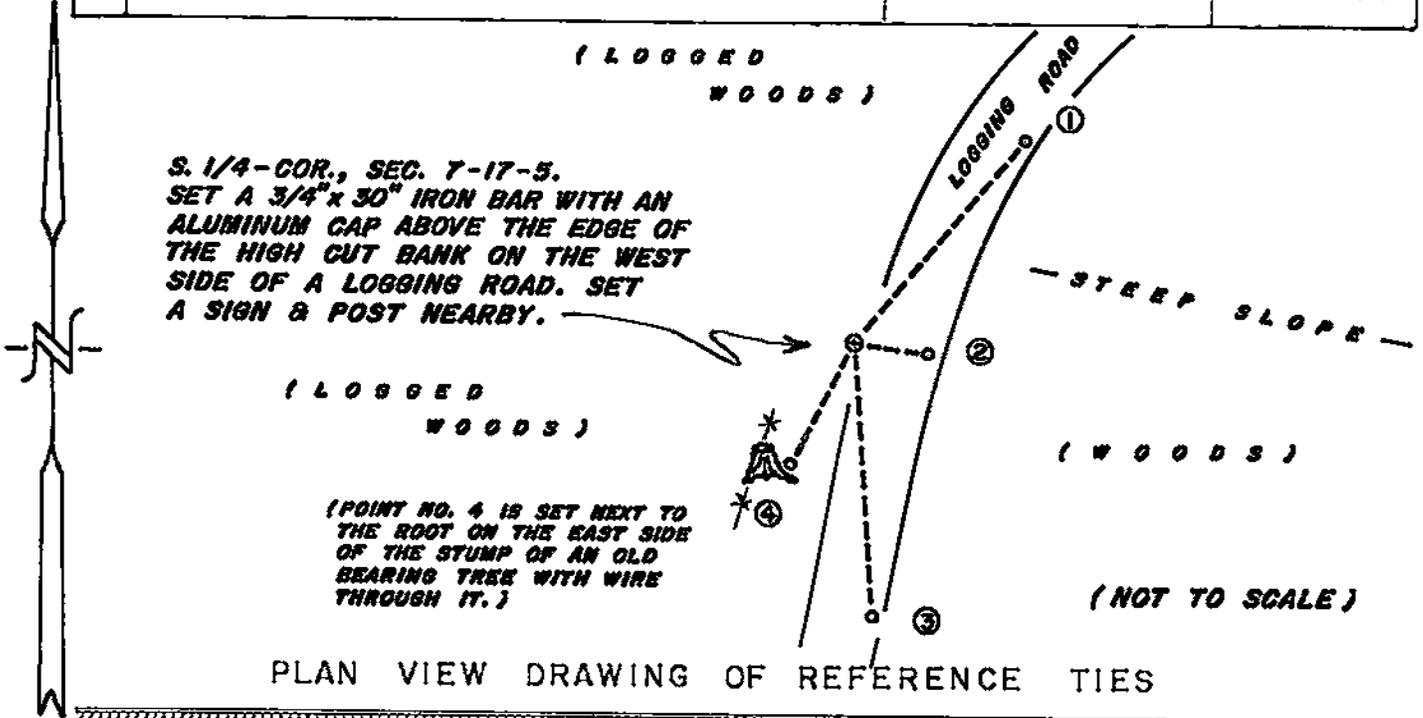


MAP SHOWING DISTANCE AND DIRECTION TO OTHER PUBLIC LAND SURVEY CORNERS USED FOR REESTABLISHING THE CORNER

(NOT TO SCALE)

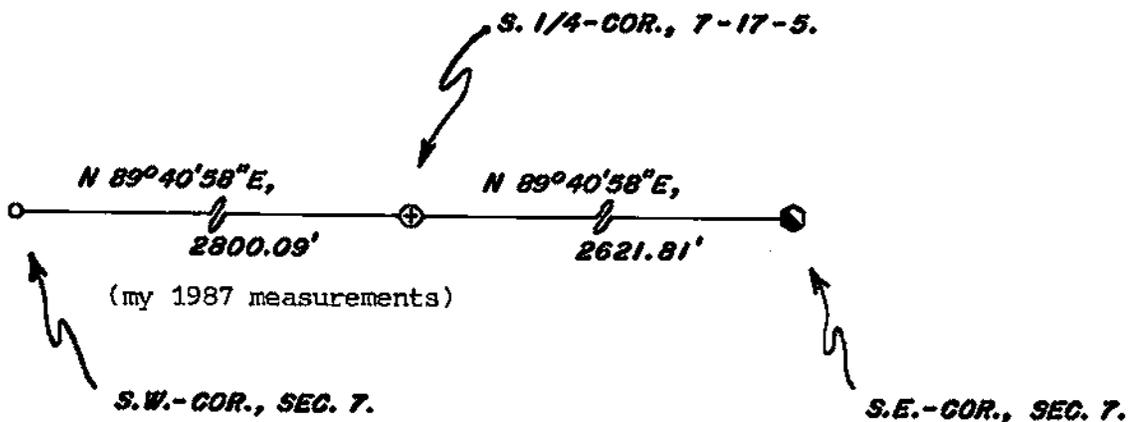

I, WILLIAM C. JUNG, COUNTY SURVEYOR
HEREBY CERTIFY THAT THE CORNER LOCATION SHOWN ON THIS RECORD WAS DETERMINED BY ME OR UNDER MY DIRECTION AND CONTROL AND THAT THIS U. S. PUBLIC LAND SURVEY MONUMENT RECORD IS CORRECT AND COMPLETE TO THE BEST OF MY KNOWLEDGE AND BELIEF.

William C. Jung 9/9/05
Signature Date

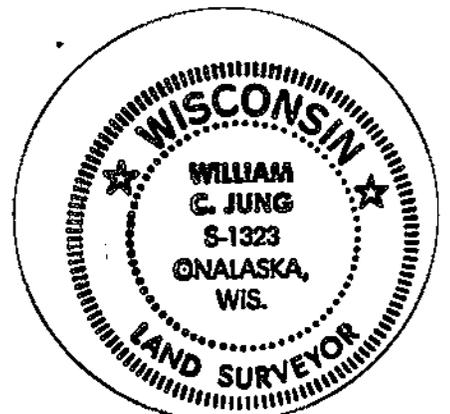


Seal

U. S. PUBLIC LAND SURVEY MONUMENT RECORD

SECTION 7 T 17 N, R 5 W, TOWN OF Burns

LA CROSSE COUNTY

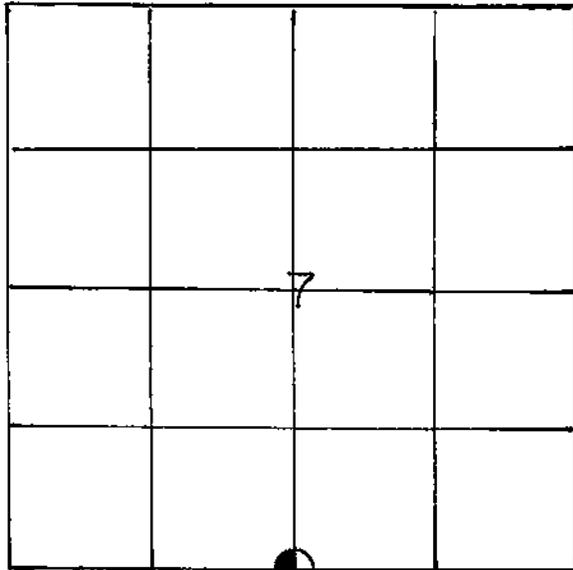

LOCATION OF LANDMARK

Crew: William C. Jung
 Perry L. Dahl
 2-5-87

WISCONSIN COORDINATE SYSTEM

North
 East
 Theta Angle
 Horiz. Order
 Vert. Order

TYPE OF LANDMARK
 Brass capped Lunde marker

BEARINGS ARE REFERENCED TO
 Bearings are referenced to True North as per Hofmeister's survey in 1983.

Describe any record evidence, monument evidence, testimonial evidence or any other material evidence you considered and whether the monument was found or restored through acceptance of an obliterated evidence location.

I set this lost corner by single proportionate measurement.


Describe or show any material discrepancy between the location of the restored corner and that of the corner previously restored or reestablished.

None known.

VOID
weg

RECORD OF DURABLE WITNESS MONUMENTS
MAGNETIC


NO	DESCRIPTION	BEARING	DISTANCE
1	P.K.nail in double blazed oak tree, 20"	S69°E	slope=21.86'
2	" , 14"	S26°E	slope=40.84'
3	" , 18"	S 9°W	49.97'
4	" , 18"	S36°W	29.77'

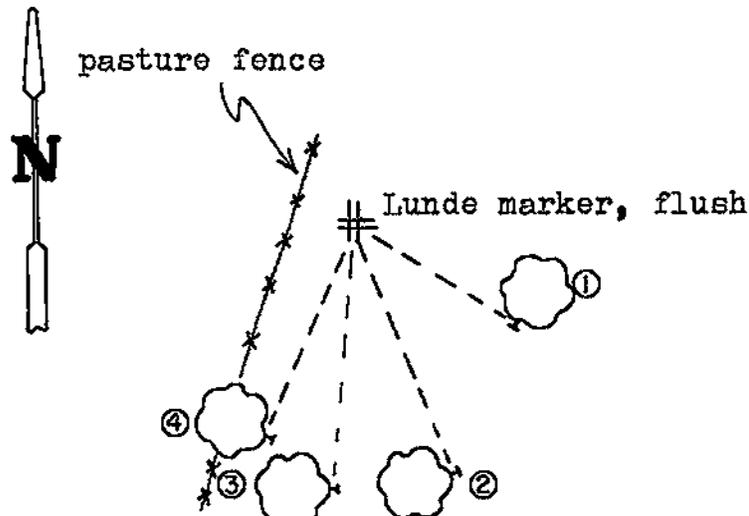

PLAN VIEW DRAWING OF REFERENCE TIES

MAP SHOWING DISTANCE AND DIRECTION TO OTHER PUBLIC LAND SURVEY CORNERS USED FOR REESTABLISHING THE CORNER

(not to scale)

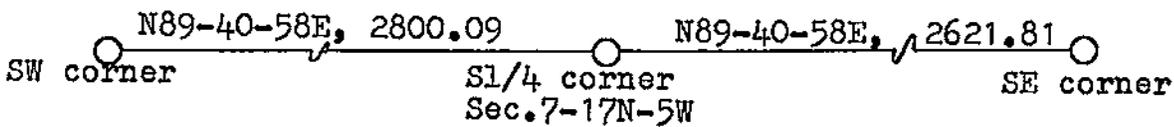

VOID
wlj

I, William C. Jung, Deputy County Surveyor,
HEREBY CERTIFY THAT THE CORNER LOCATION SHOWN ON THIS RECORD
WAS DETERMINED BY ME OR UNDER MY DIRECTION AND CONTROL AND
THAT THIS U. S. PUBLIC LAND SURVEY MONUMENT RECORD IS CORRECT
AND COMPLETE TO THE BEST OF MY KNOWLEDGE AND BELIEF.

William C. Jung
Signature

February 9, 1987
Date



Seal