


## U. S. PUBLIC LAND SURVEY MONUMENT RECORD

SECTION 7 T 17 N, R 5 W, TOWN OF Burns

## LA CROSSE COUNTY

Section 7

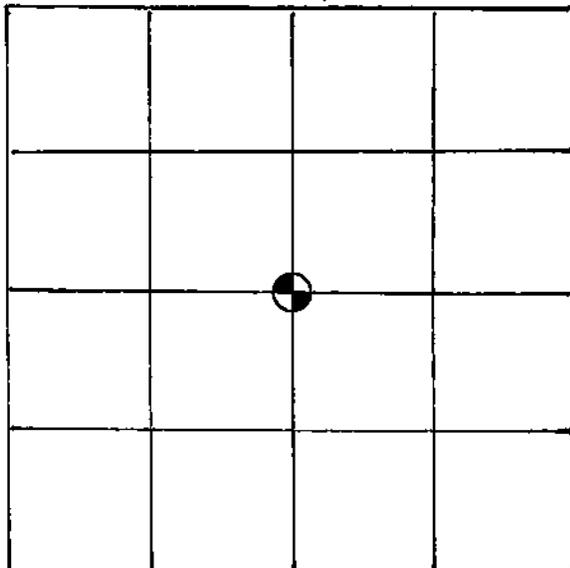

LOCATION OF LANDMARK

Crew: William C. Jung  
Perry L. Dahl  
2-5-87

Crew: William C. Jung  
Peter F. Follansbee  
5-3-95

## WISCONSIN COORDINATE SYSTEM

North

East

Theta Angle

Horiz. Order

Vert. Order

## TYPE OF LANDMARK

Brass capped Lunde marker

## BEARINGS ARE REFERENCED TO

Bearings are referenced to True North as per Hofmeister's survey in 1983.

Describe any record evidence, monument evidence, testimonial evidence or any other material evidence you considered and whether the monument was found or restored through acceptance of an obliterated evidence location.


I set the corner as "per law" at the intersection of the 1/4 lines.

Describe or show any material discrepancy between the location of the restored corner and that of the corner previously restored or reestablished.

The corner as set does not agree with the occupied fence corner.

**RECORD OF DURABLE WITNESS MONUMENTS**  
MAGNETIC


NO	DESCRIPTION	BEARING	DISTANCE
1	P.K.nail in double blazed 11" aspen	N42°W	slope=62.9'
2	" 7" birch	N23°E	16.97'
3	" 22" oak	S45°E	29.25'
4	" 13" oak	S29°E	36.17'

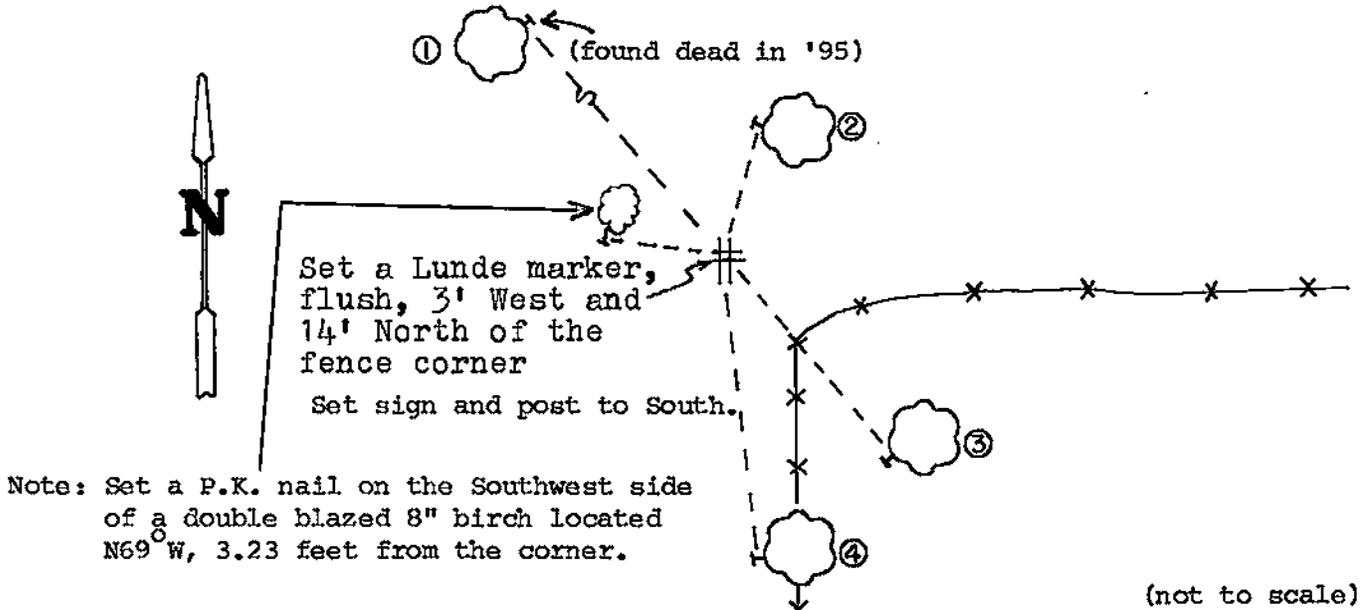

PLAN VIEW DRAWING OF REFERENCE TIES

**MAP SHOWING DISTANCE AND DIRECTION TO OTHER PUBLIC LAND SURVEY CORNERS USED FOR REESTABLISHING THE CORNER**

(not to scale)

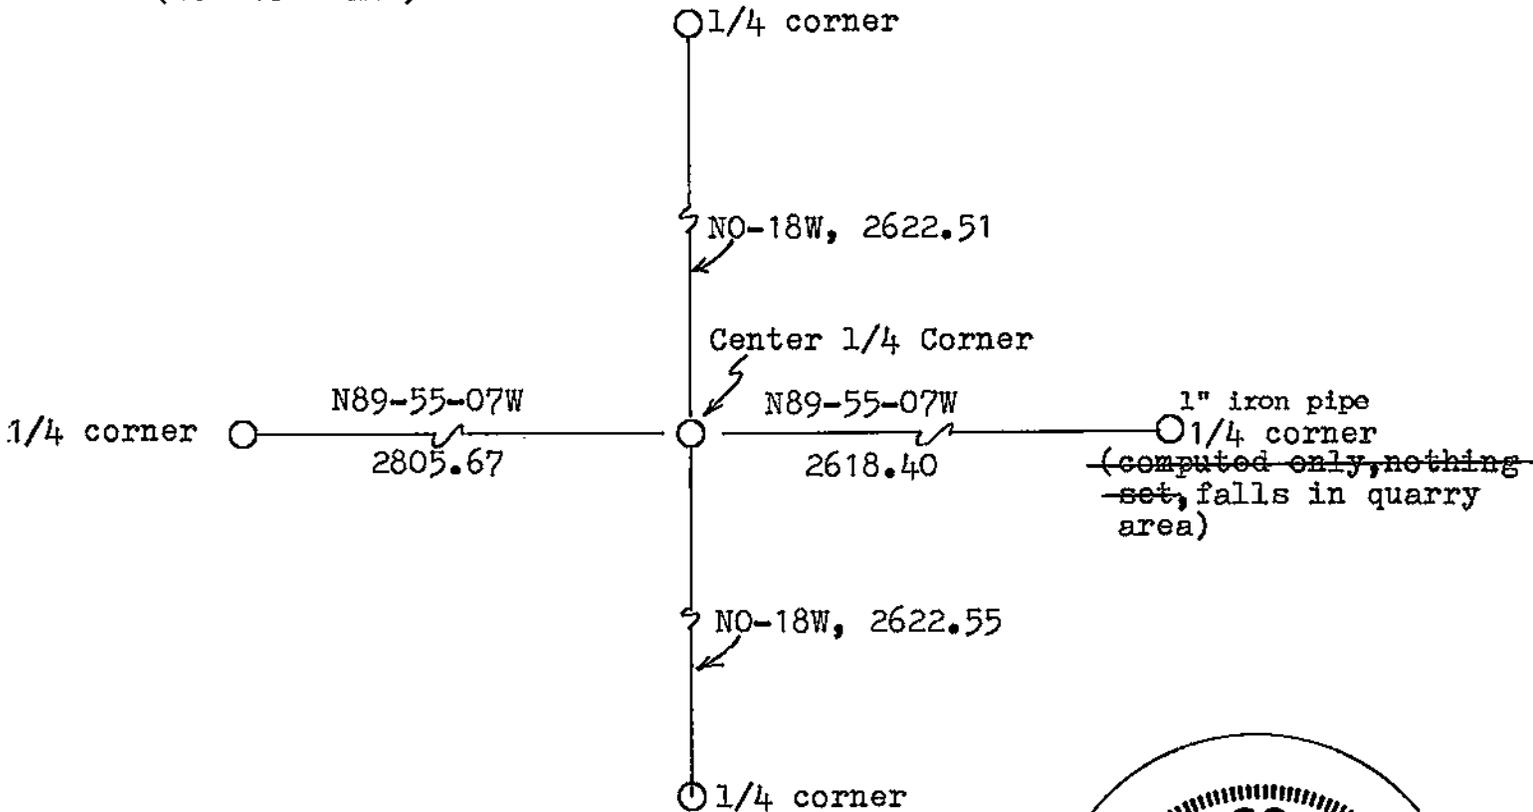


I, William C. Jung, Deputy County Surveyor,  
HEREBY CERTIFY THAT THE CORNER LOCATION SHOWN ON THIS RECORD  
WAS DETERMINED BY ME OR UNDER MY DIRECTION AND CONTROL AND  
THAT THIS U. S. PUBLIC LAND SURVEY MONUMENT RECORD IS CORRECT  
AND COMPLETE TO THE BEST OF MY KNOWLEDGE AND BELIEF.

William C. Jung  
Signature

February 9, 1987  
Date

Revised: 2/2/96 *wcj*

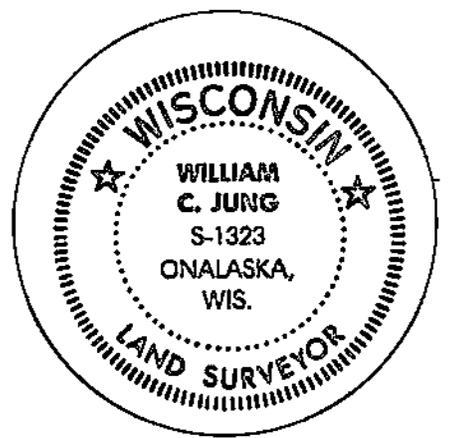

Seal