


U. S. PUBLIC LAND SURVEY MONUMENT RECORD

SECTION 9 T 17 N, R 5 W, TOWN OF BURNS
LACROSSE COUNTY

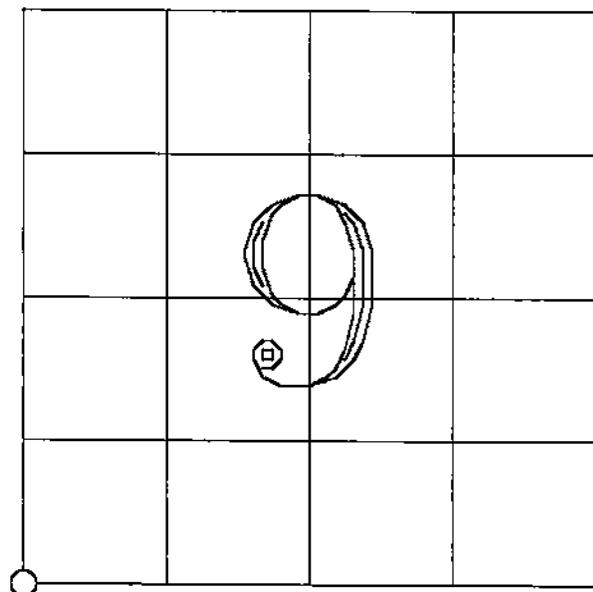

LOCATION OF LANDMARK

LACROSSE CO. COORDINATE SYSTEM

North 184606.415

East 513644.882

Theta Angle

Horiz. Order

Vert. Order

TYPE OF LANDMARK

3/4" X 30" IRON BAR

BEARINGS ARE REFERENCED TO
 LACROSSE COUNTY
 COORDINATE SYSTEM

CREW: CHRIS FECHNER
 JOSH NAVE
 TRENT ROBBINS

WITNESS: PHILLIP FARRINGTON

DATE: 2/8/01

Describe any record evidence, monument evidence, testimonial evidence, or any other material evidence you considered and whether the monument was found or restored through acceptance of an obliterated evidence location.

WE TRAVERSED ONE MILE NORTH, SOUTH AND EAST OF THIS LOCATION. THE RECORD DISTANCES FROM GOVERNMENT NOTES MATCHED OUR TRAVERSE DIMENSIONS VERY WELL. THE CURRENT LAND OWNER, PHILLIP FARRINGTON, ACCOMPANIED US INTO THE CORNER LOCATION. WE FOUND EXCELLENT EVIDENCE FROM OCCUPATION DATING BACK TO THE 1950'S. MR. FARRINGTON STATED THAT THE "OLD FENCE CORNER" WAS IN THE IMMEDIATE AREA OF OUR CALCULATED POSITION. WE MONUMENTED THE CORNER WITH A 3/4" X 30" IRON BAR

Describe or show any material discrepancy between the location of the restored corner and that of the corner previously restored or reestablished.

NONE

William C. Jung, County Surveyor
LA CROSSE COUNTY, WISCONSIN

Administrative Center • Room 104
400 4th Street North • La Crosse, Wisconsin 54601-3200



(608) 785-9722

To Whom It May Concern:

This is to certify that on November 13, 2003, I was at the Northeast corner of Section 17-17-5, and that I placed a Berntsen cap over the existing iron bar at the corner, that I set a sign and post by the corner, and that I double blazed the oak bearing trees.



William C. Jung
La Crosse County Surveyor
1/6/04