


21705080020

U. S. PUBLIC LAND SURVEY MONUMENT RECORD

SECTION 17 T 17 N, R 5 W, TOWN OF BURNS

LA CROSSE COUNTY

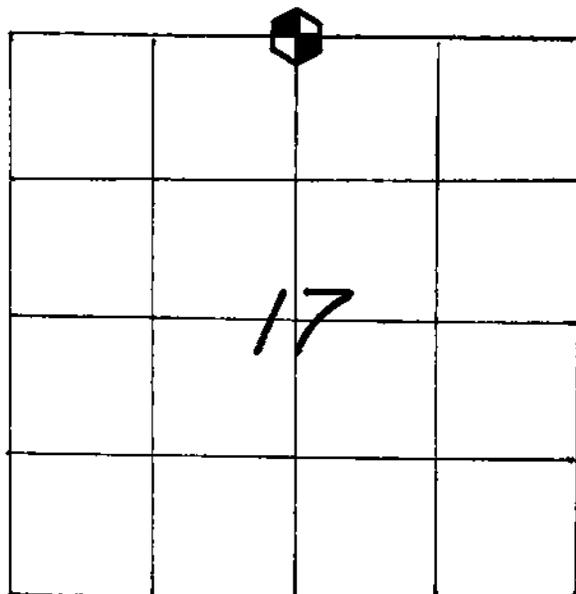

WISCONSIN COORDINATE SYSTEM

North 714,843.0284East 1,704,792.1494

Theta Angle

Horiz. Order

Vert. Order

DATUM: 1983('91)

TYPE OF LANDMARK

BRASS CAP LUNDE MARKER.

BEARINGS ARE REFERENCED TO

GRID NORTH AS PER SECTION DATA.

LOCATION OF LANDMARK

CREW: **WILLIAM C. JUNG****PETER F. FOLLANSBEE**DATE: **12/15/2003**

Describe any record evidence, monument evidence, testimonial evidence or any other material evidence you considered and whether the monument was found or restored through acceptance of an obliterated evidence location.


After searching at length for evidence of the original government survey and finding none, I set the corner "by law" at the single proportionate position and monumented it with a brass capped Lunde marker.

Describe or show any material discrepancy between the location of the restored corner and that of the corner previously restored or reestablished.

NONE KNOWN.


RECORD OF DURABLE WITNESS MONUMENTS

NO	DESCRIPTION	MAGNETIC	
		BEARING	DISTANCE
1	SET A NAIL IN S.E.-SIDE OF A 7-1/2" HICKORY	S 43° W	SLOPE= 22.58
2	SET A NAIL IN N.- SIDE OF A 5" HICKORY	N 77° W	SLOPE= 30.42
3	SET A NAIL IN S.W.-SIDE OF A 5-1/2" HICKORY	N 43° W	SLOPE= 20.84
4	SET A NAIL IN N.W.-SIDE OF A 5" HICKORY	N 30° E	SLOPE= 18.98

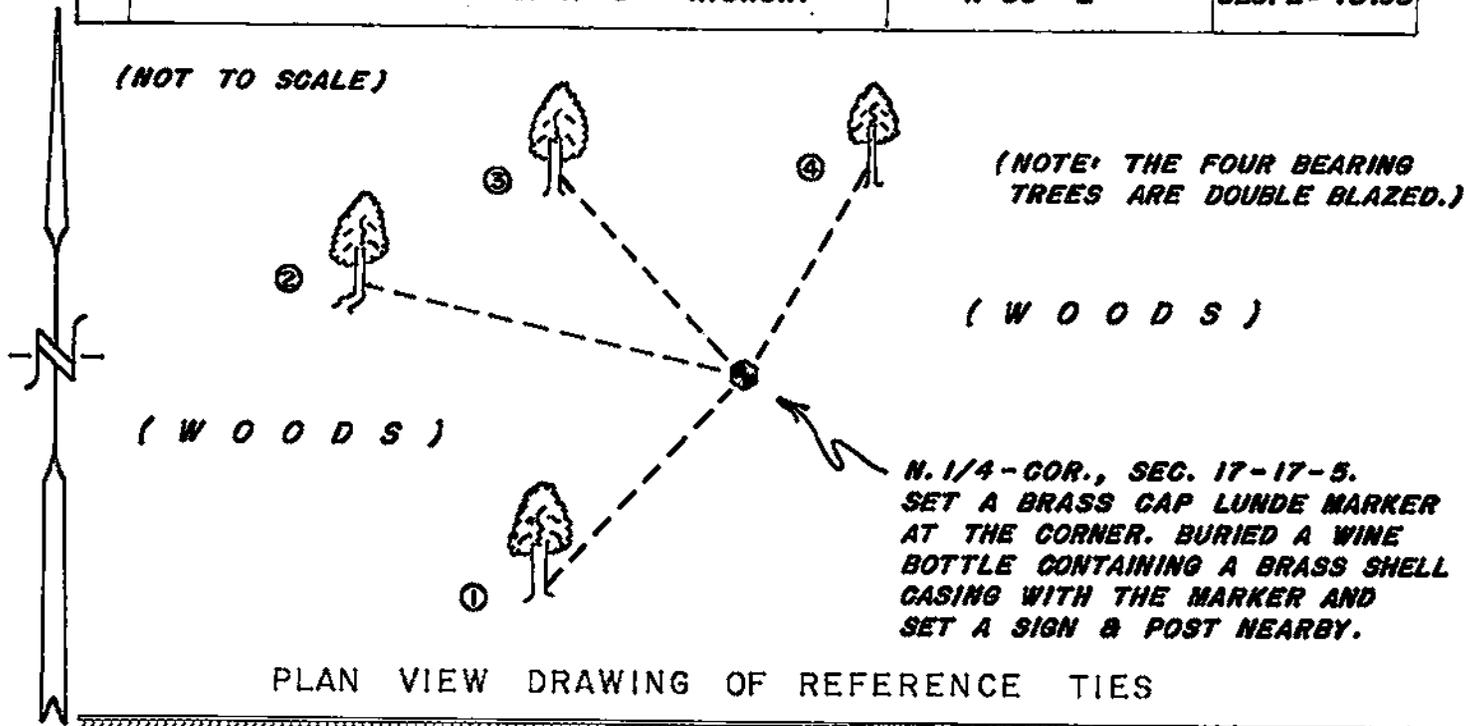

MAP SHOWING DISTANCE AND DIRECTION TO OTHER PUBLIC LAND SURVEY CORNERS USED FOR REESTABLISHING THE CORNER

(GRID BEARINGS & DISTANCES)
(GRID FACTOR: 0.999937)
(NOT TO SCALE)

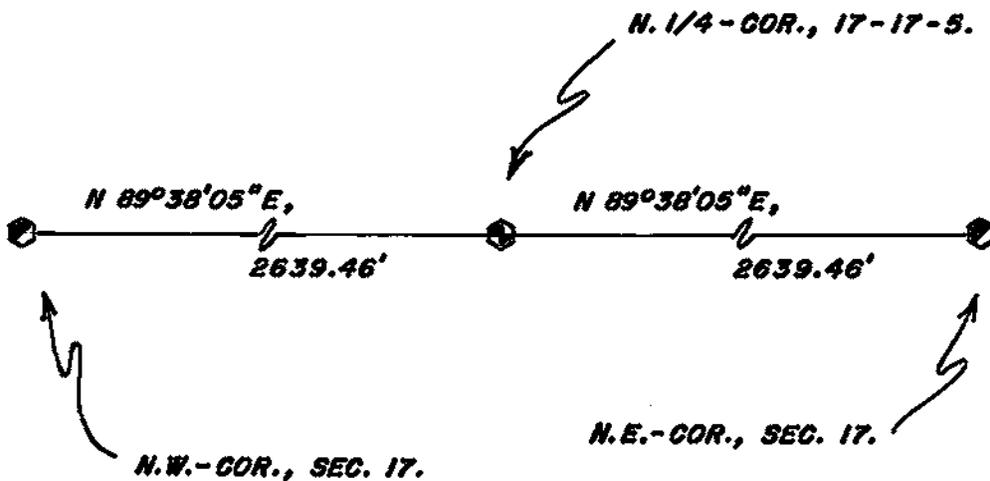

I, WILLIAM C. JUNG, COUNTY SURVEYOR
HEREBY CERTIFY THAT THE CORNER LOCATION SHOWN ON THIS RECORD WAS DETERMINED BY ME OR UNDER MY DIRECTION AND CONTROL AND THAT THIS U. S. PUBLIC LAND SURVEY MONUMENT RECORD IS CORRECT AND COMPLETE TO THE BEST OF MY KNOWLEDGE AND BELIEF.

William C. Jung 1/6/04
Signature Date



Seal