


21705090000

U. S. PUBLIC LAND SURVEY MONUMENT RECORD

SECTION 16 T 17 N, R 5 W, TOWN OF BURNS

LA CROSSE COUNTY

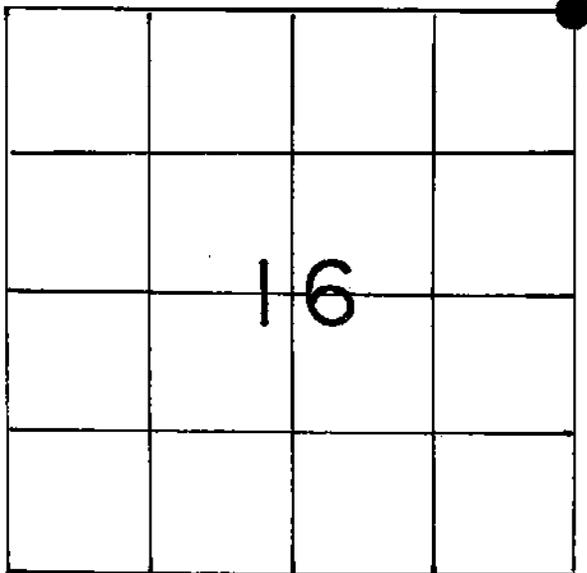

LOCATION OF LANDMARK

Crew: William C. Jung
Peter Follansbee

Date: 2/28/90

WISCONSIN COORDINATE SYSTEM

North

East

Theta Angle

Horiz. Order

Vert. Order

TYPE OF LANDMARK

~~1" x 30" iron pipe~~ Lunde marker

BEARINGS ARE REFERENCED TO

True

Crew: Peter Follansbee
Daniel Leis

Date: 6/27/90

Describe any record evidence, monument evidence, testimonial evidence or any other material evidence you considered and whether the monument was found or restored through acceptance of an obliterated evidence location.

I accepted the occupied fence corner as the best available evidence of the original government corner position and monumented it with an iron pipe.


The iron pipe was replaced by a Lunde on 6/27/90.

Describe or show any material discrepancy between the location of the restored corner and that of the corner previously restored or reestablished.

None known.

RECORD OF DURABLE WITNESS MONUMENTS

NO	DESCRIPTION	BEARING	DISTANCE
1	P.K. nail in single blazed 7" hickory	North \pm	36.05
2	Set 1"x30" iron pipe	"	11.30
3	"	East \pm	16.04
4	P.K. in single blazed triple box elder	-----	44.81

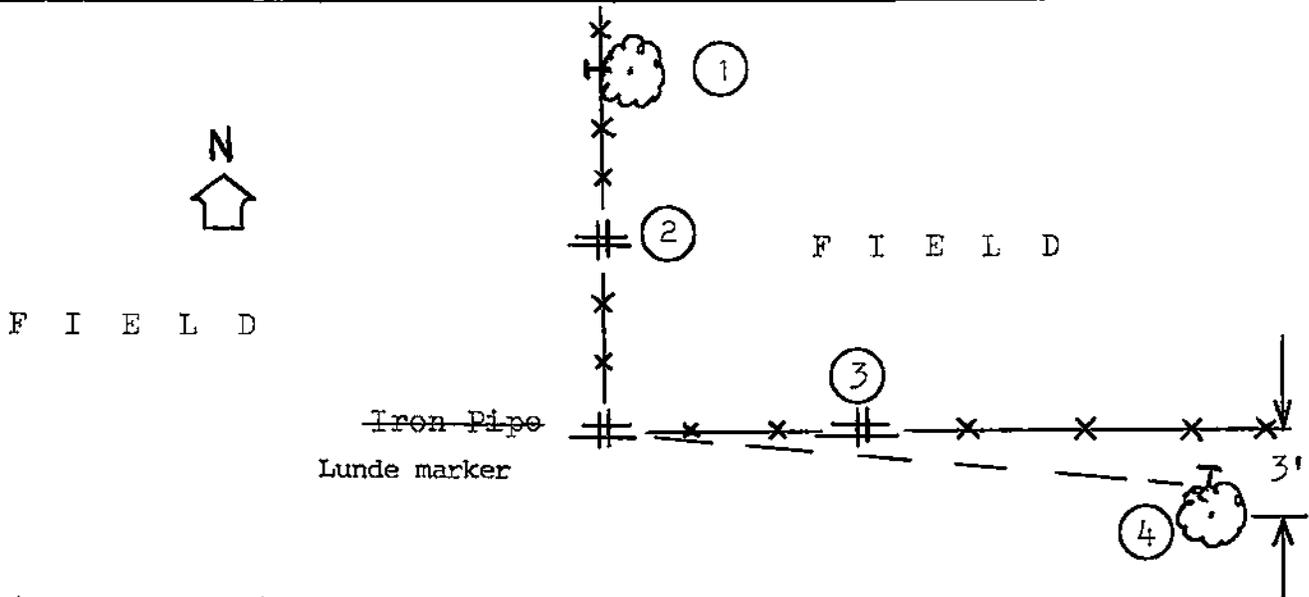


(not to scale)

F I E L D

PLAN VIEW DRAWING OF REFERENCE TIES

MAP SHOWING DISTANCE AND DIRECTION TO OTHER PUBLIC LAND SURVEY CORNERS USED FOR REESTABLISHING THE CORNER

(not to scale)

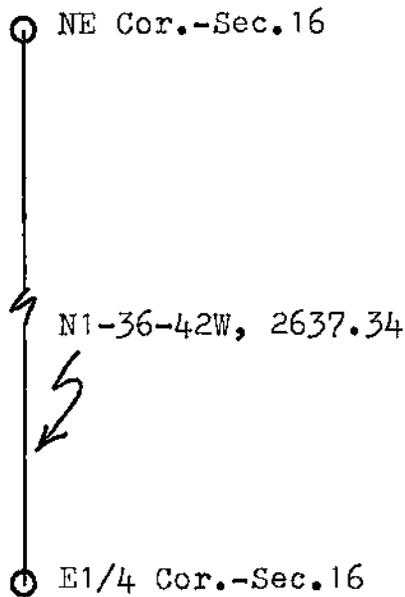


I, William C. Jung, Deputy County Surveyor,
 HEREBY CERTIFY THAT THE CORNER LOCATION SHOWN ON THIS RECORD
 WAS DETERMINED BY ME OR UNDER MY DIRECTION AND CONTROL AND
 THAT THIS U. S. PUBLIC LAND SURVEY MONUMENT RECORD IS CORRECT
 AND COMPLETE TO THE BEST OF MY KNOWLEDGE AND BELIEF.

William C. Jung
 Signature

March 6, 1990
 Date

Revised: February 13, 1991

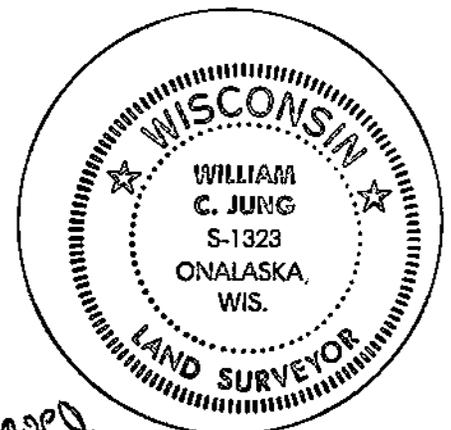

Seal

wcj